



Plat of survey of Lot 16 add. E To Country Club Estates, Village of Fontana, Walworth County Wisconsin June Lloyd L. Jensen 1959 County Surveyor




Plat of Survey of Lot 118, Unit 2 Country Club Estates Village of Fontana, Walworth County Wisconsin June 1959 Lloyd L. Jensen County Surveyor

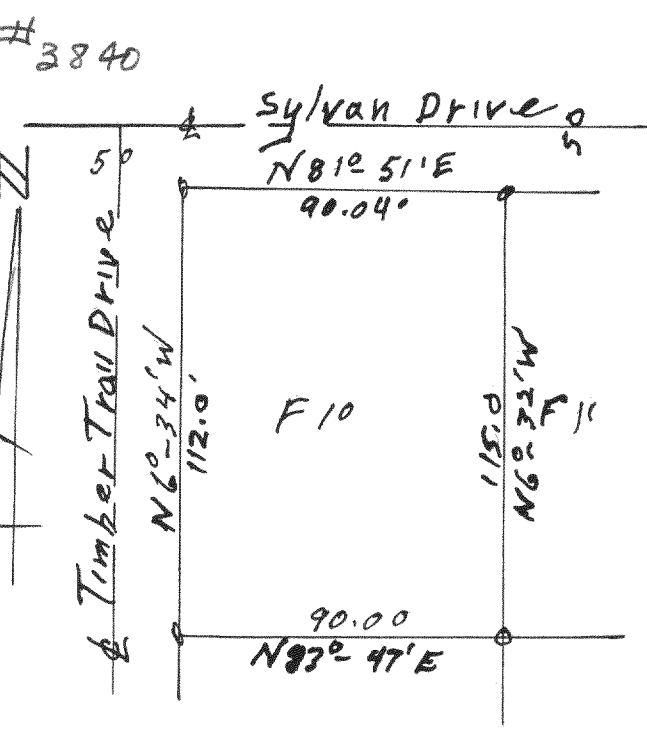


Plat of survey of Lot F10 Add F to Country Club Estates, Village of Fontana, Walworth County Wisconsin Lloyd L. Jensen Feb. 1959 County Surveyor

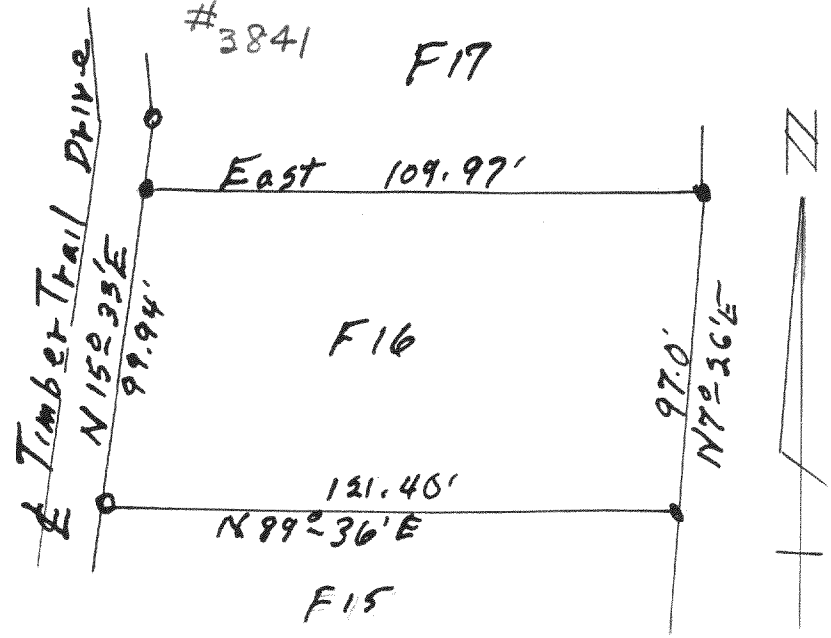


Plat of survey of Lot F16 Add F to Country Club Estates, Village of Fontana, Walworth County Wisconsin Lloyd L. Jensen Feb. 1959 County Surveyor

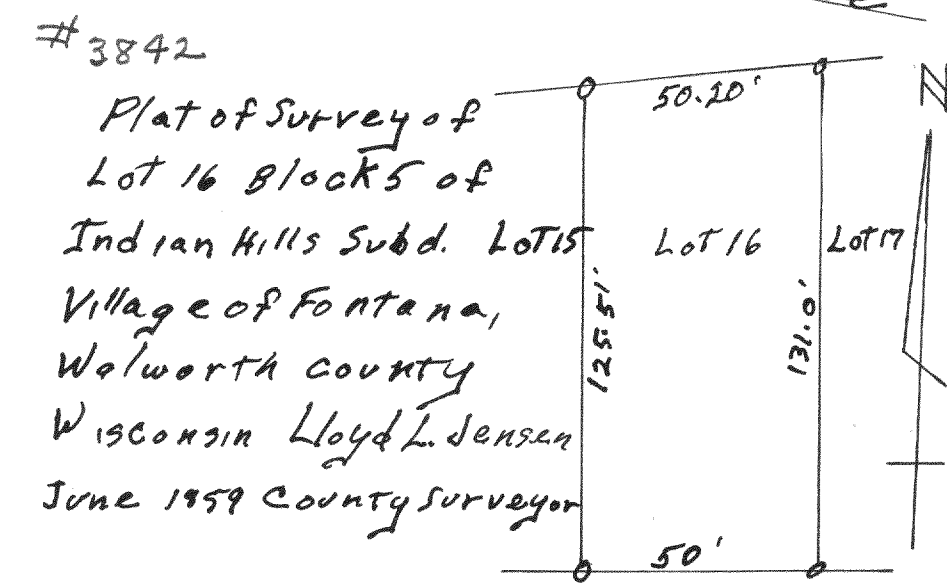


Plat of Survey of Lot 16 Blocks of Indian Hills Subd. Village of Fontana, Walworth County Wisconsin Lloyd L. Jensen June 1959 County Surveyor

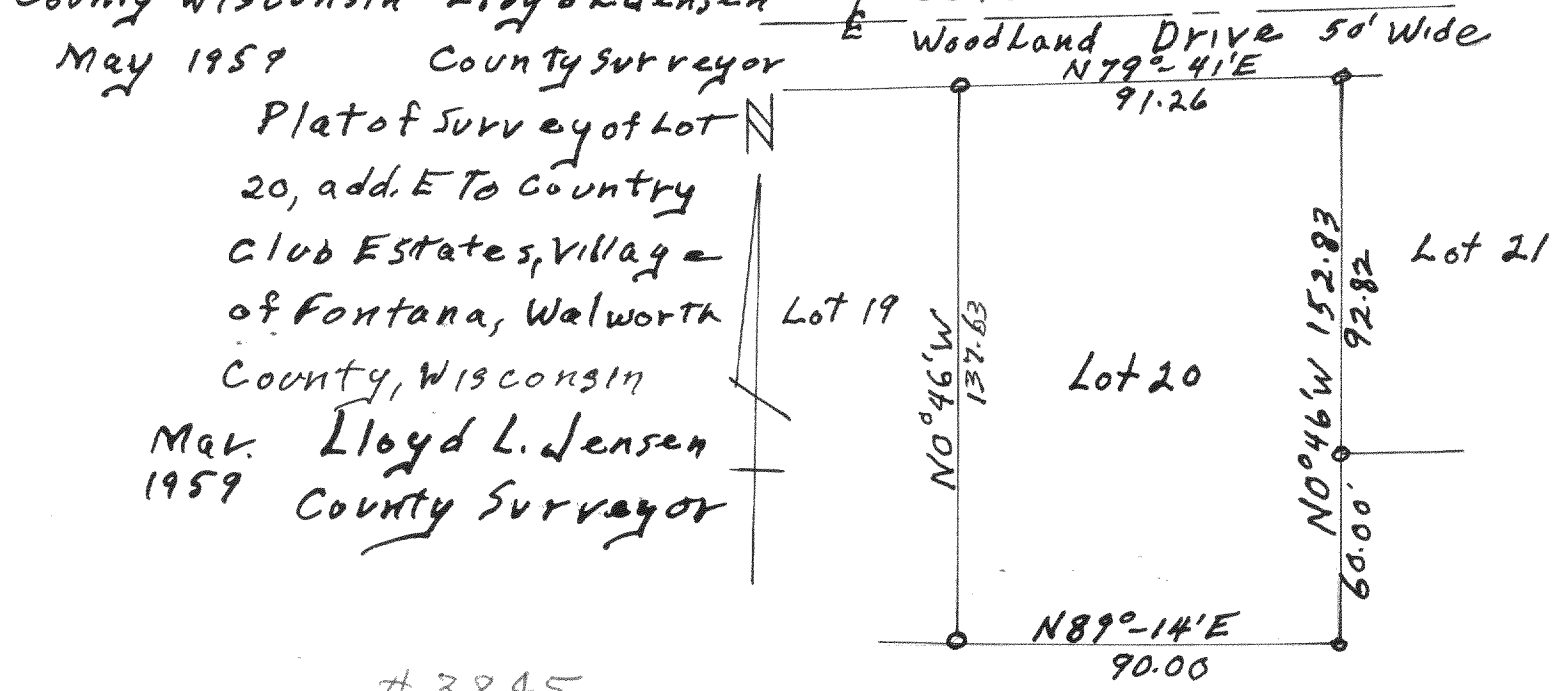

Plat of Survey of Lot 20, add. E To Country Club Estates, Village of Fontana, Walworth County, Wisconsin May Lloyd L. Jensen 1959 County Surveyor

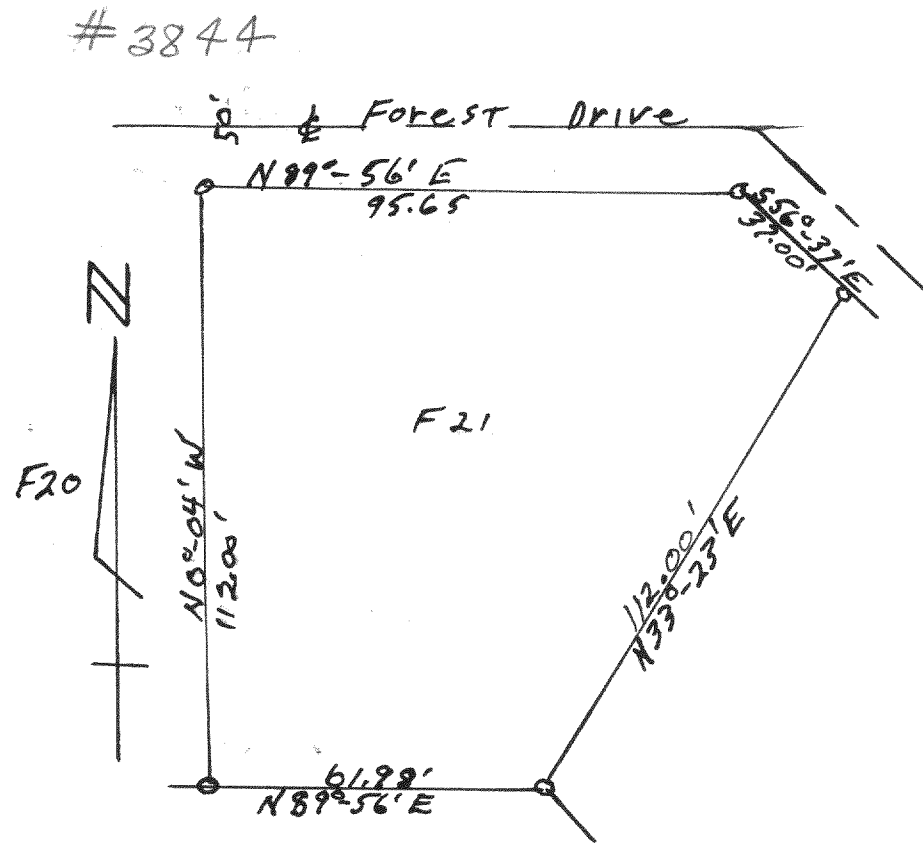

Plat of survey of Lot F21 Add F to Country Club Estates, Village of Fontana, Walworth County Wisconsin NOV. 1959 Lloyd L. Jensen County Surveyor

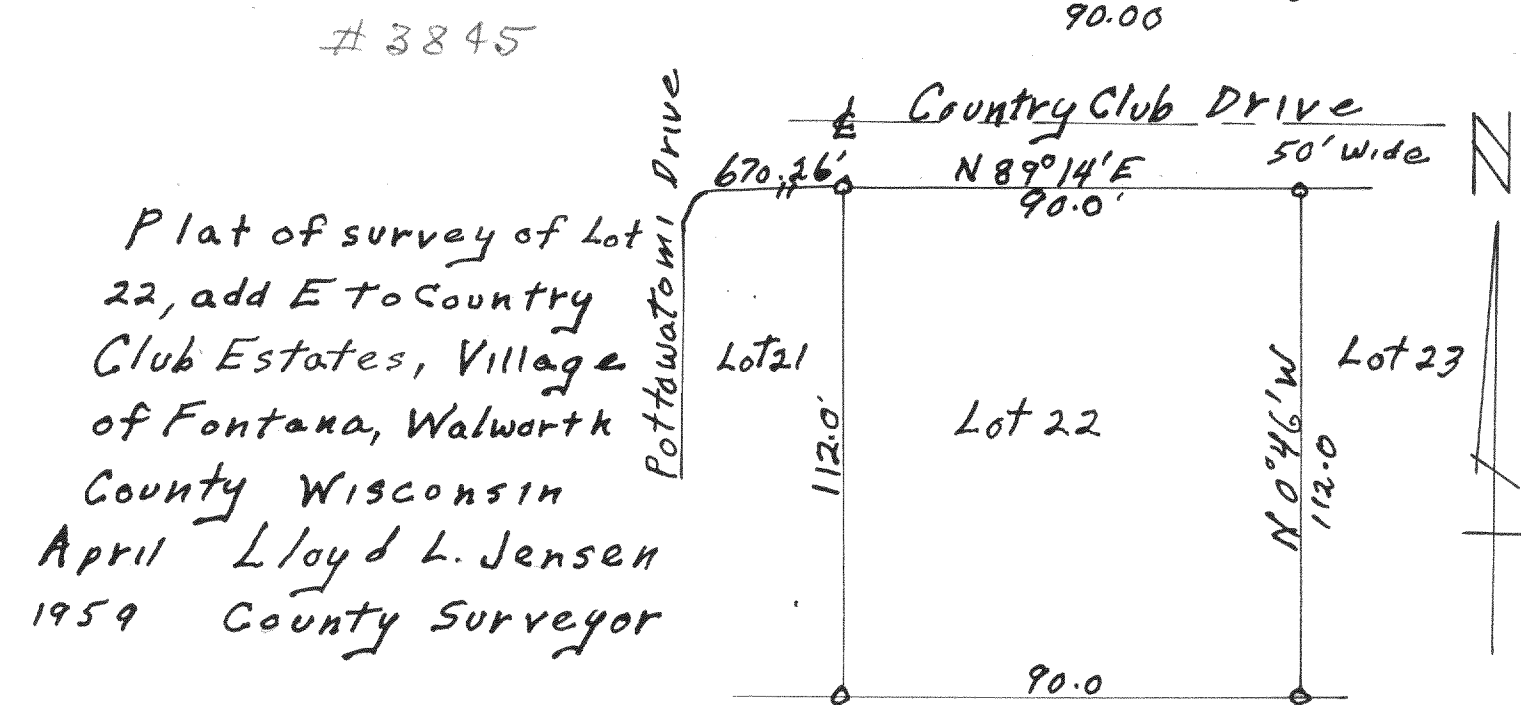

Plat of survey of Lot 22, add E to Country Club Estates, Village of Fontana, Walworth County Wisconsin April Lloyd L. Jensen 1959 County Surveyor