




#4003  
 10  
 11  
 Survey of Alley between blocks 10+11, original Plat at the Village of Fontana on Geneva Lake Date Aug. 1960  
 Lloyd L Jensen  
 (County Surveyor)

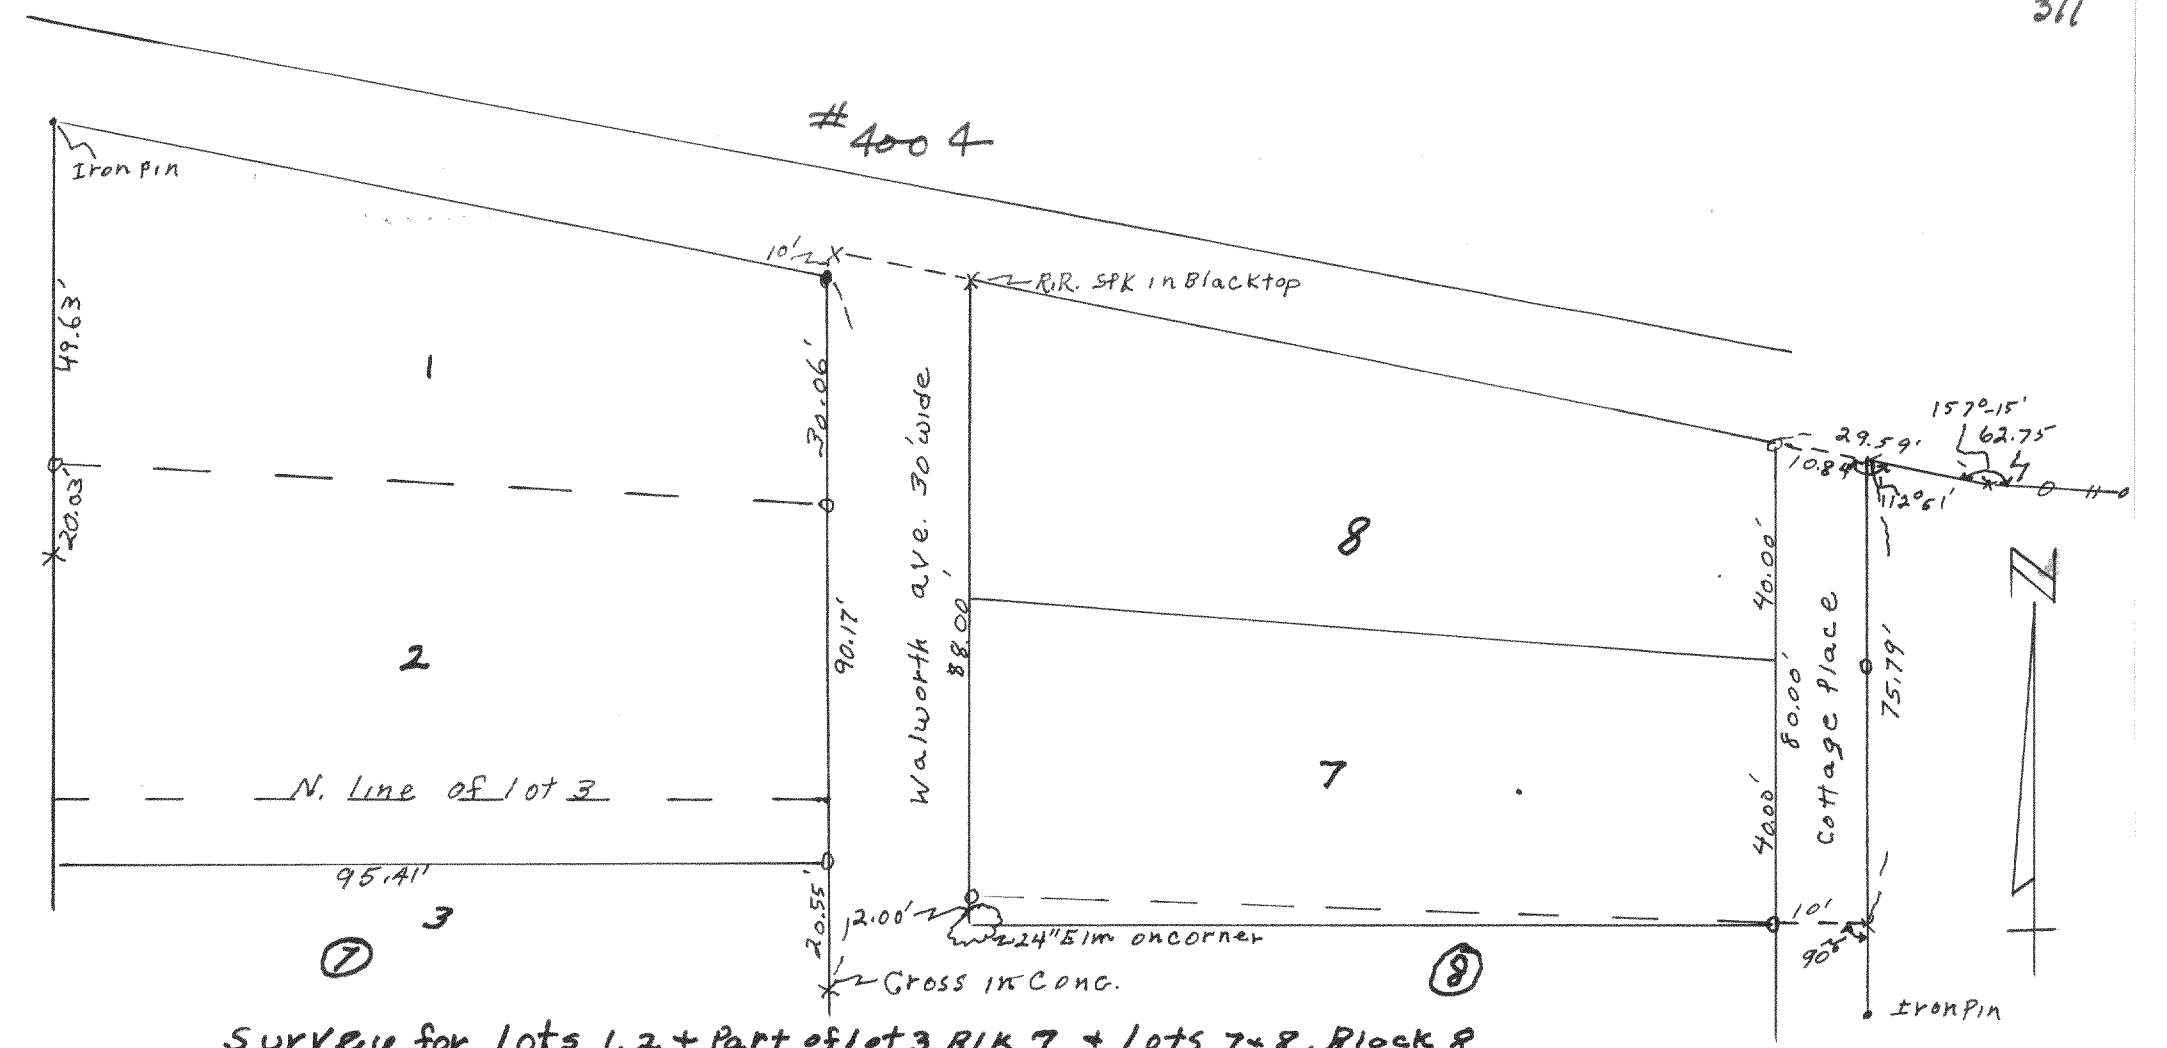

#4004  
 1  
 2  
 3  
 7  
 8  
 Survey for lots 1, 2 + part of lot 3 BIK 7 + lots 7+8, Block 8  
 Glenwood Springs, Village of Fontana Date 8-13-60  
 Lloyd L Jensen  
 (County Surveyor)

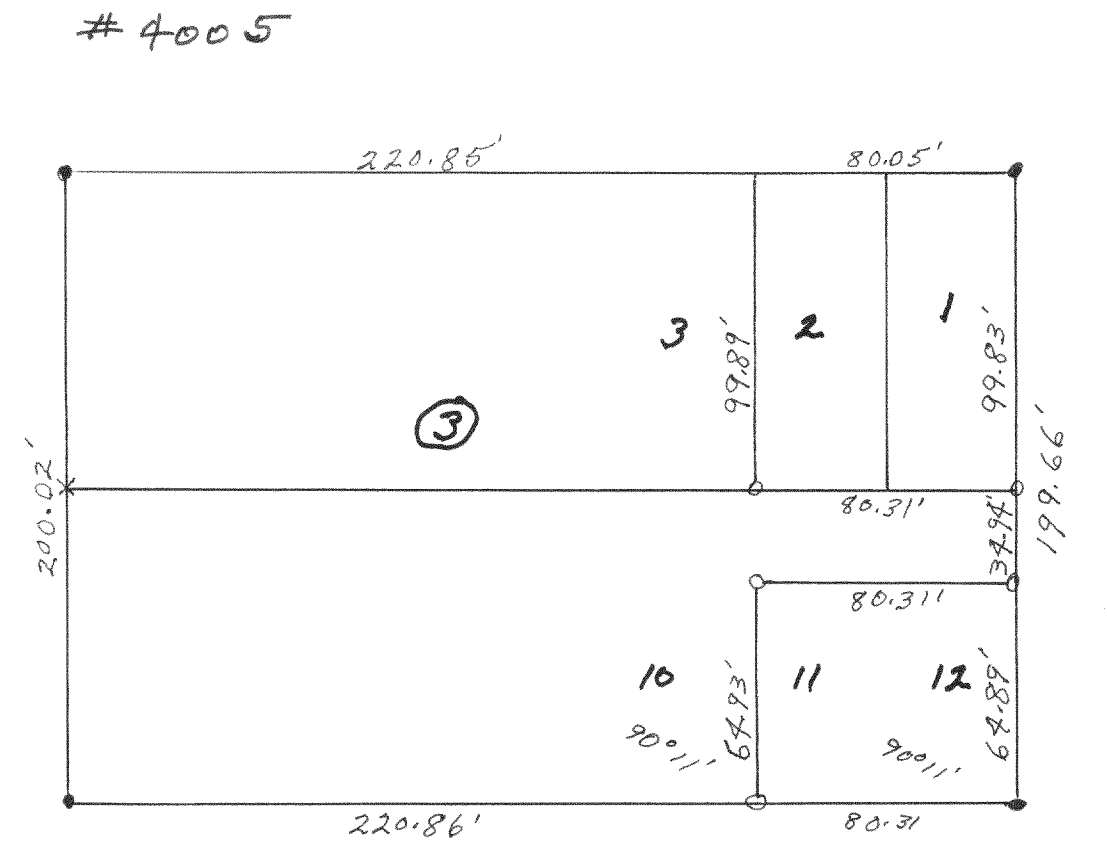

#4005  
 3  
 2  
 1  
 10  
 11  
 12  
 Survey of Lots 11+12, Block 3, D. A. Reid's Add, Village of Fontana Date 7-7-61  
 Lloyd L Jensen  
 (County Surveyor)

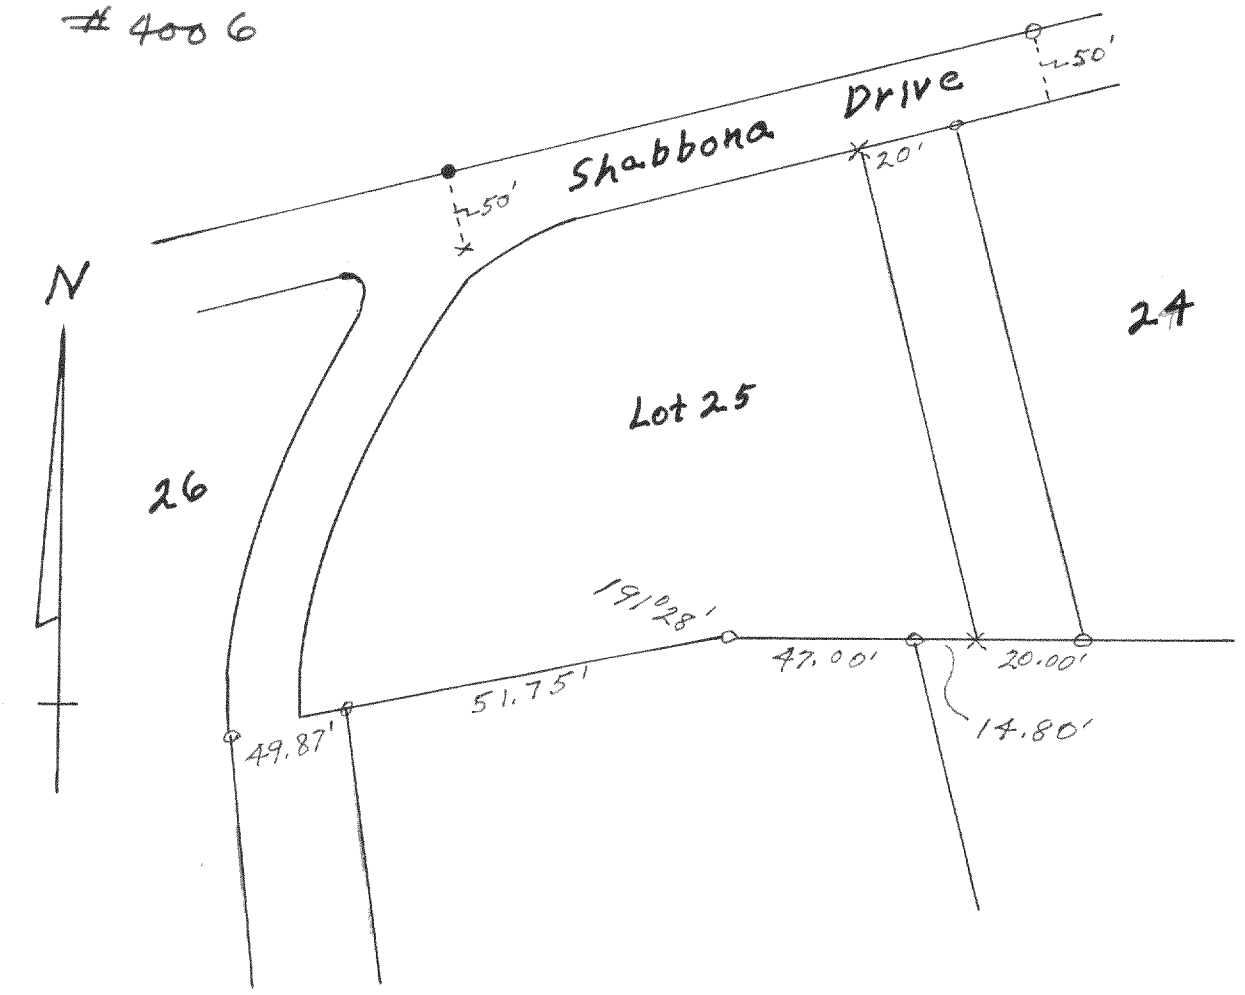

#4006  
 26  
 Lot 25  
 24  
 Survey of Lot 25, Unit 1, Country Club Estates, Village of Fontana - on Geneva Lake Date 4-19-60  
 Lloyd L Jensen  
 (County Surveyor)