




Survey of Lot 8, Block 1,
Brookwood Subd, Village
of Fontana-on-Geneva-Lake
Date 7-6-60 Floyd S Jensen
(County Surveyor)

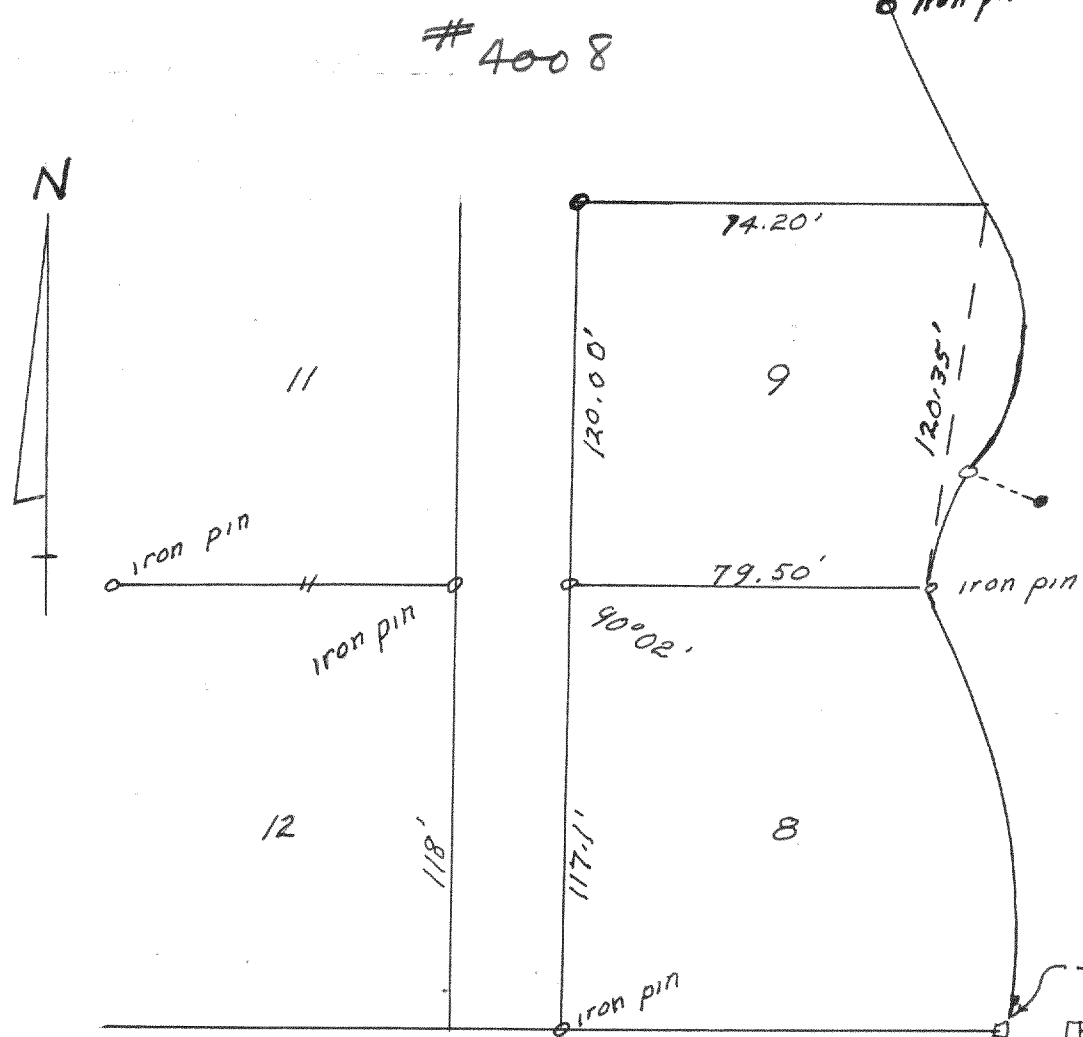


Survey of Lot 9, Club Unique,
Village of Fontana-on-
Geneva Lake
Date 3-24-61
Floyd S Jensen
(County Surveyor)

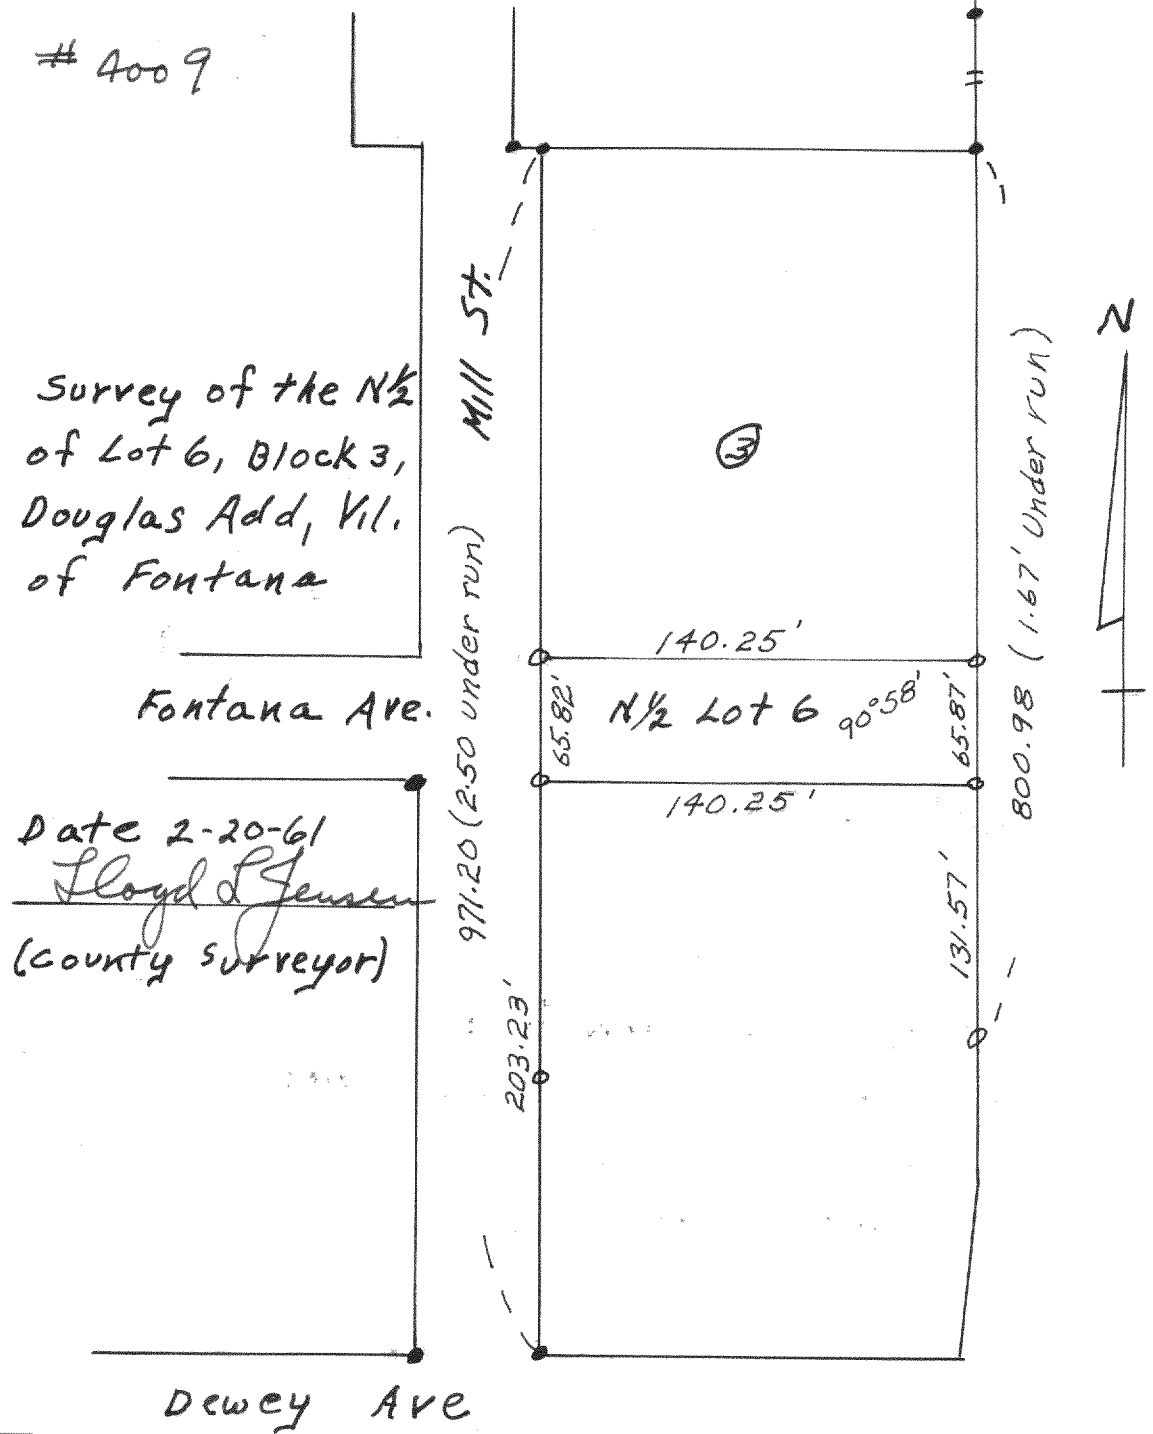

Survey of the N 1/2
of Lot 6, Block 3,
Douglas Add, Vil.
of Fontana
Date 2-20-61
Floyd S Jensen
(County Surveyor)

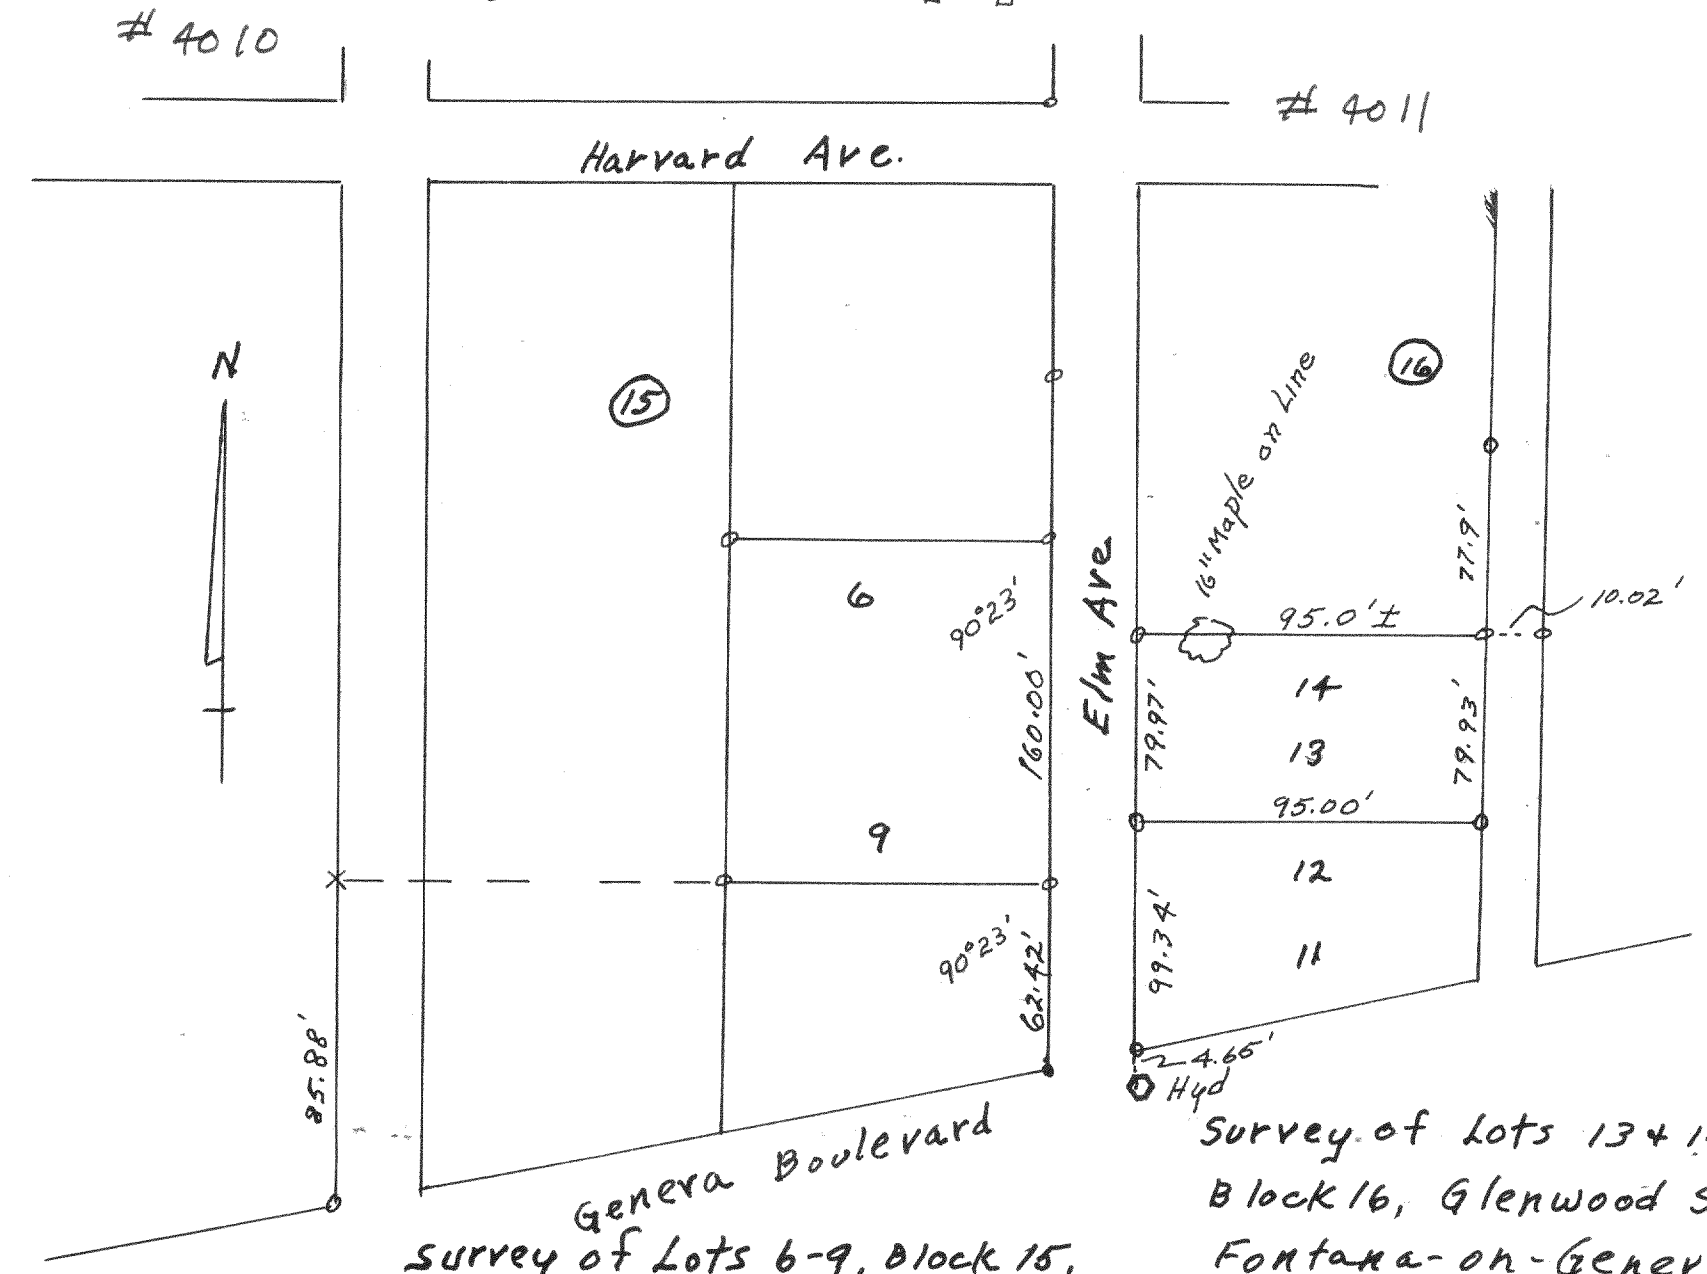

Survey of Lots 6-9, Block 15,
Glenwood Springs, Fontana
Date 6-21-61 Floyd S Jensen
(County Surveyor)

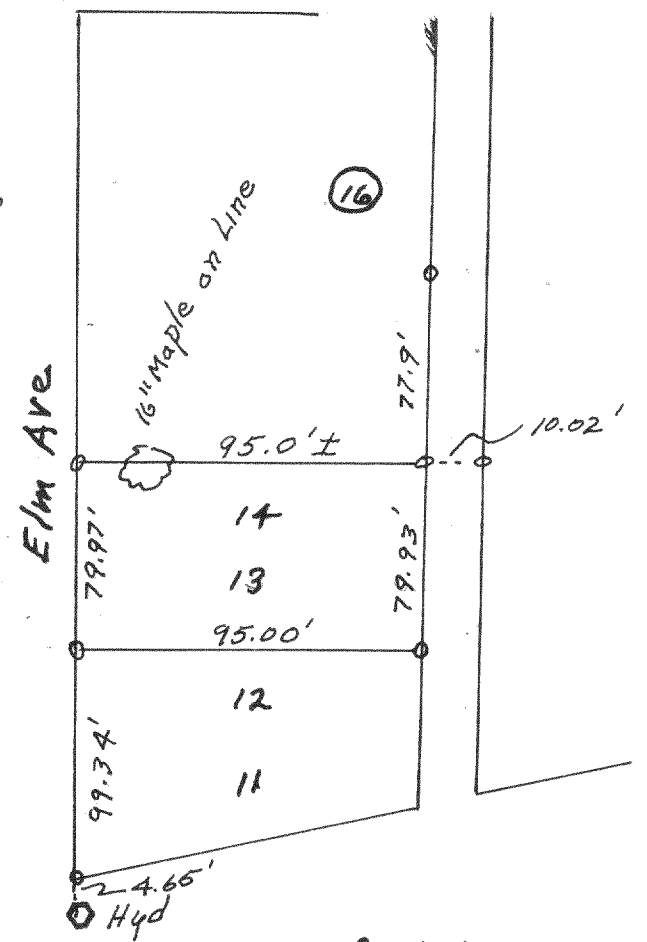

Survey of Lots 13+14,
Block 16, Glenwood Springs,
Fontana-on-Geneva Lake
Date 11-6-61
Floyd S Jensen
(County Surveyor)