


May 1959

Lloyd L. Jensen
Wal. Co. Surveyor

4087

Plat of Survey of
Lot 14 in Block 4 of Citizens addition
To The Village of Sharon Walworth
County, Wisconsin

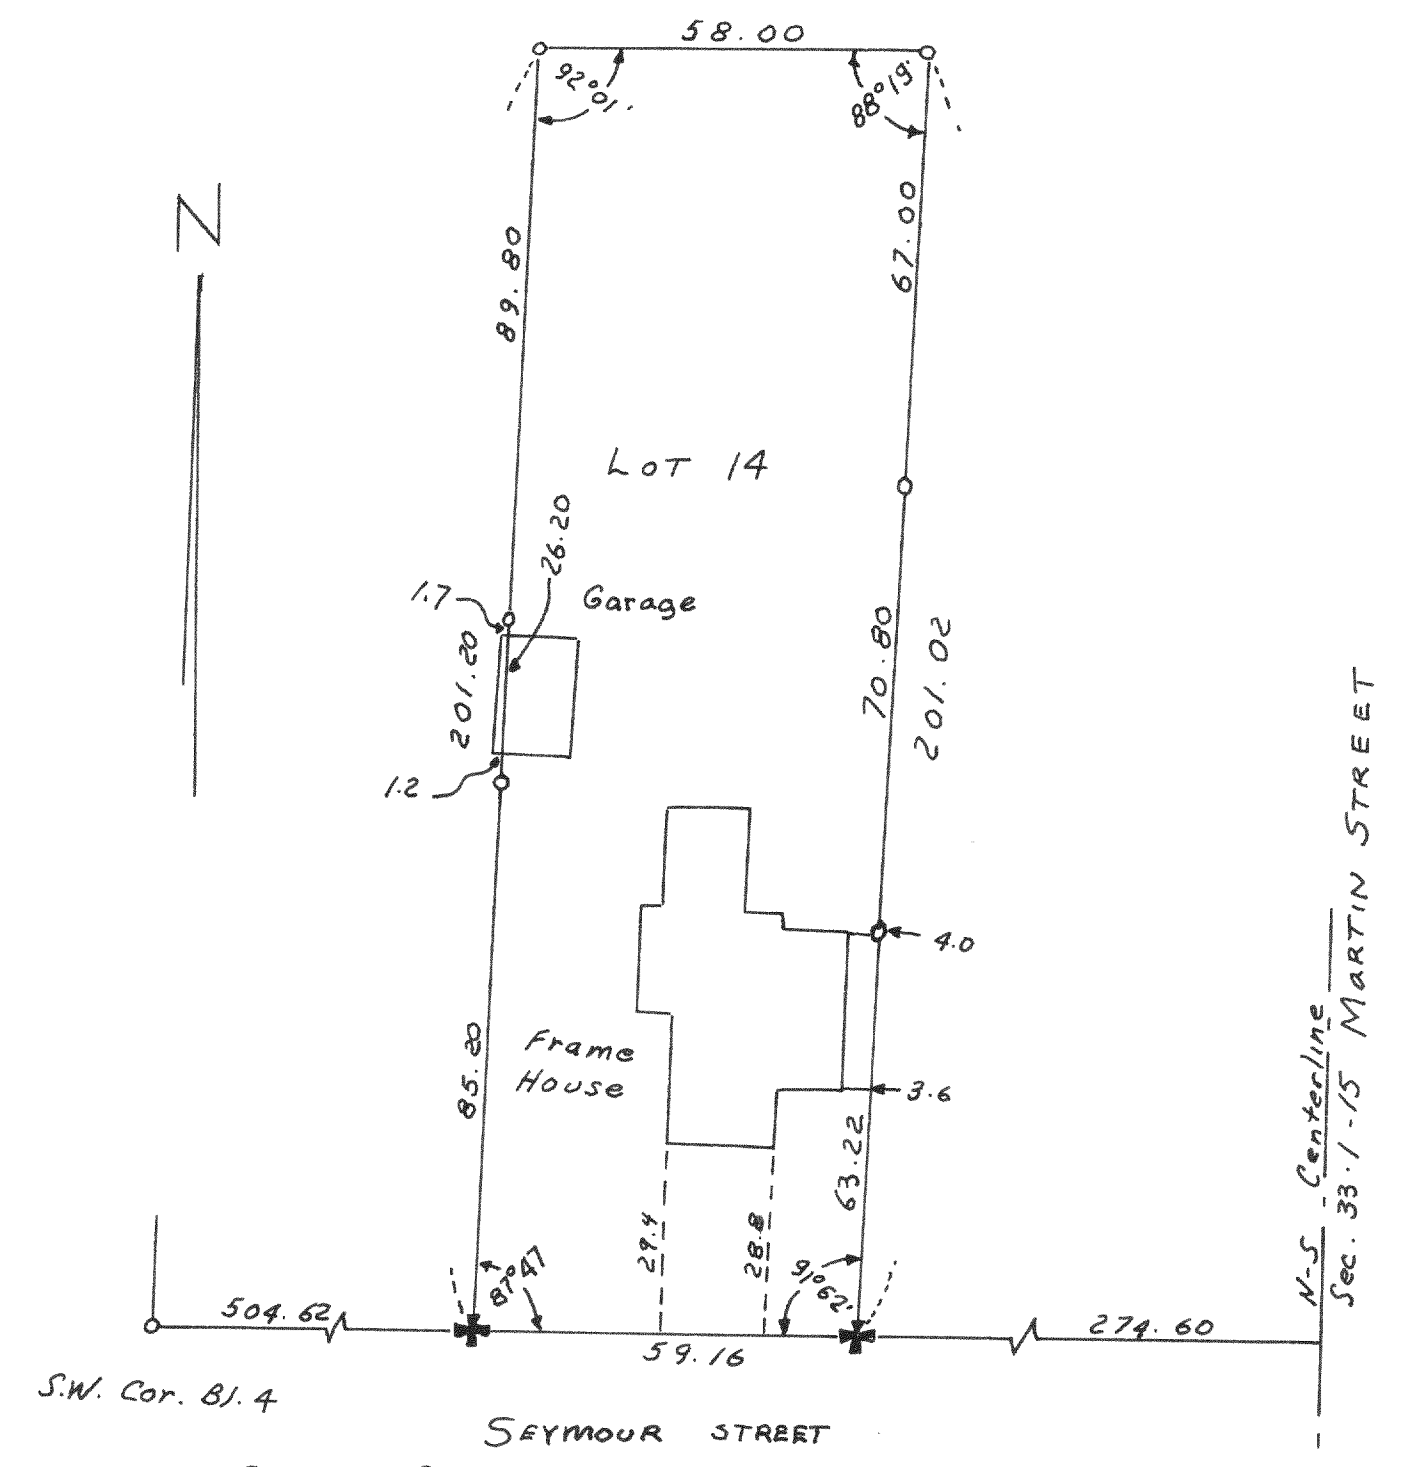

SEPT. 1962

Lloyd L. Jensen
Wal. Co. Surveyor