


4101

PLAT OF SURVEY OF LYONS SCHOOL HS FENCED


A parcel of land located in the Northwest 1/4 of Sec. 10, T2N, R18E, Walworth County, Wisconsin and described as follows; Town: Commencing at the North 1/4 corner of said Sec. 10; Thence West 595.38 feet along the centerline of State Trunk Highway 36; Thence S 5° 48'W 33.85 feet to the corner post of a cyclone fence and the place of beginning; Thence continue S 5° 48'W 204.0 feet along said cyclone fence to a corner post; Thence N 79° 21'W 157.64 feet along the remains of a barbed-wire fence to the corner post; Thence N 75° 25'W 127.9 feet to the corner post of a cyclone fence; Thence N 11° 35'E 142.8 feet along said cyclone fence to a corner post; Thence N 89° 39'E 270.7 feet along said cyclone fence to the place of beginning, intending to describe the land now enclosed by the fence for Lyons School.

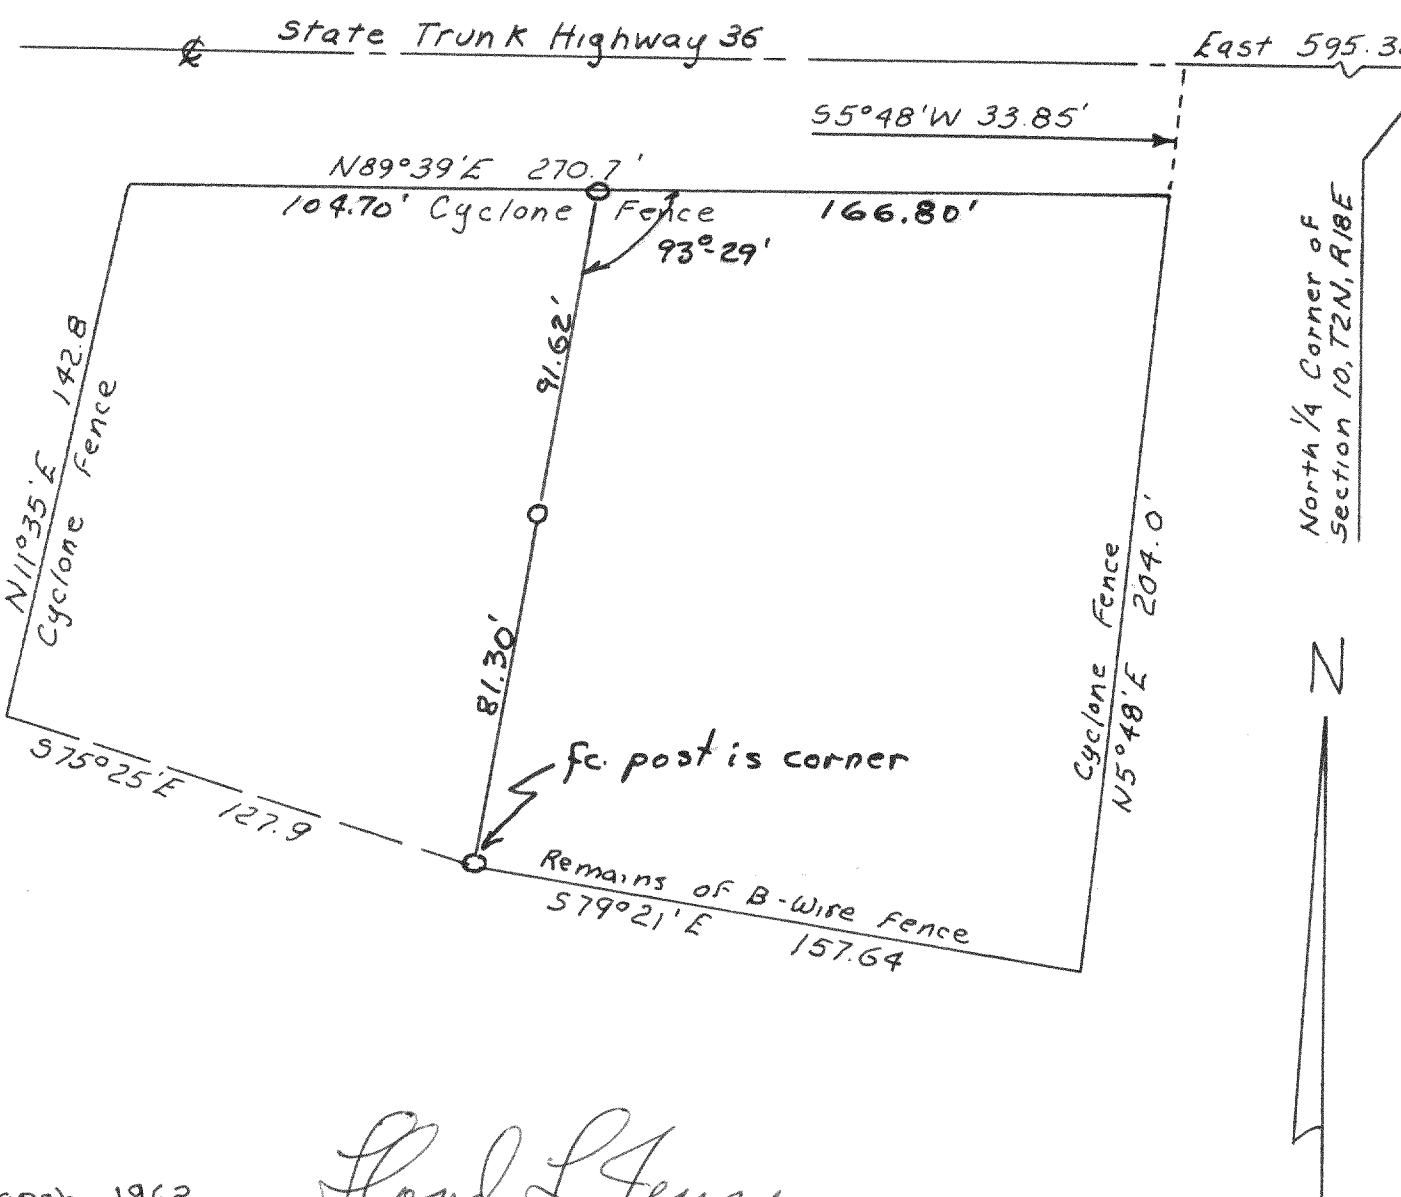

4102

PLAT OF SURVEY OF

LOT 10 - BLOCK 1, MIRAMAR Subdivision located in Section 10 & 11 T.4 N., R.18 E. Walworth County, Wisconsin

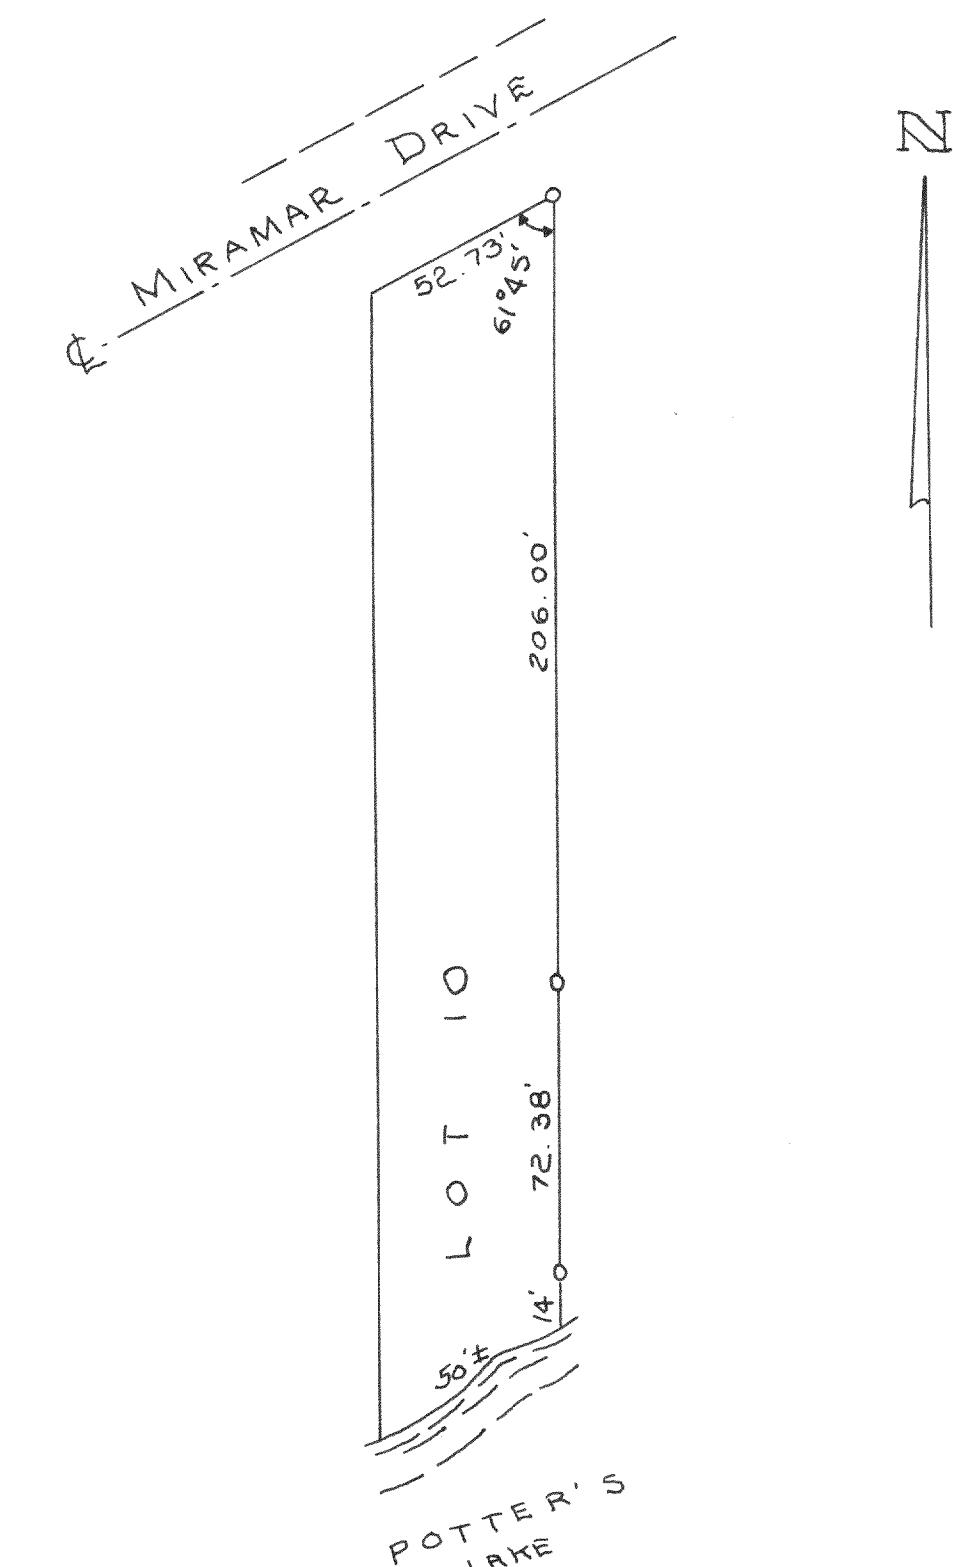

NOV. 1962

Lloyd L Jensen
Wal. Co. Surveyor