




2759

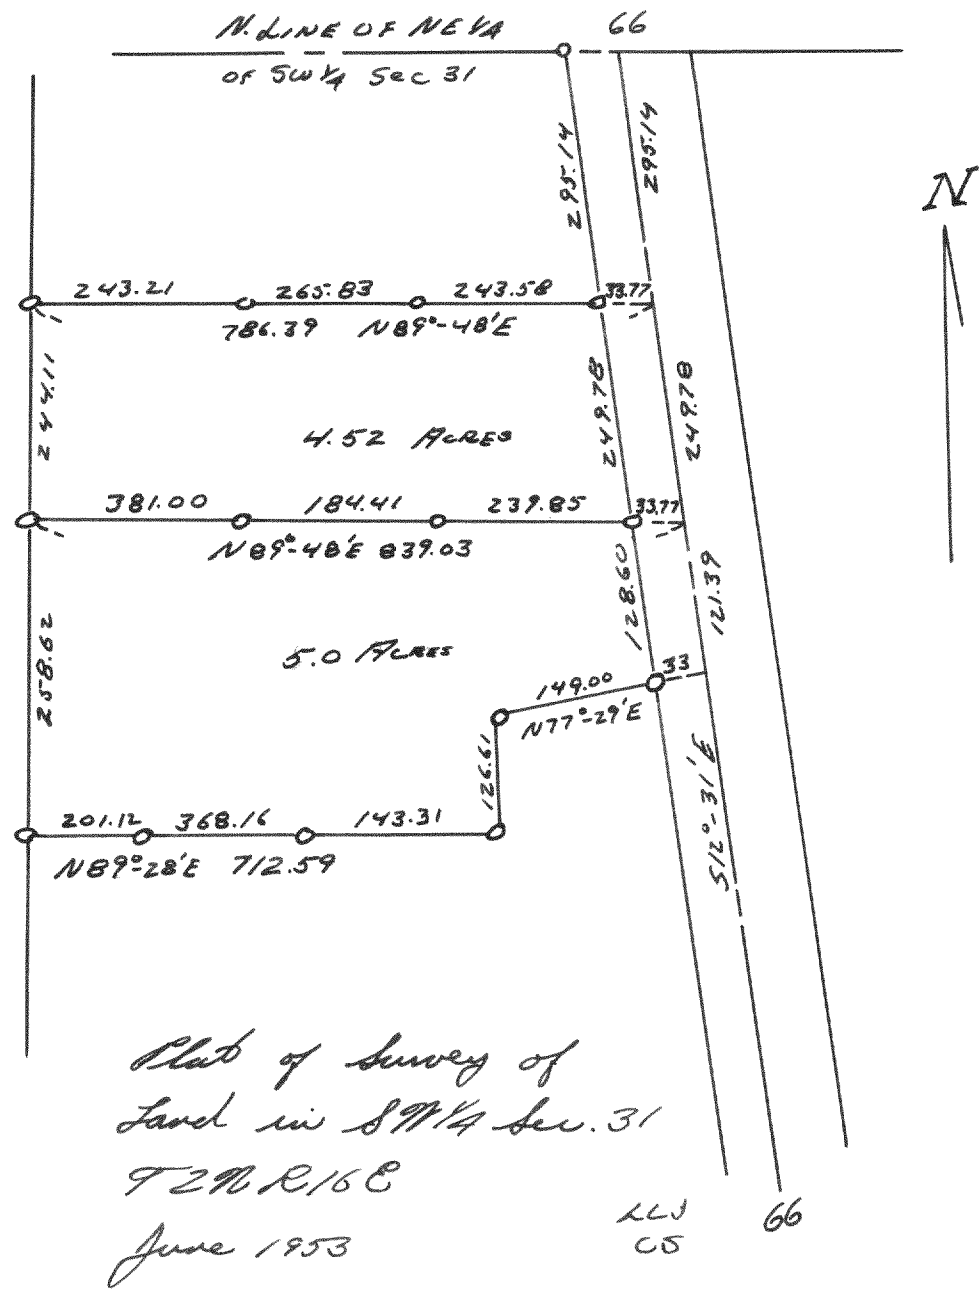


2760

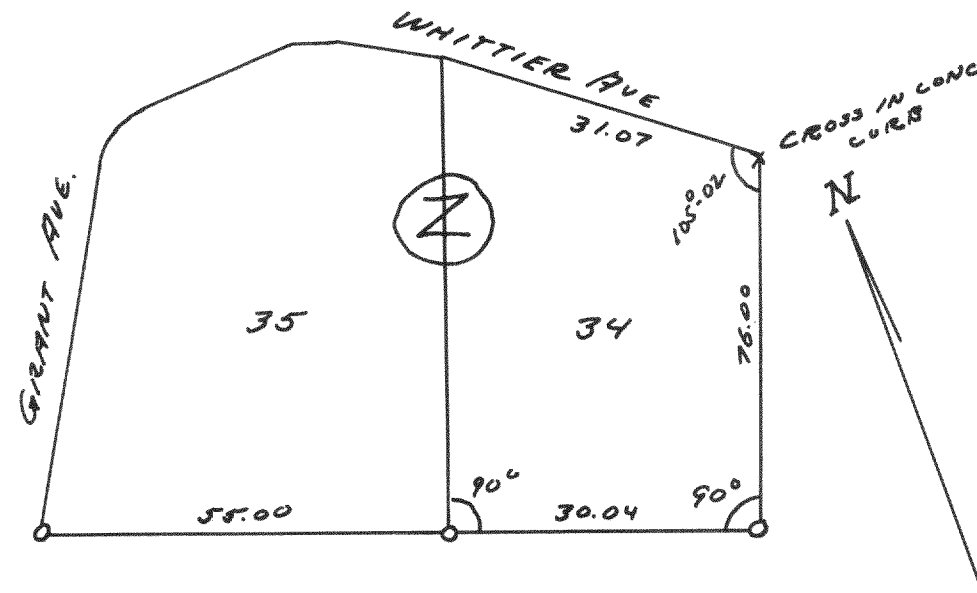

2761

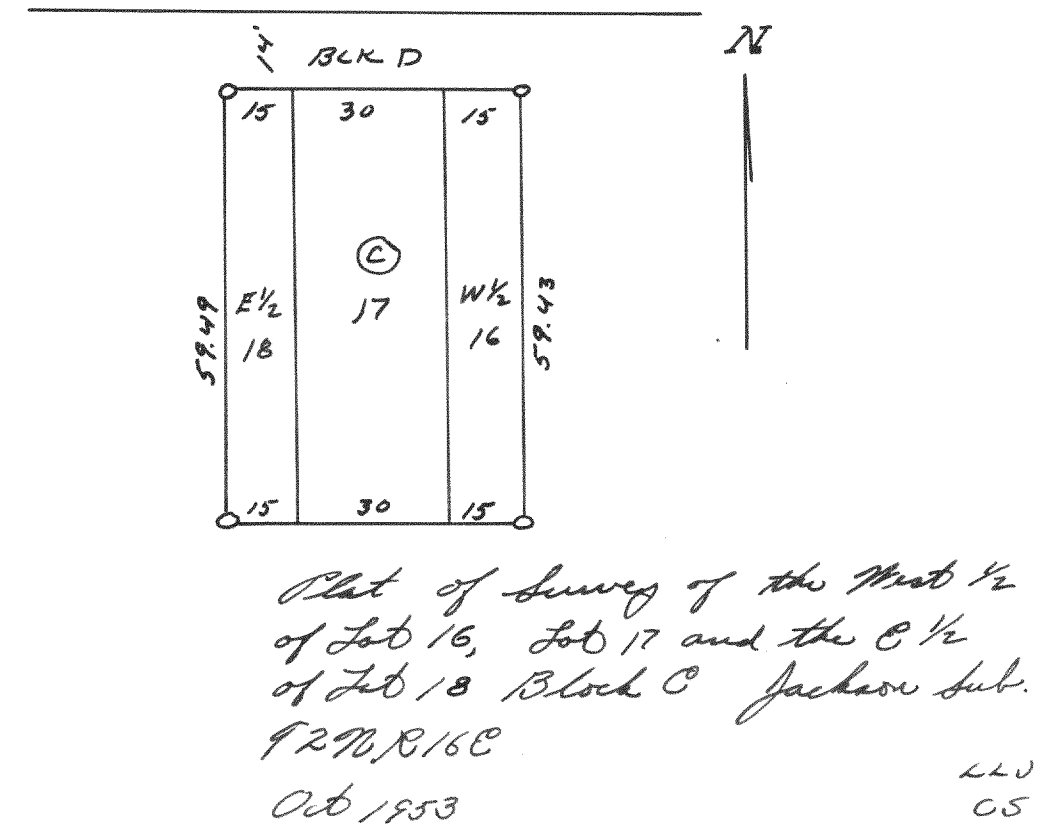


2762

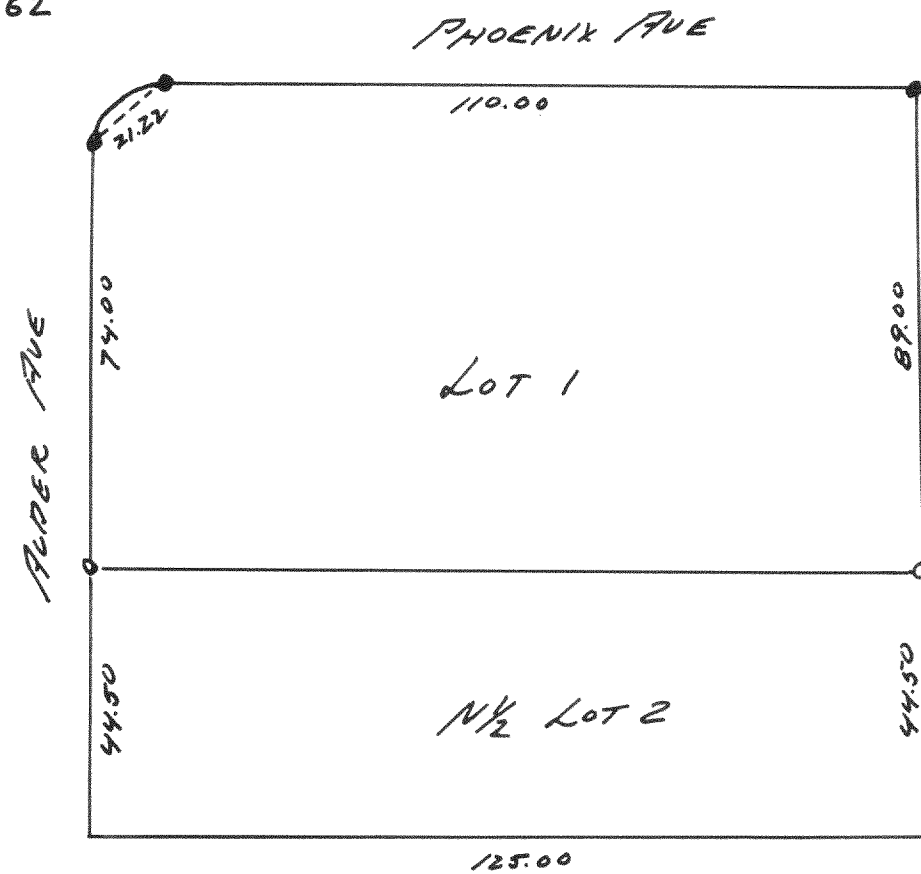

Plat of Survey of Lot 1 & 1/2 Lot 2
Bld 2 Allghunt Sub.
Sec. 17 & 20 F29R16E
Sept 1953

LLV
CS

2763

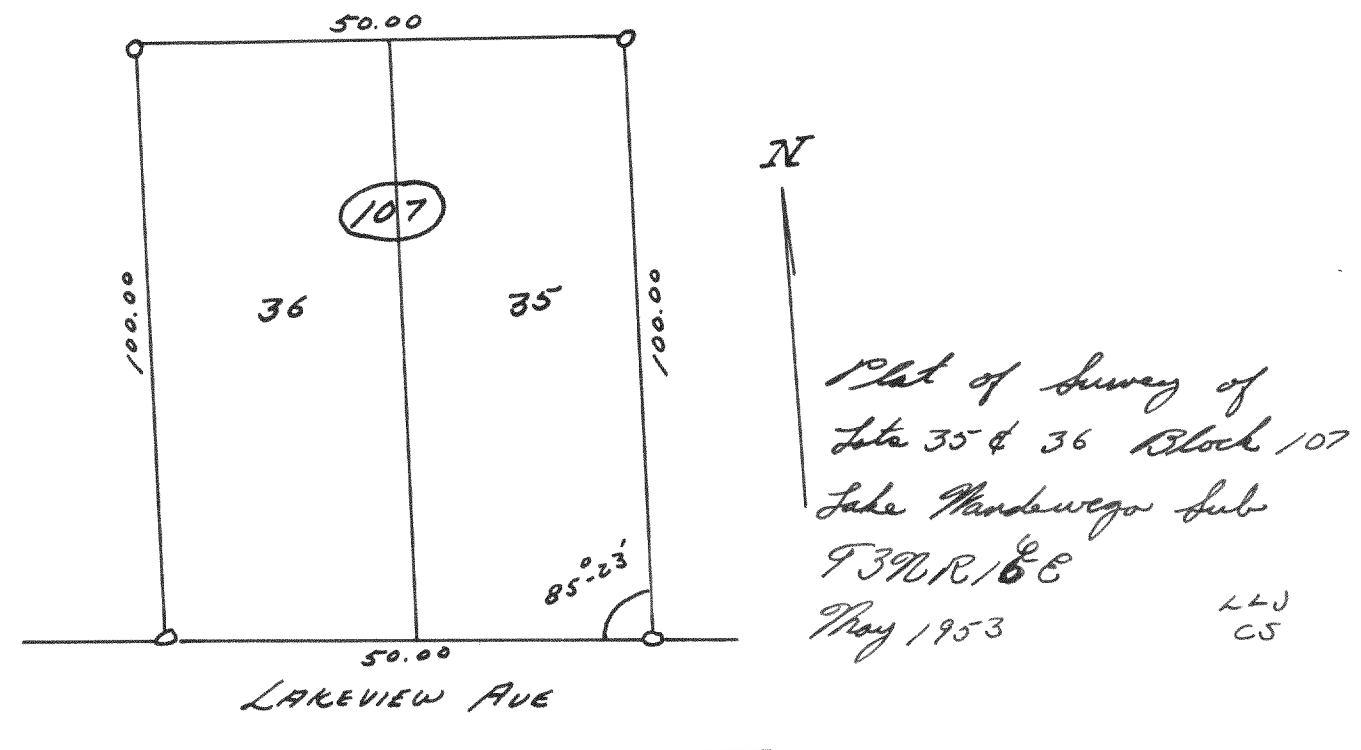

Plat of Survey of Lots 35 & 36 Block 107
Lake Harbawego Sub
F39R16E
May 1953

LLV
CS