




2769

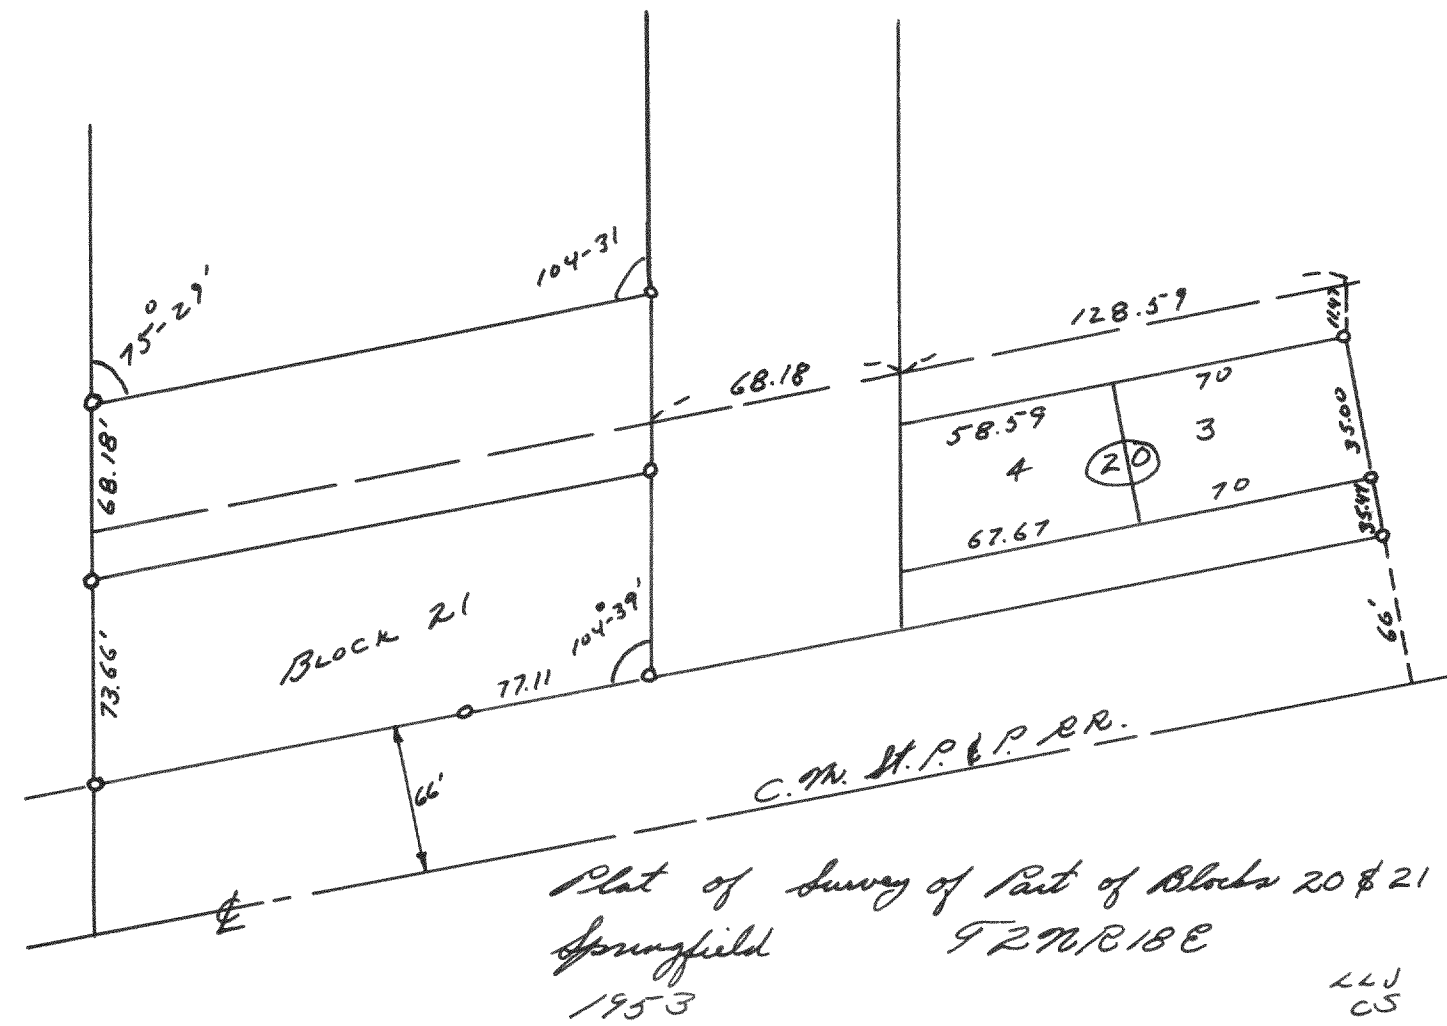

2771

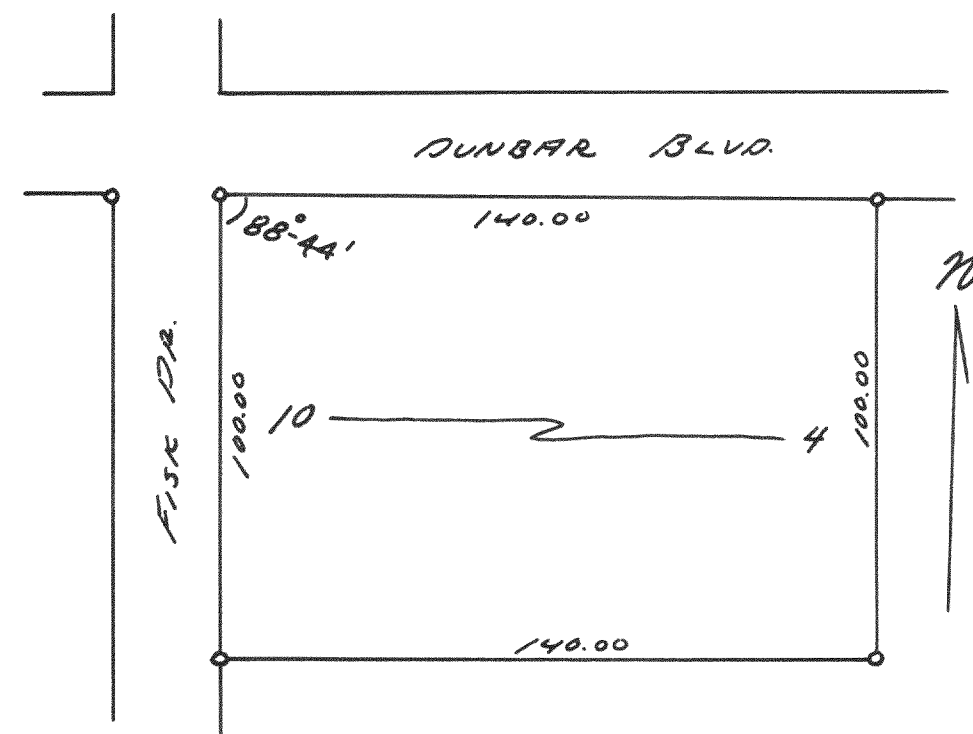

2770

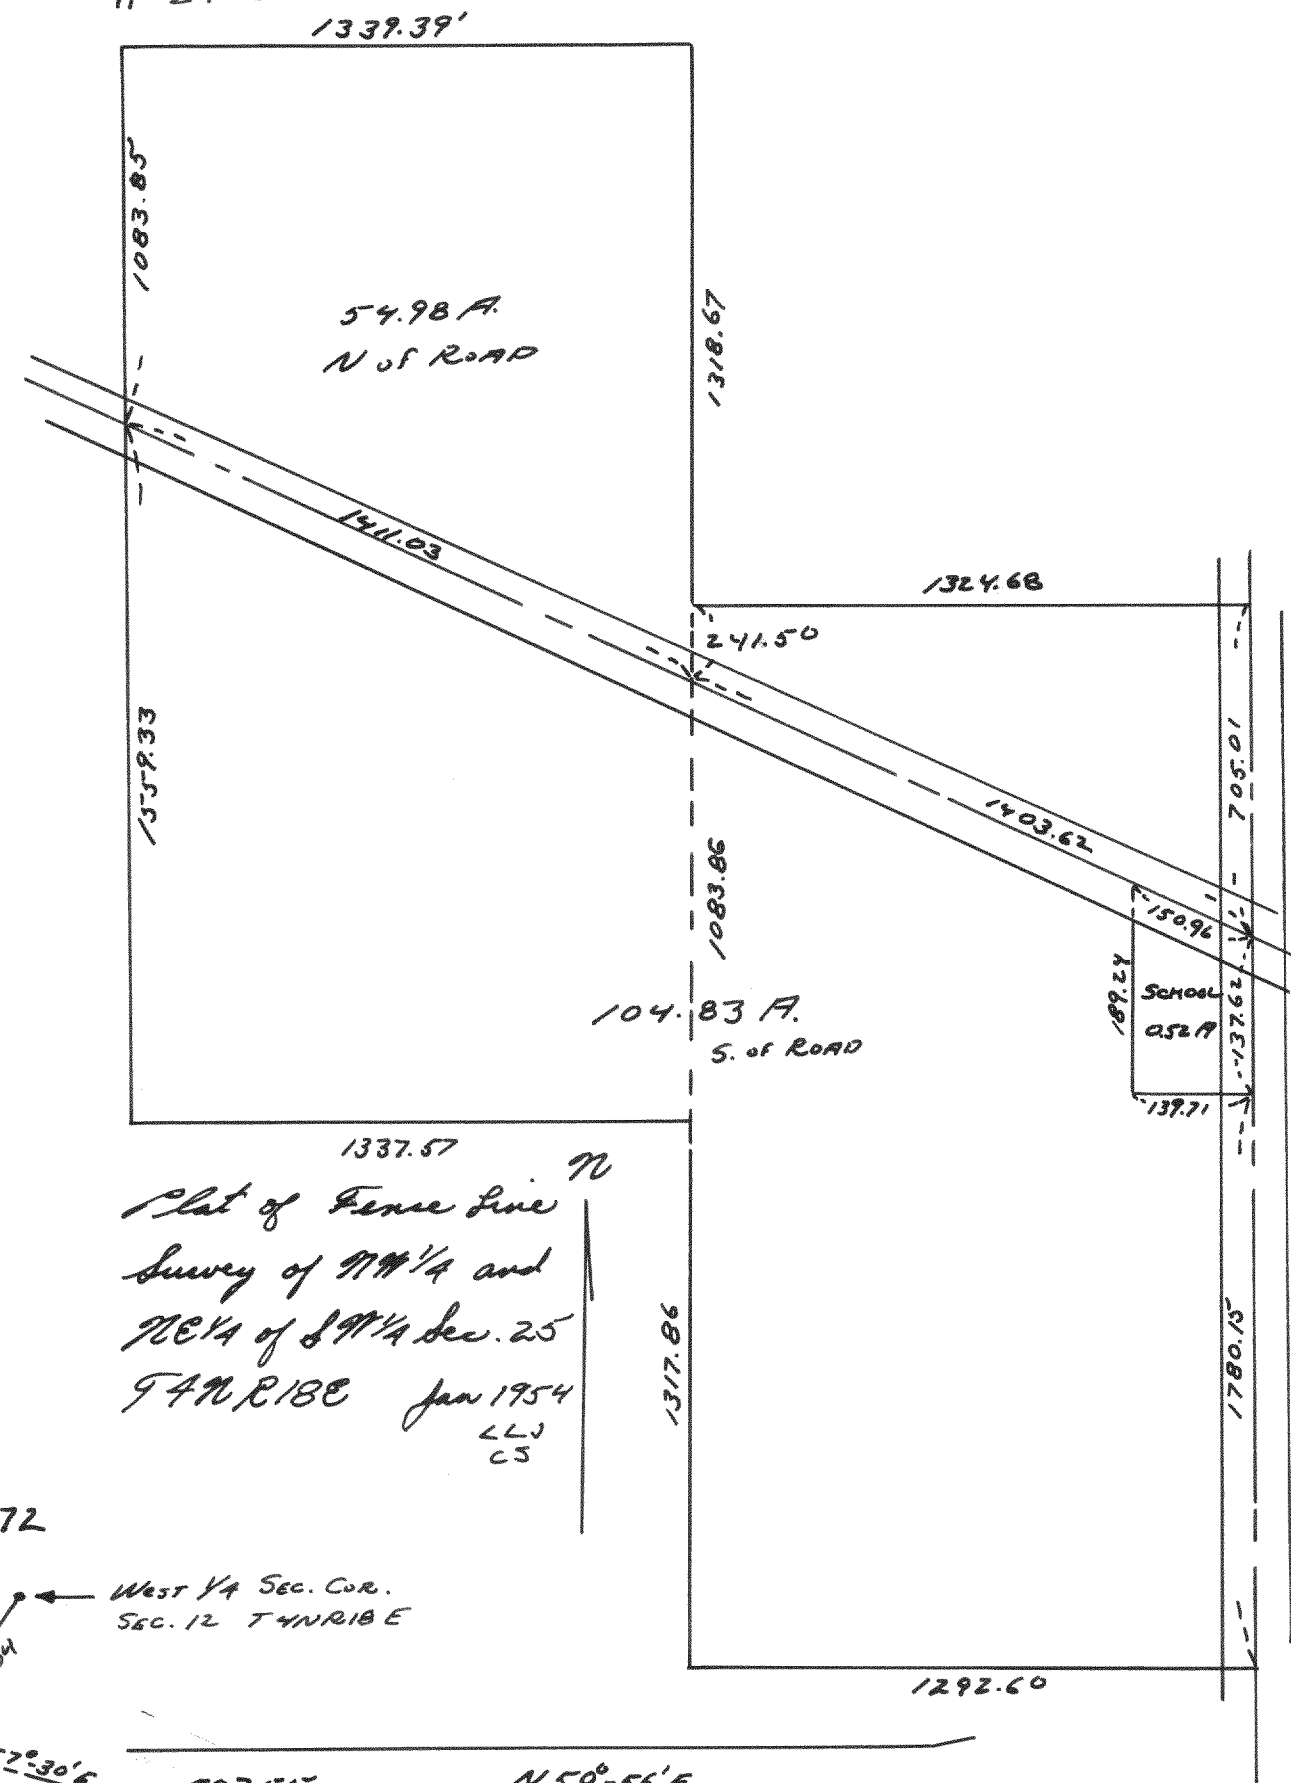

2772

