



2784

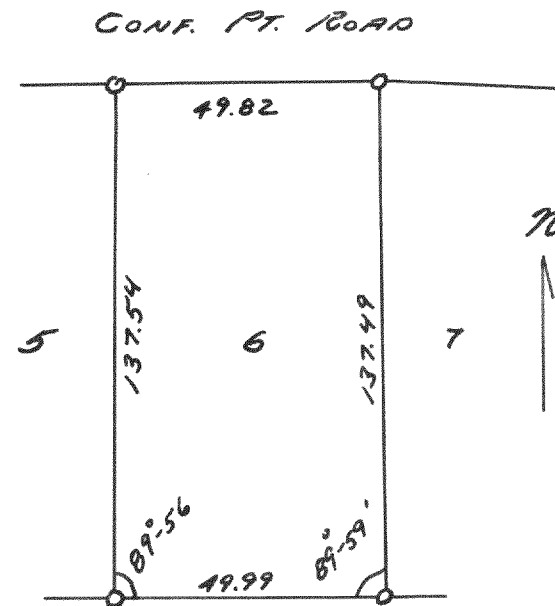

Plat of Survey of Lot 6
of Summerhaven Village of
Williams Bay July 1953

LLJ
CS


2785

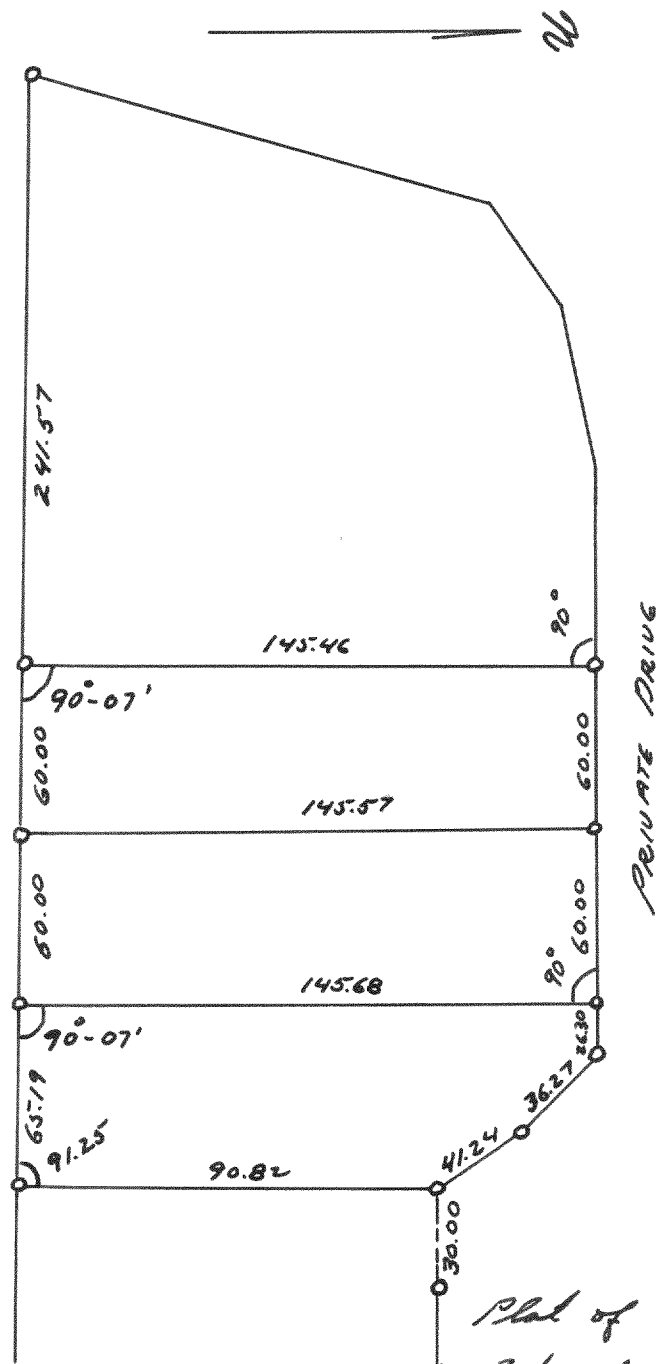

Plat of Survey of
Part of Lot 10 of
Jewell's Sub.
Village of Williams Bay
July 1953

LLJ
CS

2786

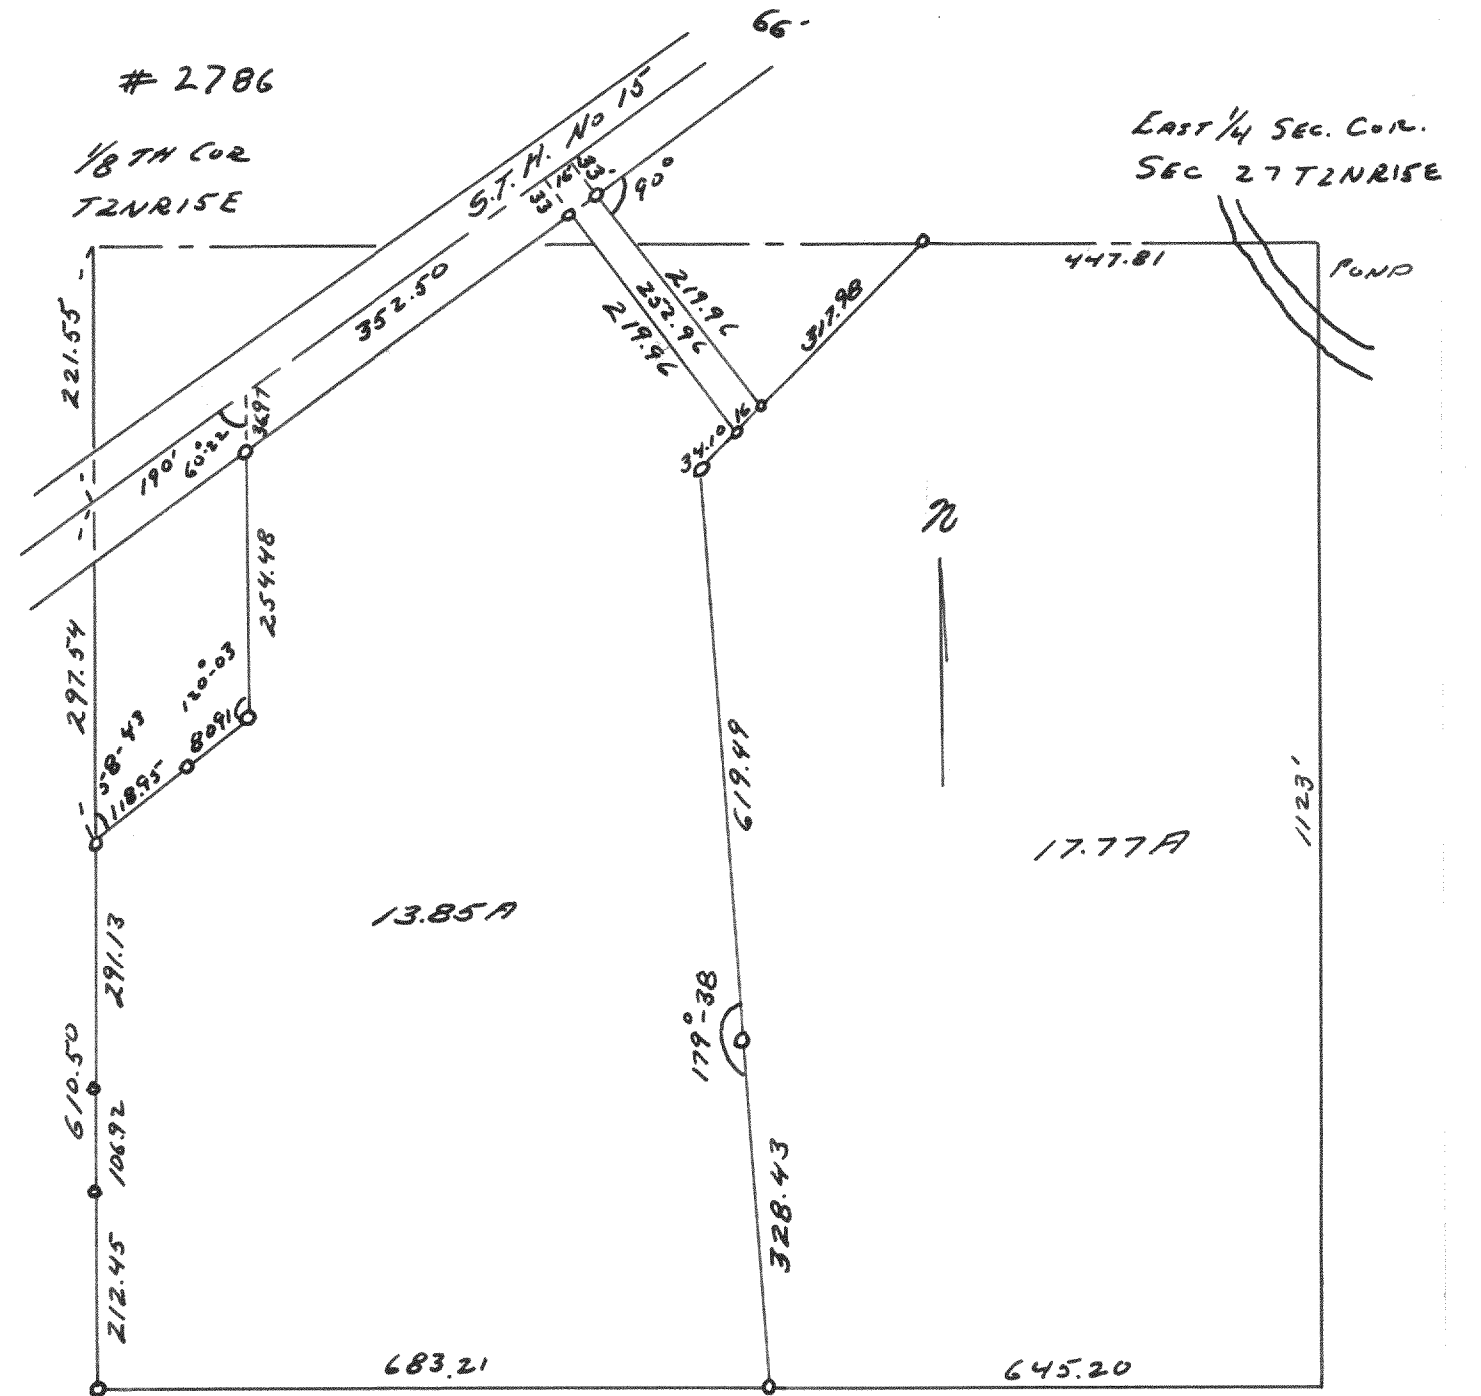


Plat of Survey of Land Located in Part 1/2
of Section 27 T2N R15E
April 1953

LLJ
CS


2787

Plat of Survey of Lots 5-8 in
2nd Observatory Sub. Village of Williams Bay
AUG. 1953

LLJ
CS

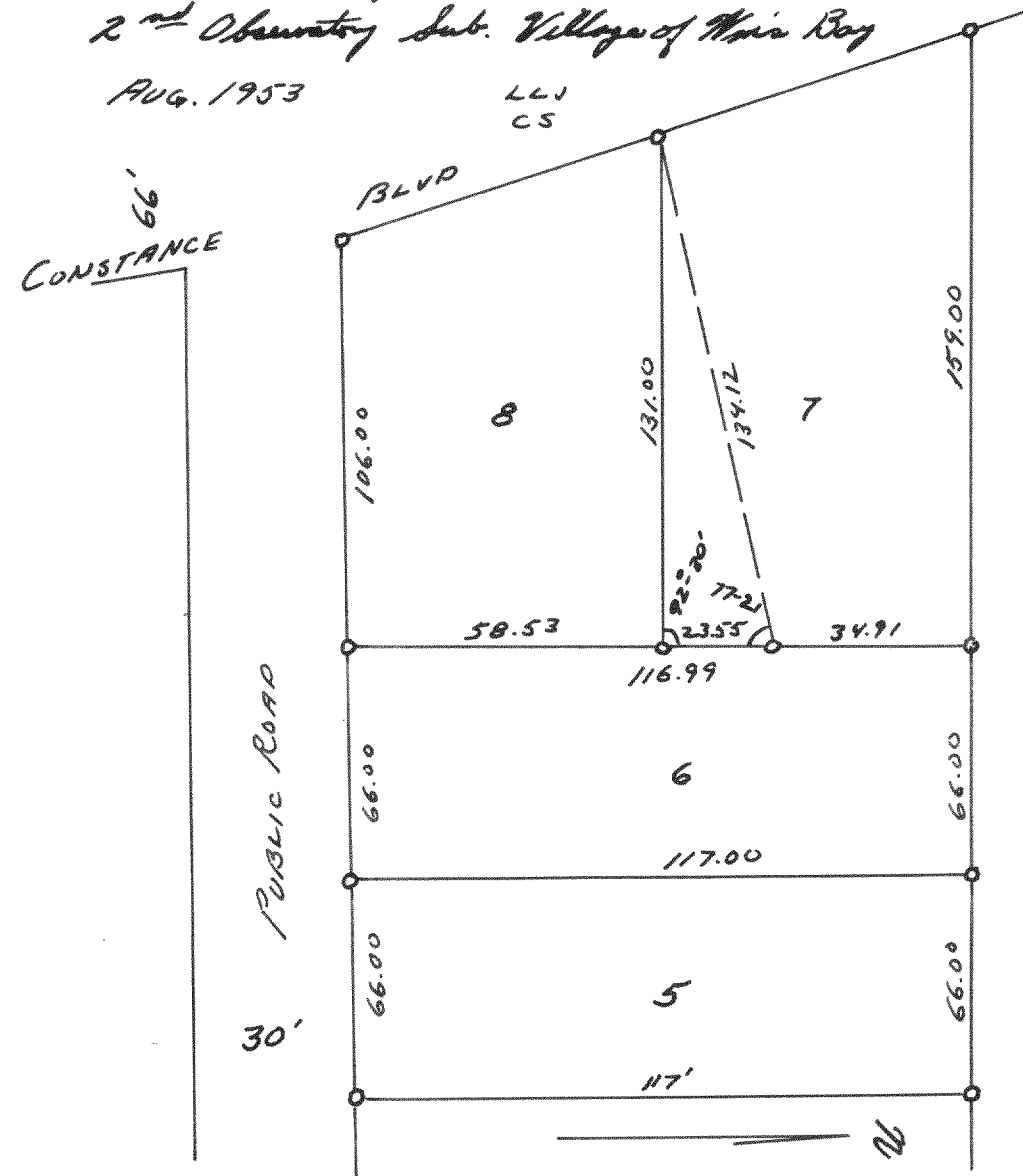

2788

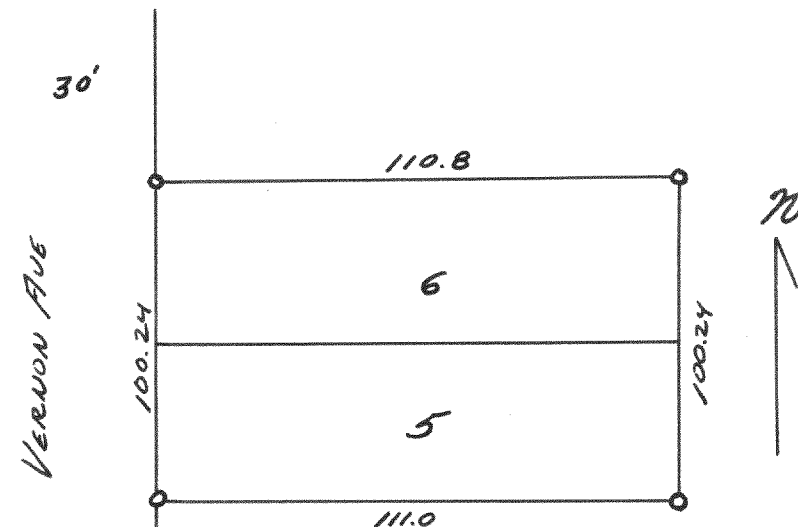

Plat of Survey of Lots 5 & 6 of Lockwood Subdivision
Village of Williams Bay
Aug. 1953

LLJ
CS