



#4317

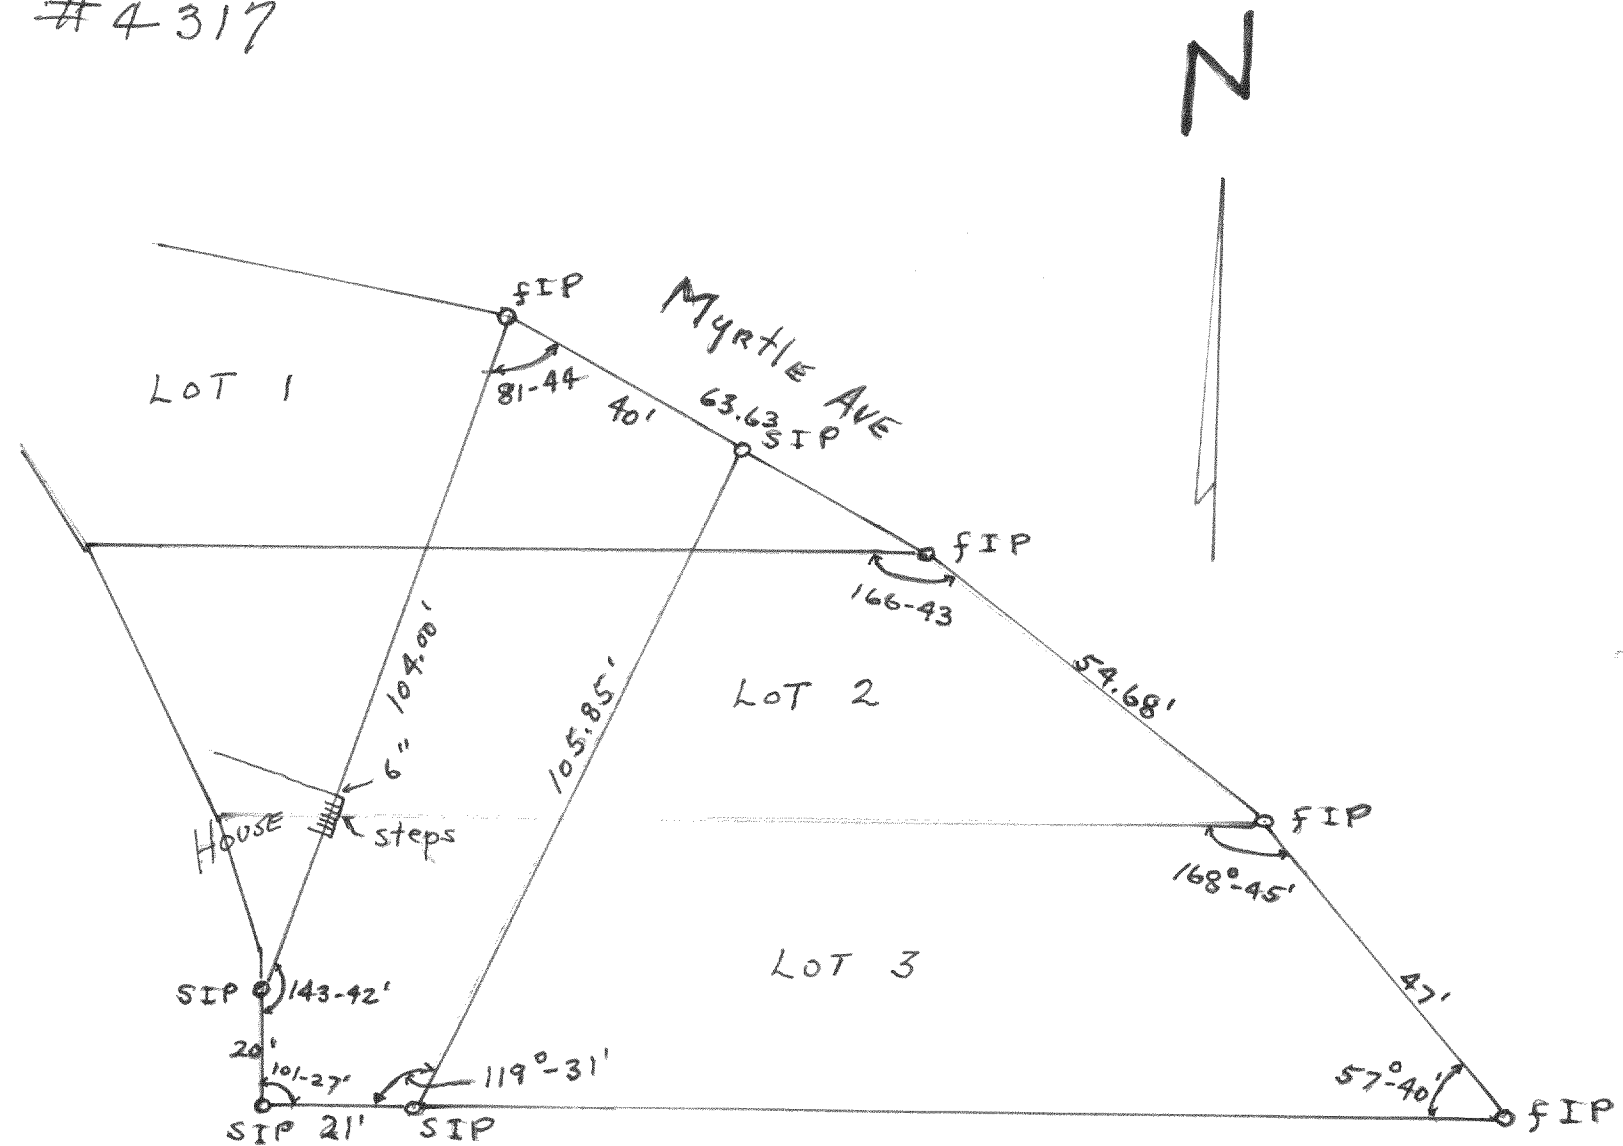

Plat of SURVEY of part of Lot 1, 2 + 3
 of Block 10 of Glenwood Springs,
 Village of Fontana
 May. 1963

Lloyd Jensen
 County Surveyor

#4318

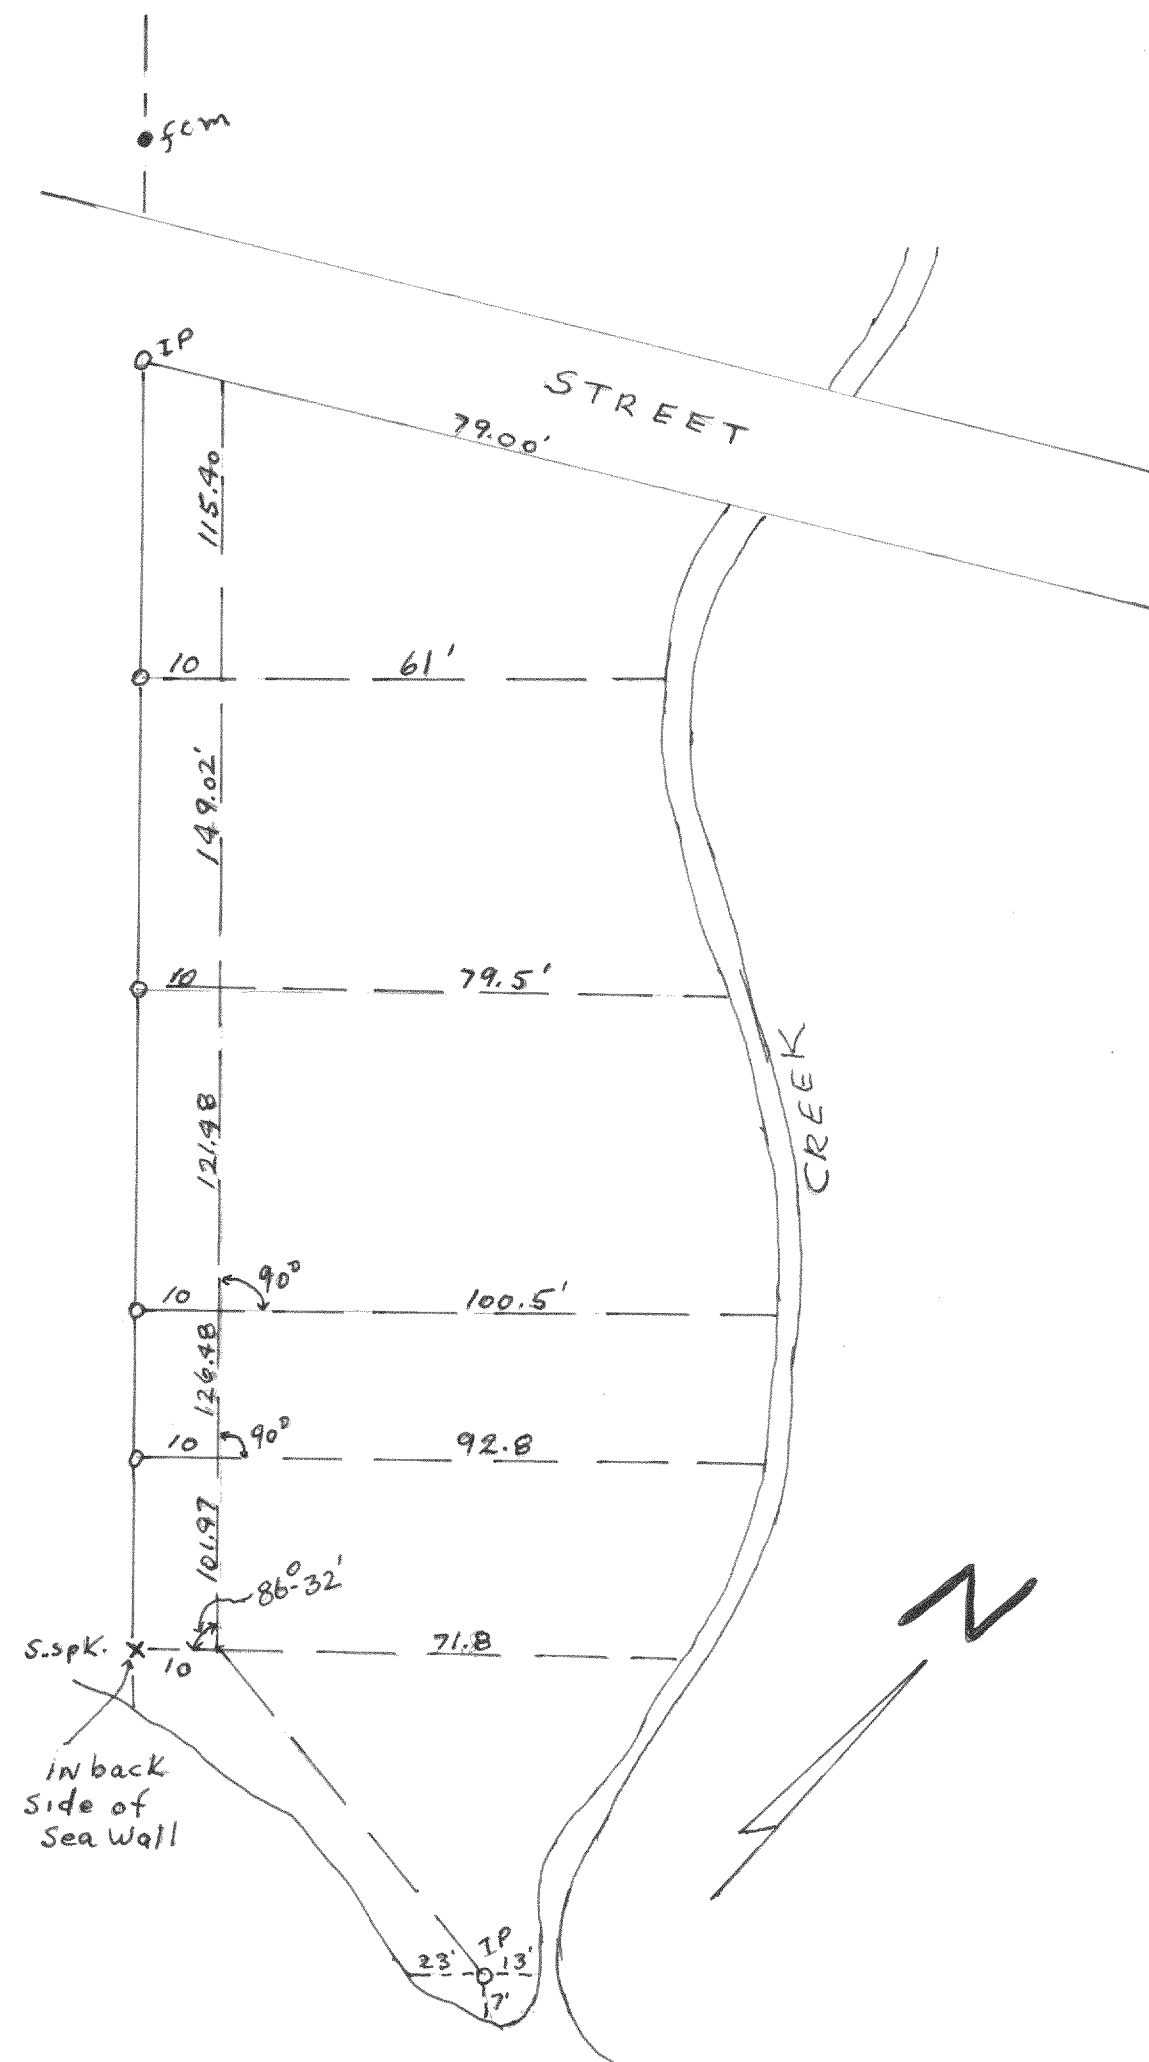

Plat of SURVEY of Lot 6 and part
 of Lot 5 of The Gardens in the
 Village of Fontana.
 Oct. 1963

Lloyd Jensen
 County Surveyor