


#4390 PLAT OF SURVEY  
OF  
LOT 139 LAKE GENEVA GOLF HILLS ADD.  
SECTION 31 T2N R18E WAL. CO. WIS.

SEPT 1962

*Lloyd L. Jensen*  
LLOYD L. JENSEN CO. SURVEYOR

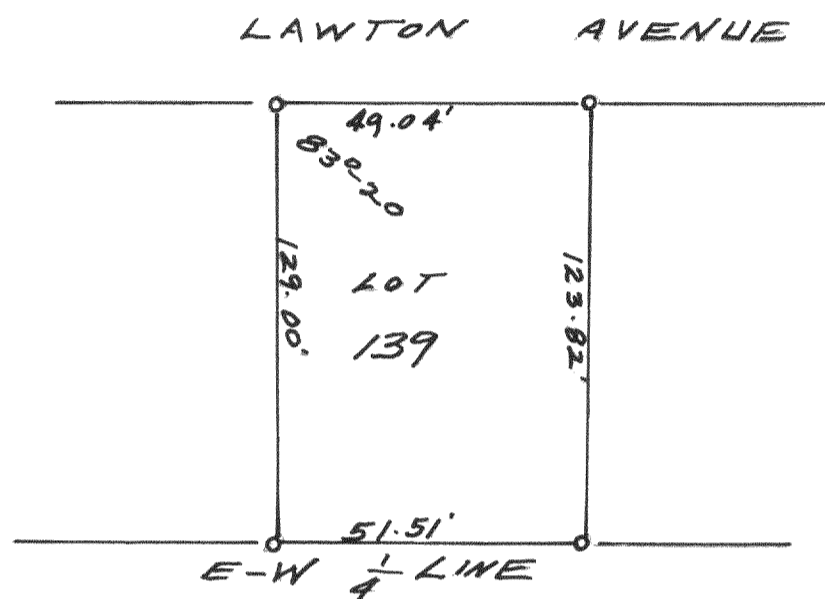


PLAT OF SURVEY  
OF

#4391 NW 1/4 - NW 1/4 SEC 1, T2N R18E  
WAL. CO. WIS.

APRIL 1964


*Lloyd L. Jensen*  
LLOYD L. JENSEN  
CO. SURVEYOR

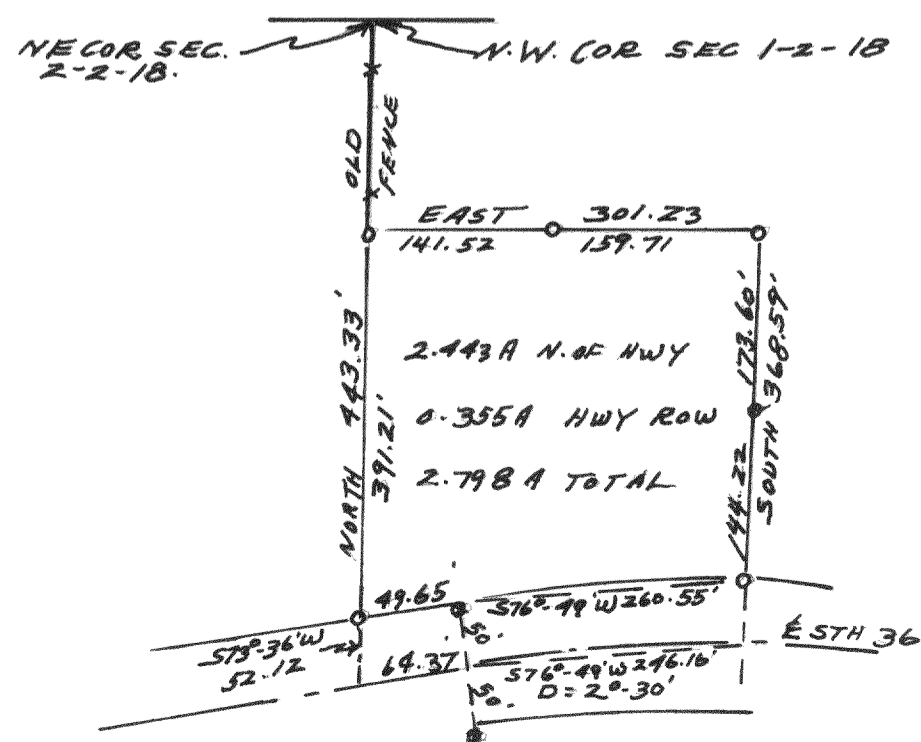

#4392 PLAT OF SURVEY  
OF  
PART OF LOT 19 BLK 2 CAMPBELLS ADD.  
TO LYONS VILLAGE SEC. 10 T2N R18E

OCT 1965

*Lloyd L. Jensen*  
LLOYD L. JENSEN  
CO. SURVEYOR

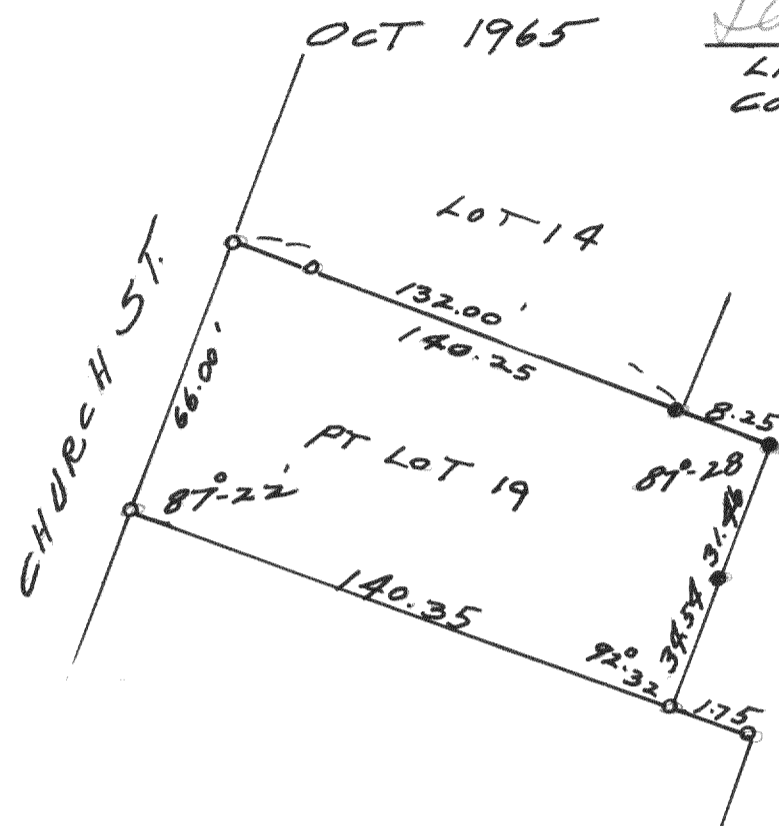

#4393

PLAT OF SURVEY  
OF  
A PARCEL IN THE SE 1/4 OF SEC 18,  
T3N R18E WAL. CO. WIS.  
MAY 1965

*Lloyd L. Jensen*  
CO. SURVEYOR

