


4447

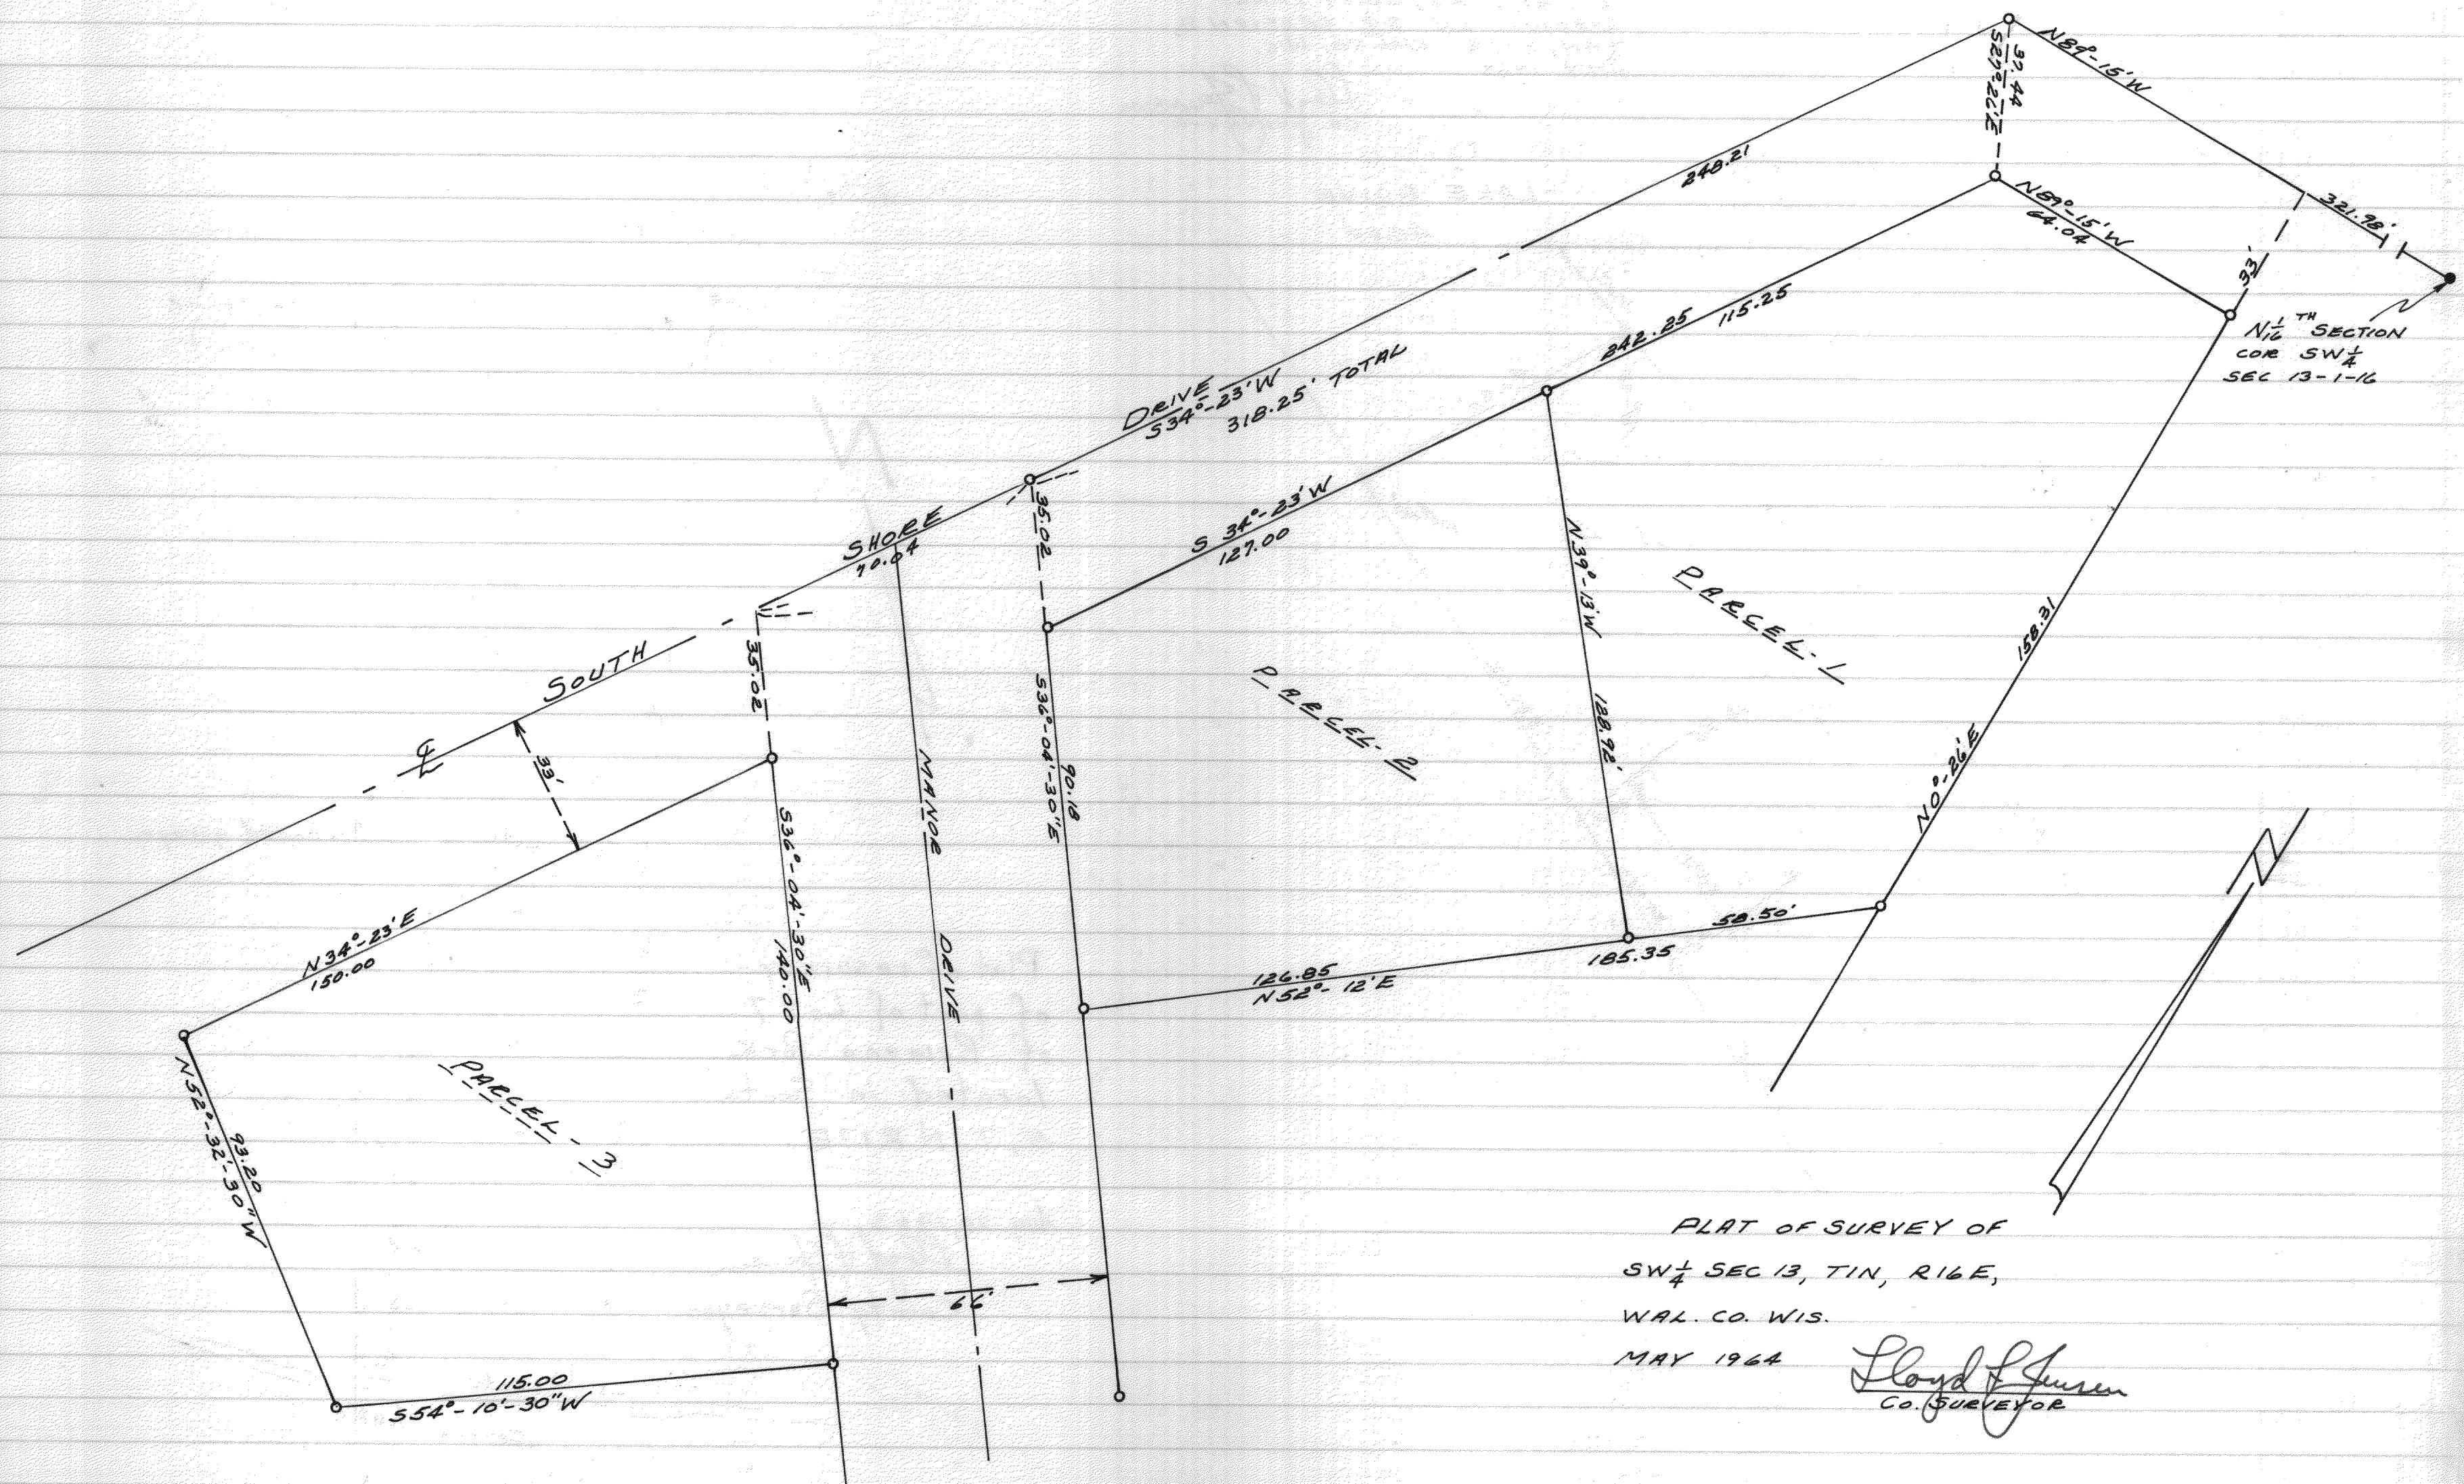

PLAT OF SURVEY OF
 SW $\frac{1}{4}$ SEC 13, T1N, R16E,
 WAL. CO. WIS.
 MAY 1964
 Lloyd Jensen
 CO. SURVEYOR