


#4505

DUNBAR BLVD.

CHAS. YOUNG DRIVE

TUSKEGEE DRIVE

RICHARD CT.

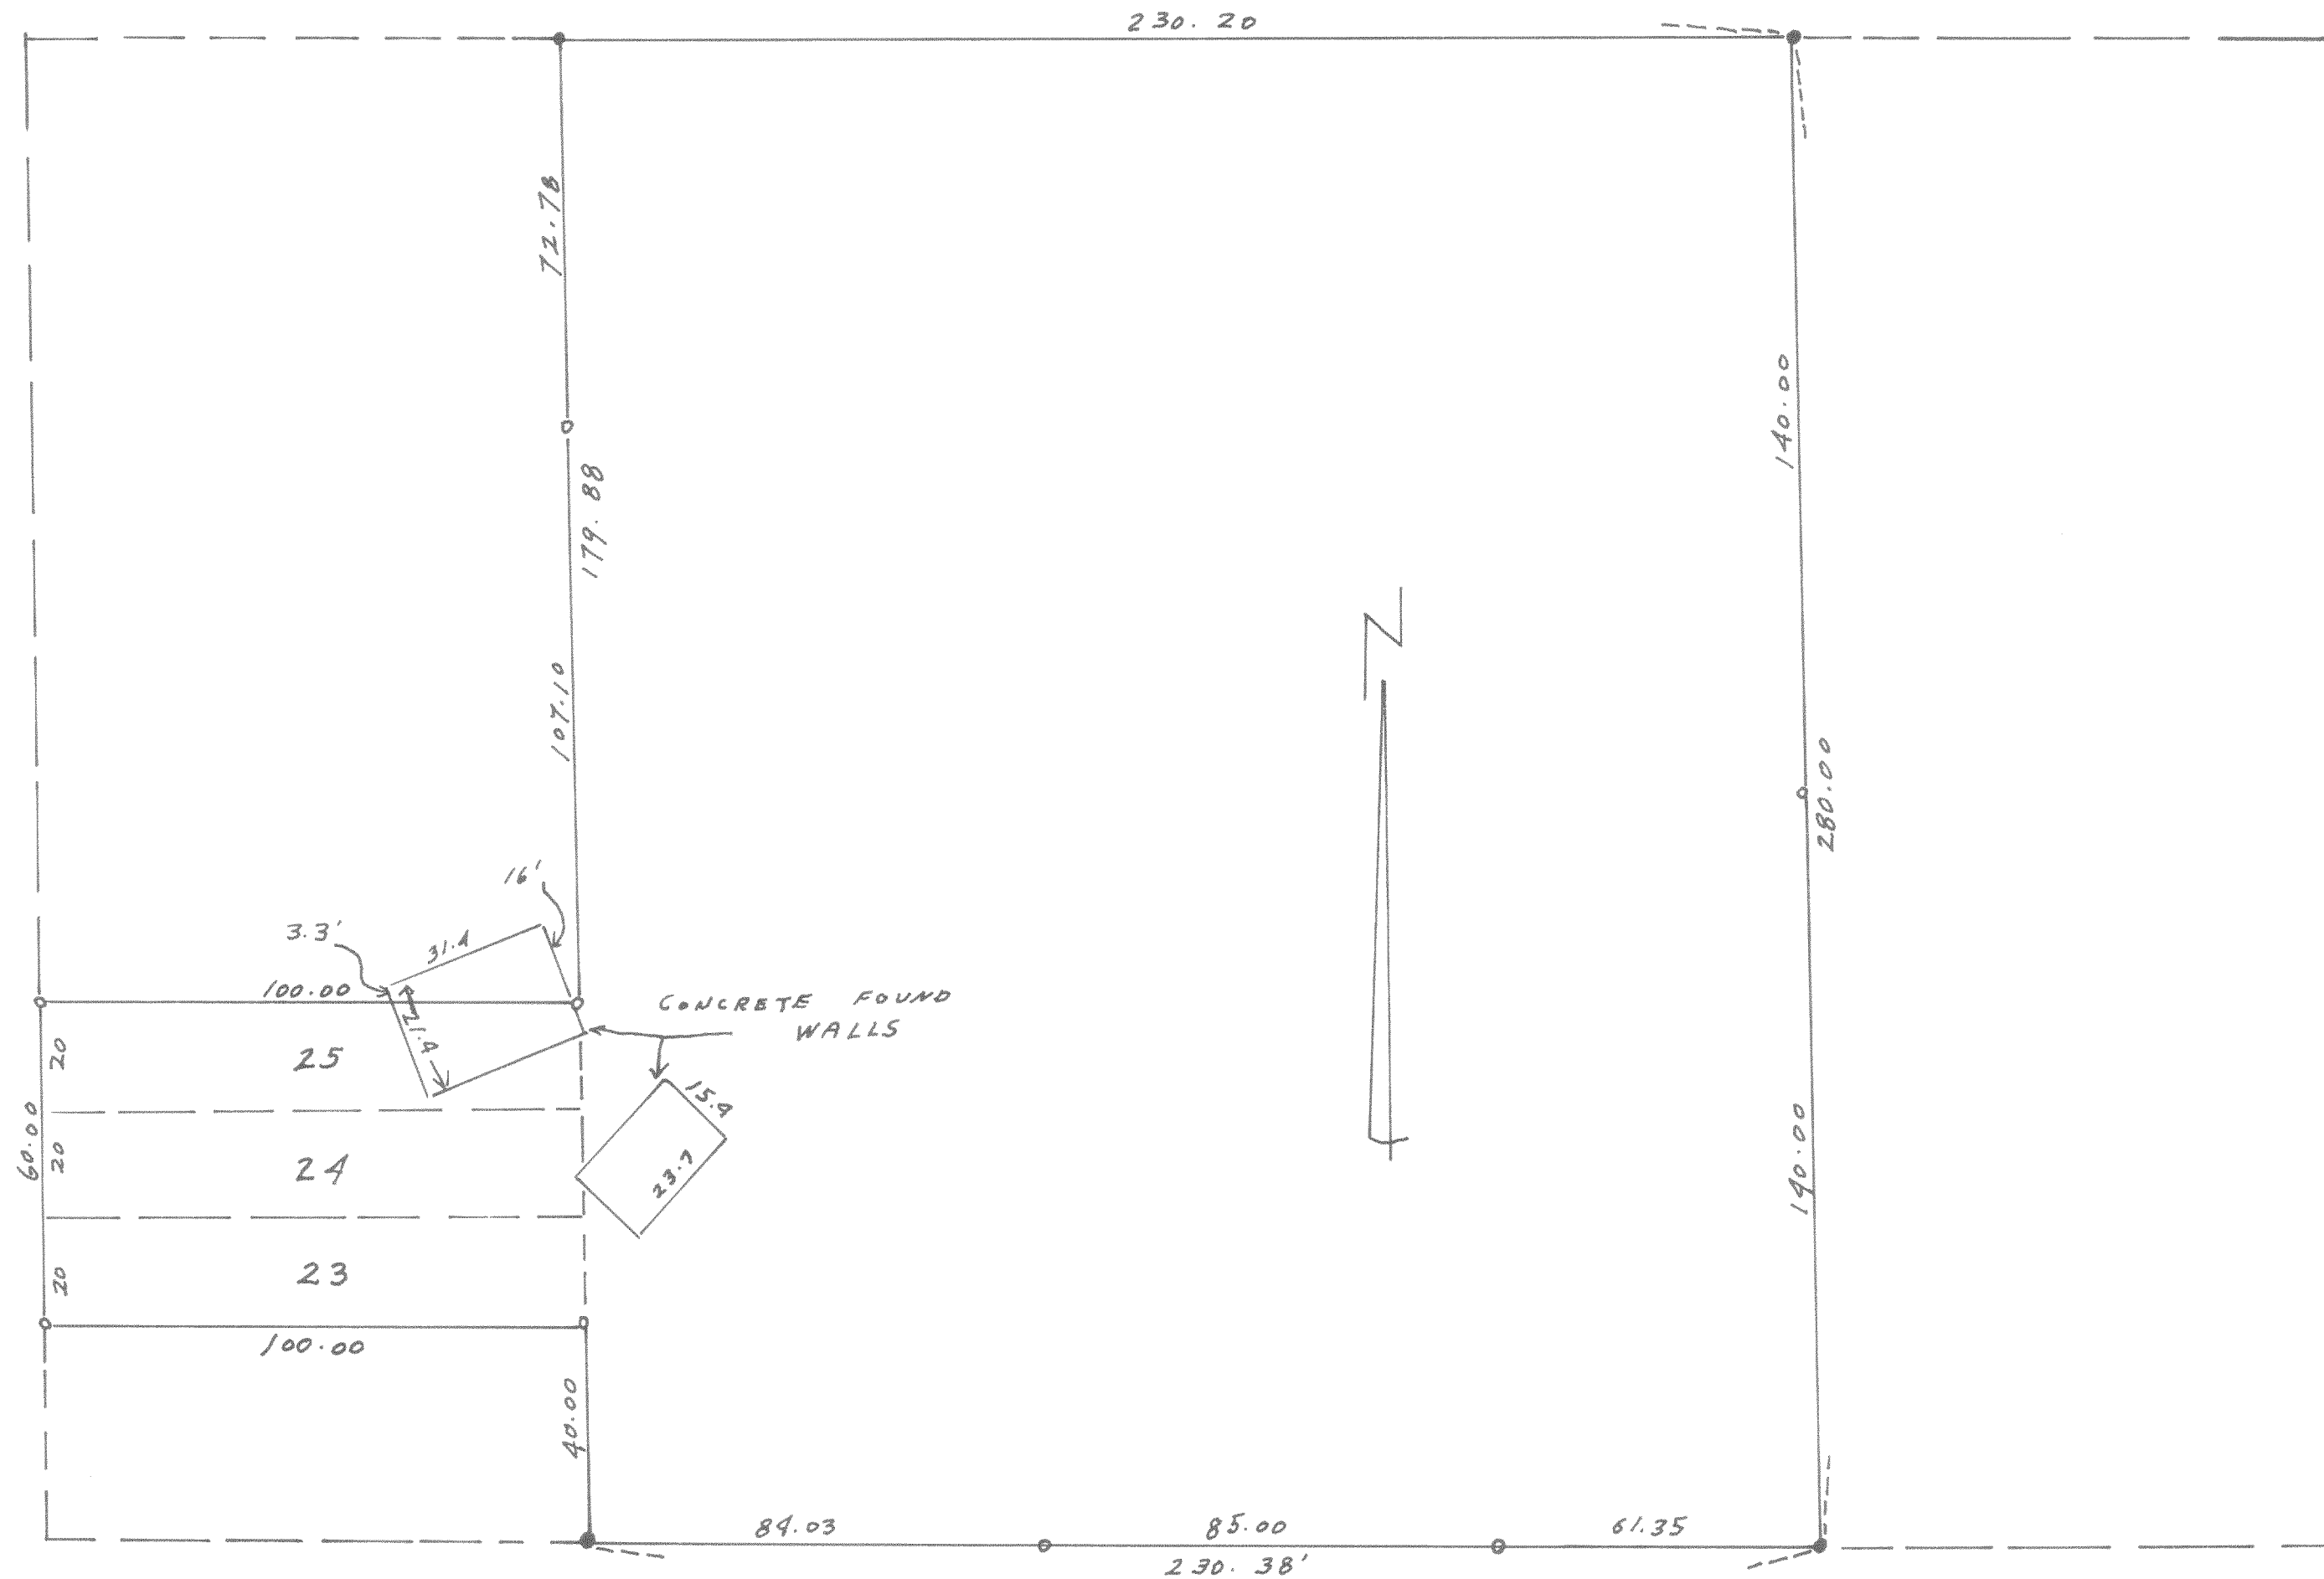

PLAT OF SURVEY OF

LOT 20-23-24-25 BLOCK A
 LAKE IVANHOE RESORT
 SECTION 2, T1N-R18E
 WALWORTH COUNTY, WIS.
 JULY 18, 1966

Raymond L. Jensen
 SURVEYOR