




2905
 Plat of Survey of Lots 6-7, Block 14
 Glenwood Springs Village of Fontana-on-
 Geneva Lake, Walworth County, Wis
 Aug 1954
 Lloyd L Jones
 Surveyor

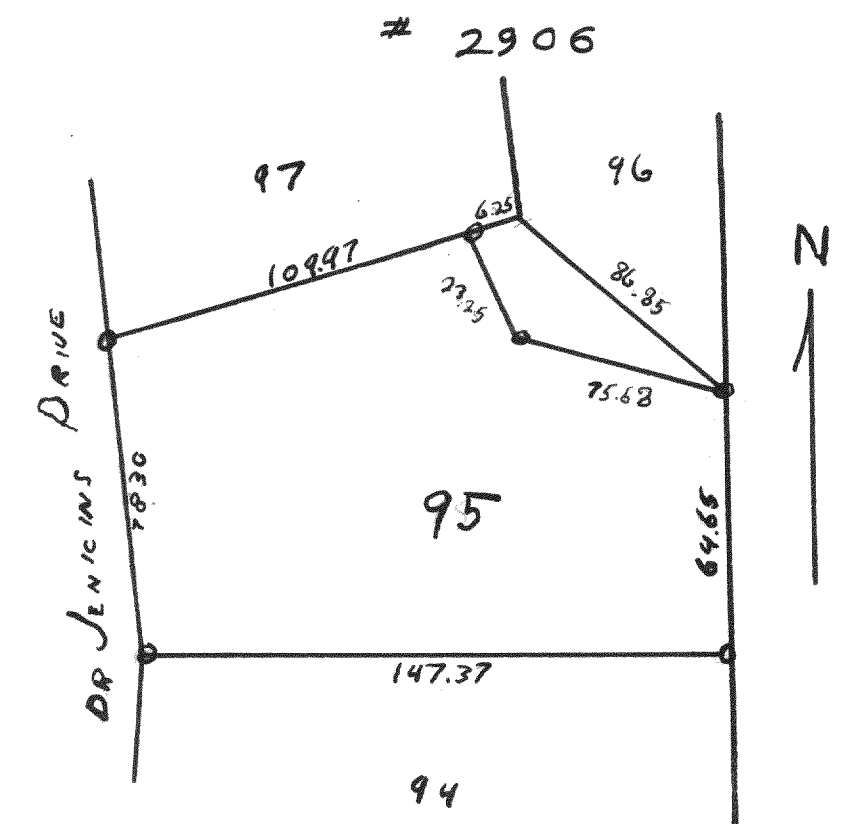


2906
 Plat of Survey of Lot 95 Unit II
 Country Club Estates Village of Fontana
 on Geneva Lake Walworth County Wisconsin
 Oct 1954
 LLJ
 CS

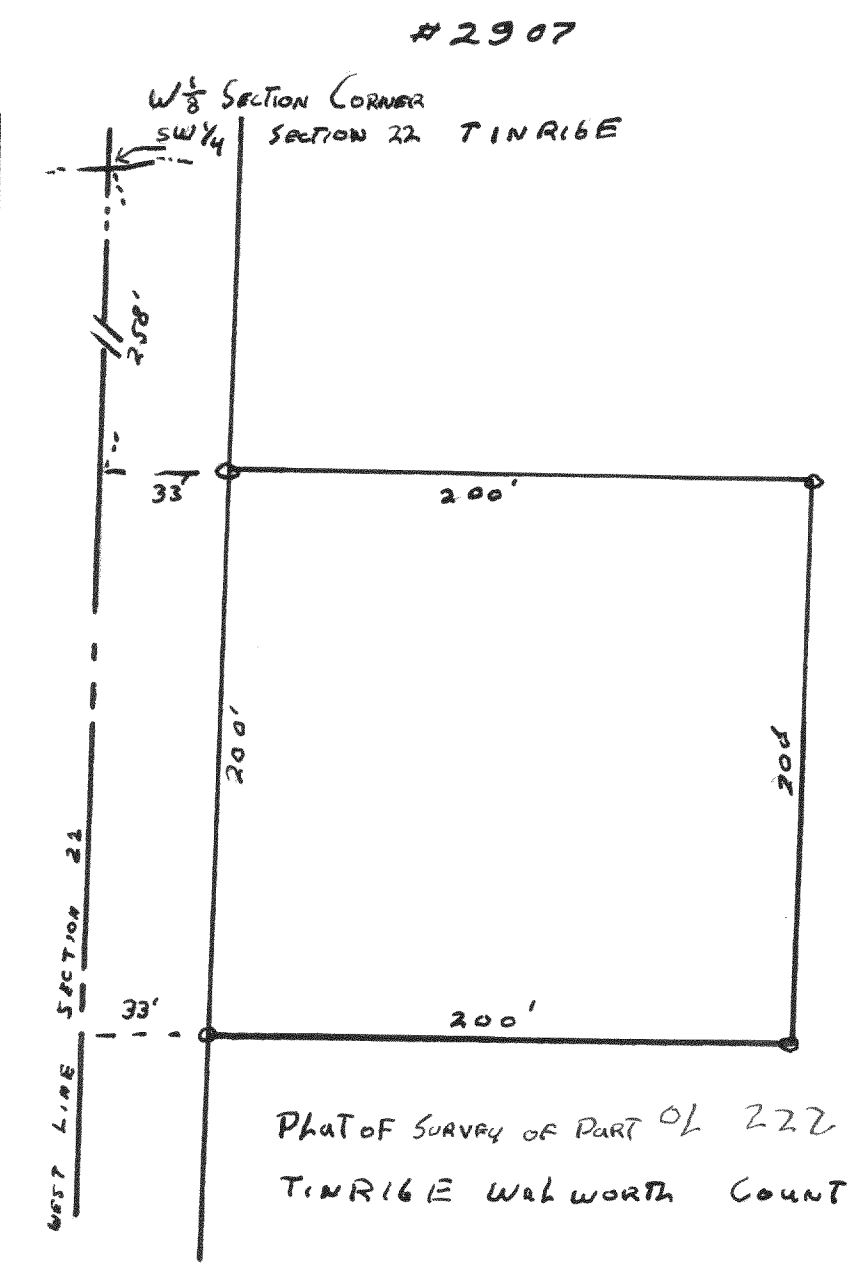

2907
 Plat of Survey of Part of 222 Viccafair
 Walworth County Wisconsin
 1954

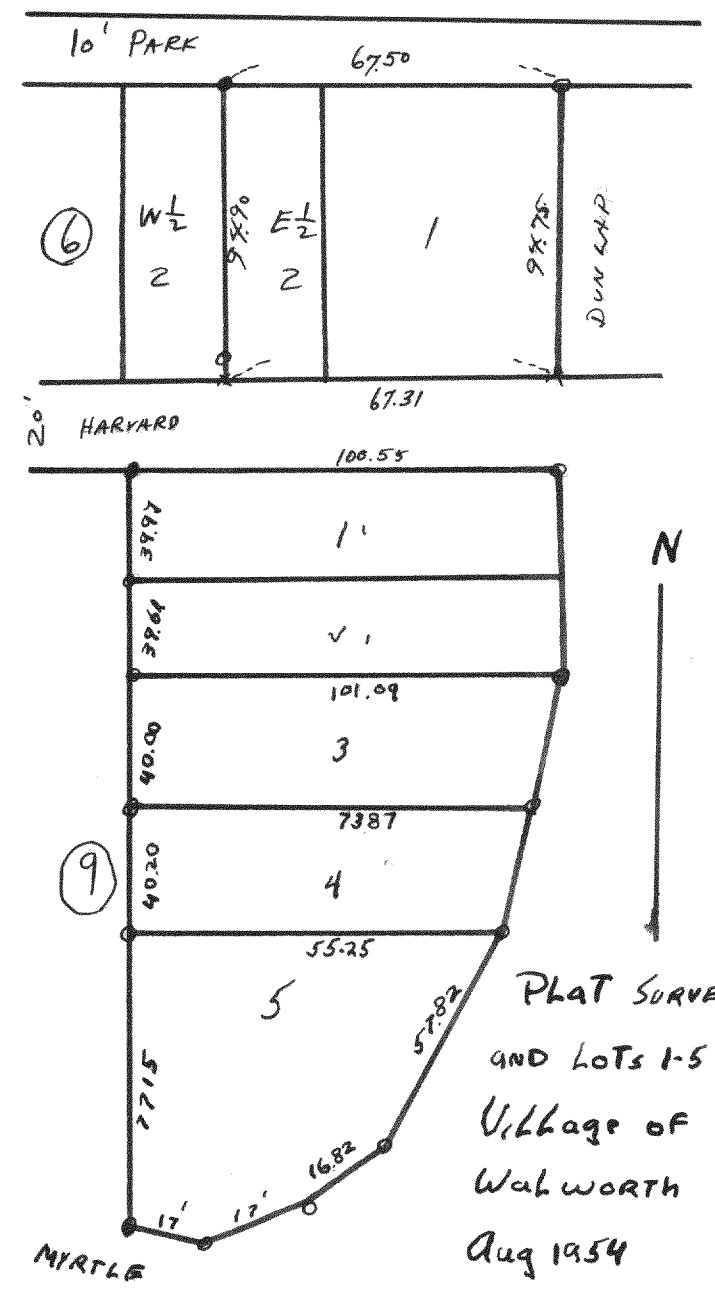

2908
 Plat Survey of Lot 1 and E 1/2 Cor 2 Block 6
 and Lots 1-5 Block 9 Glenwood Springs
 Village of Fontana Geneva Lake
 Walworth County Wisconsin
 Aug 1954
 LLJ
 CS

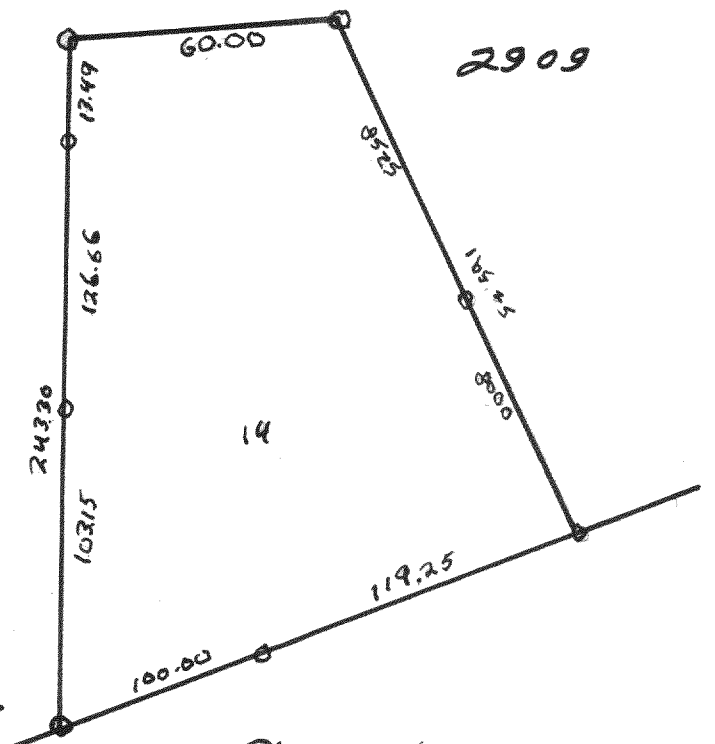

2909
 Plat of Survey of Lot 14 Unit #1
 Country Club Estates Village of Fontana
 on Geneva Lake Walworth County Wisconsin
 October 1954
 LLJ
 CS