



#2916

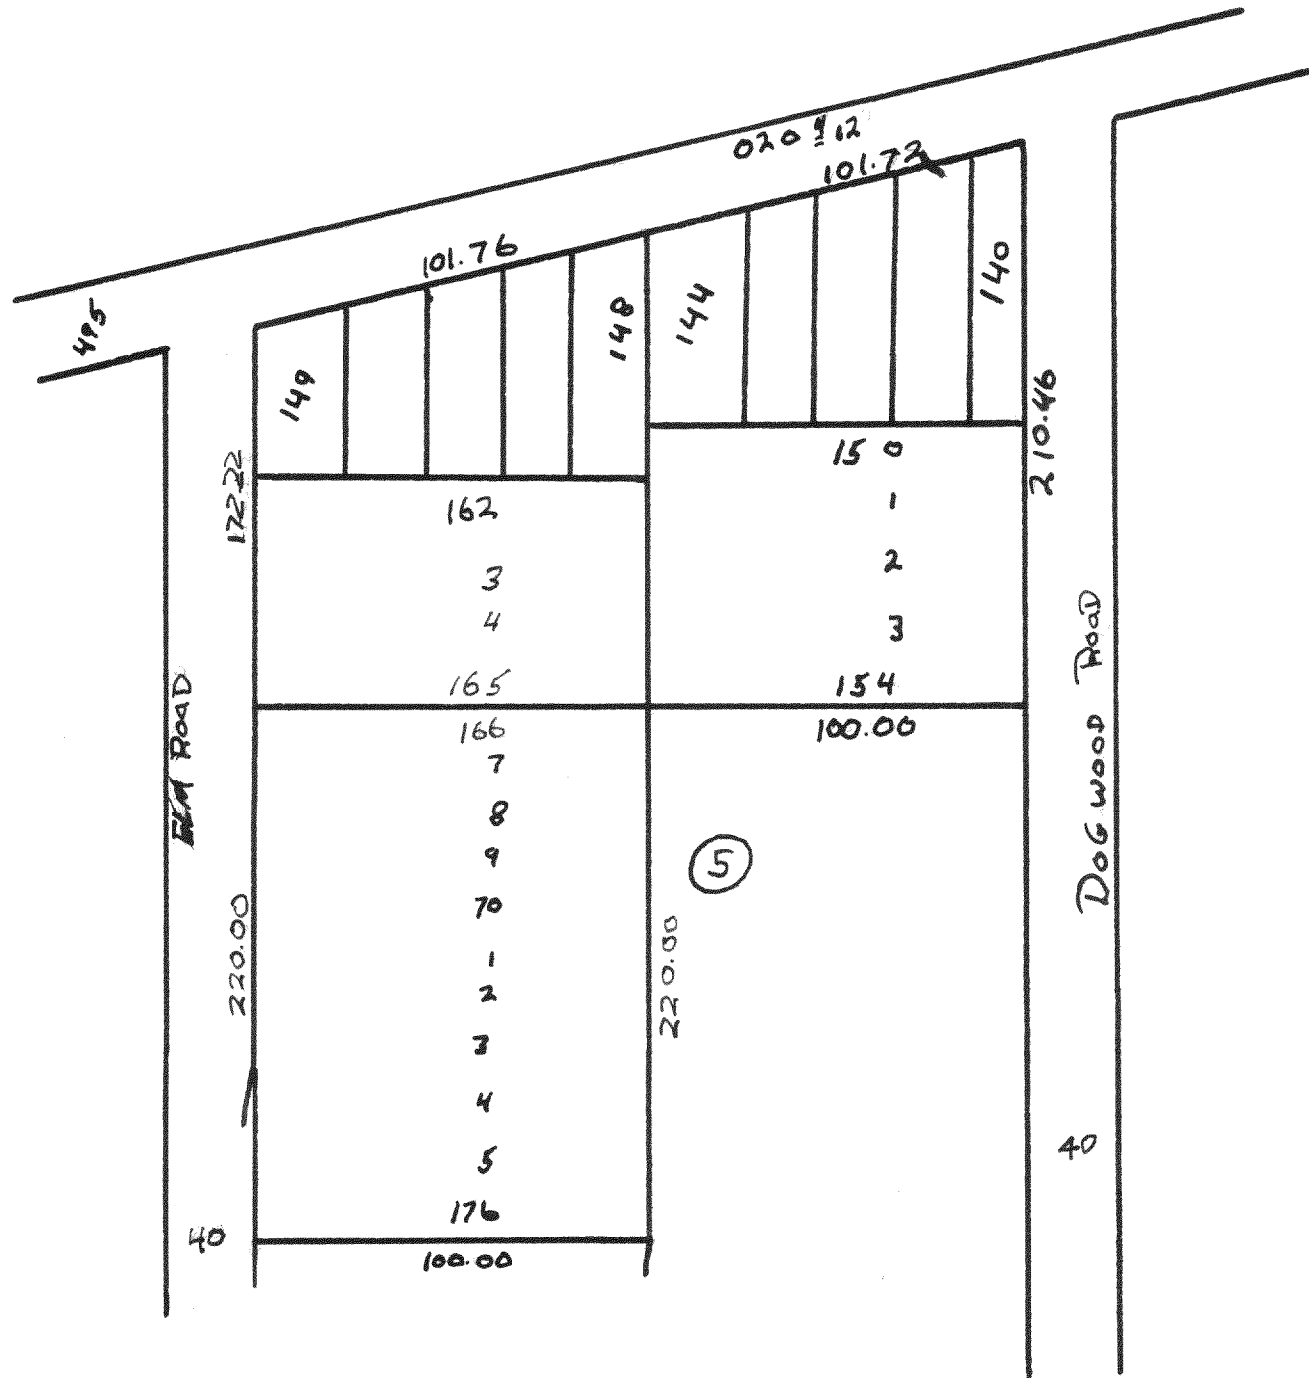


Plat of Survey of Lots 140-154 x 162-176
 Block 5 Lake Como Beach T3N R1E
 Walworth County Wisconsin
 April 34 LLJ CS

Plat of Survey of Land E 1/2 NE 1/4
 Section 28 T3N R1E Walworth
 County Wisconsin
 May 1954 LLJ CS

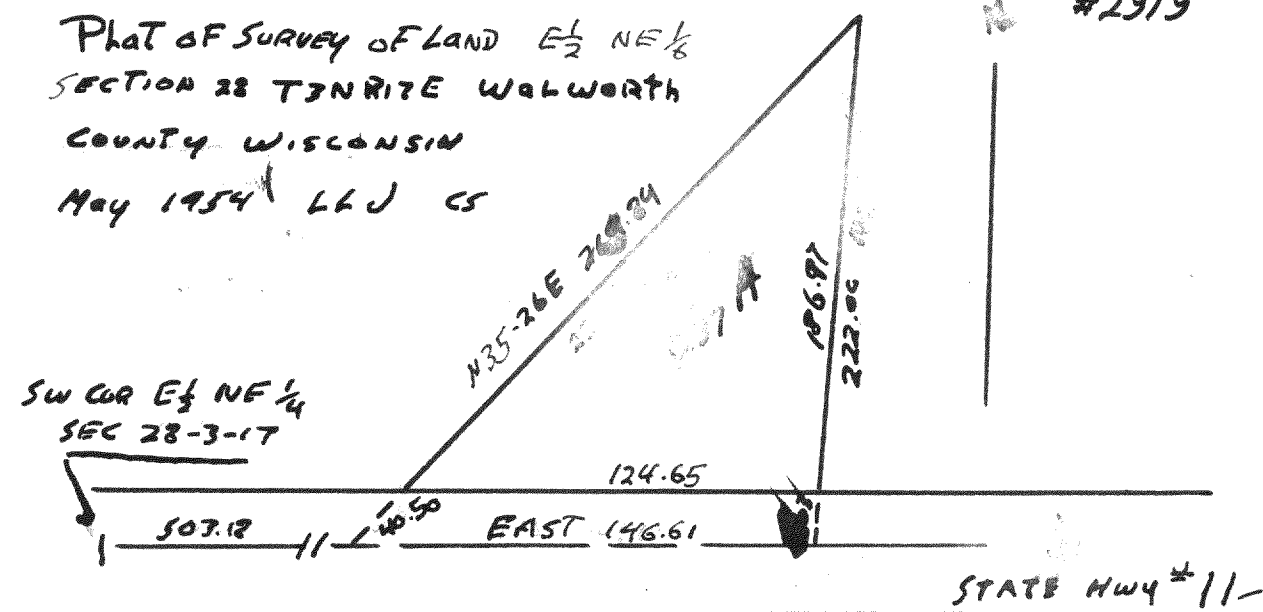


#2917

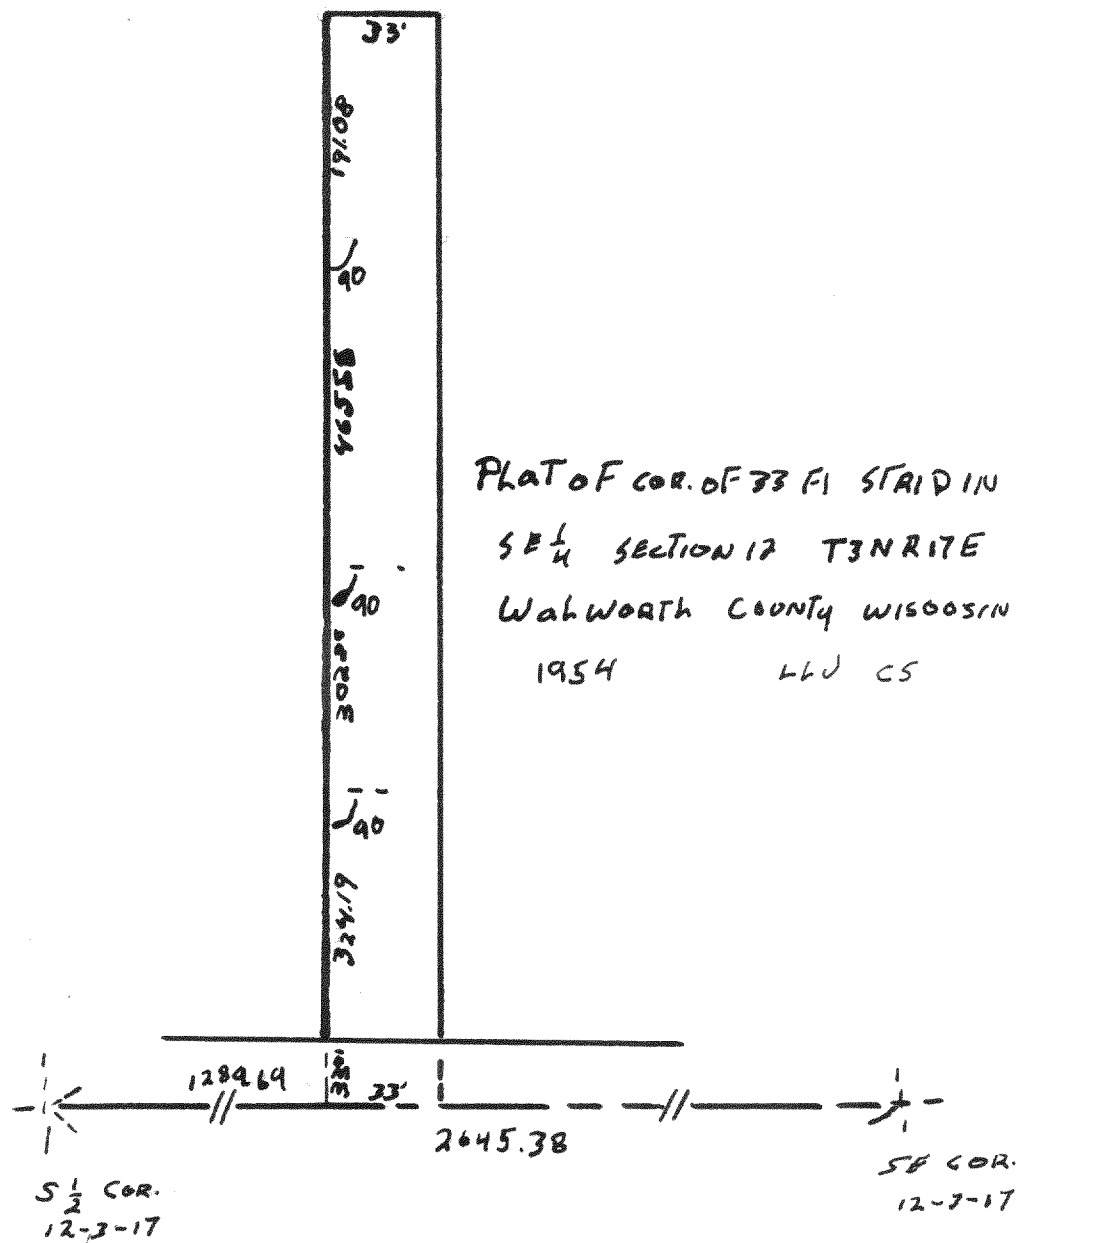

PLAT OF COR. OF 33 FT STRIP IN
 SE 1/4 SECTION 17 T3N R1E
 Walworth County Wisconsin
 1954 LLJ CS


NORTH 1/4 Sec Cor.
 SECTION 7 T3N R1E

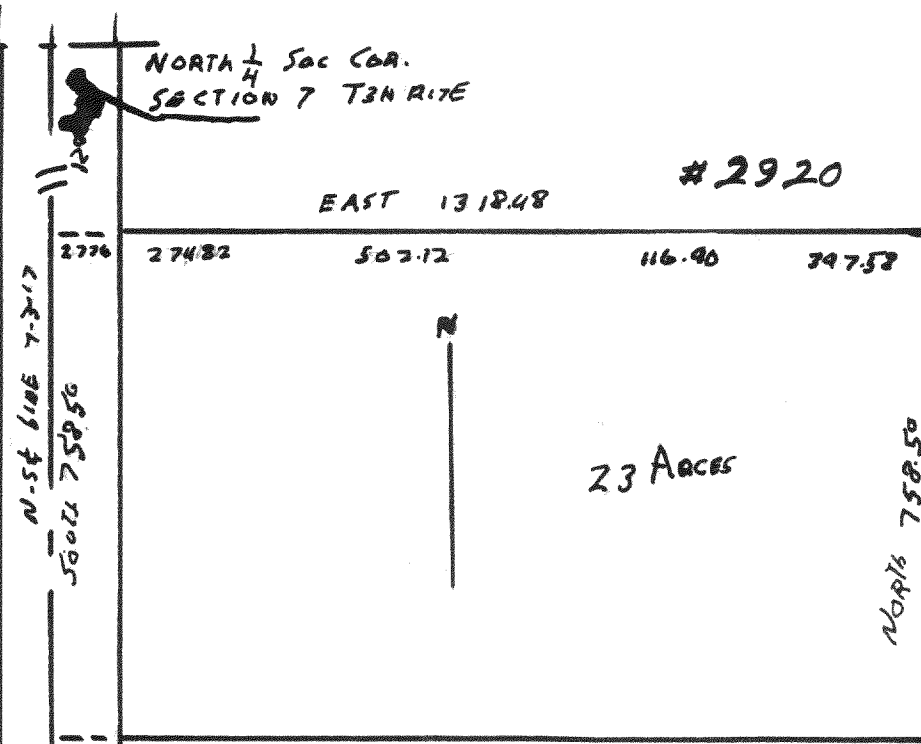

Plat of Survey of Land in W 1/2 of NE 1/4 SECTION 7
 T3N R1E Walworth County Wisconsin
 Aug 1954 LLJ CS

#2918

Booth Lake

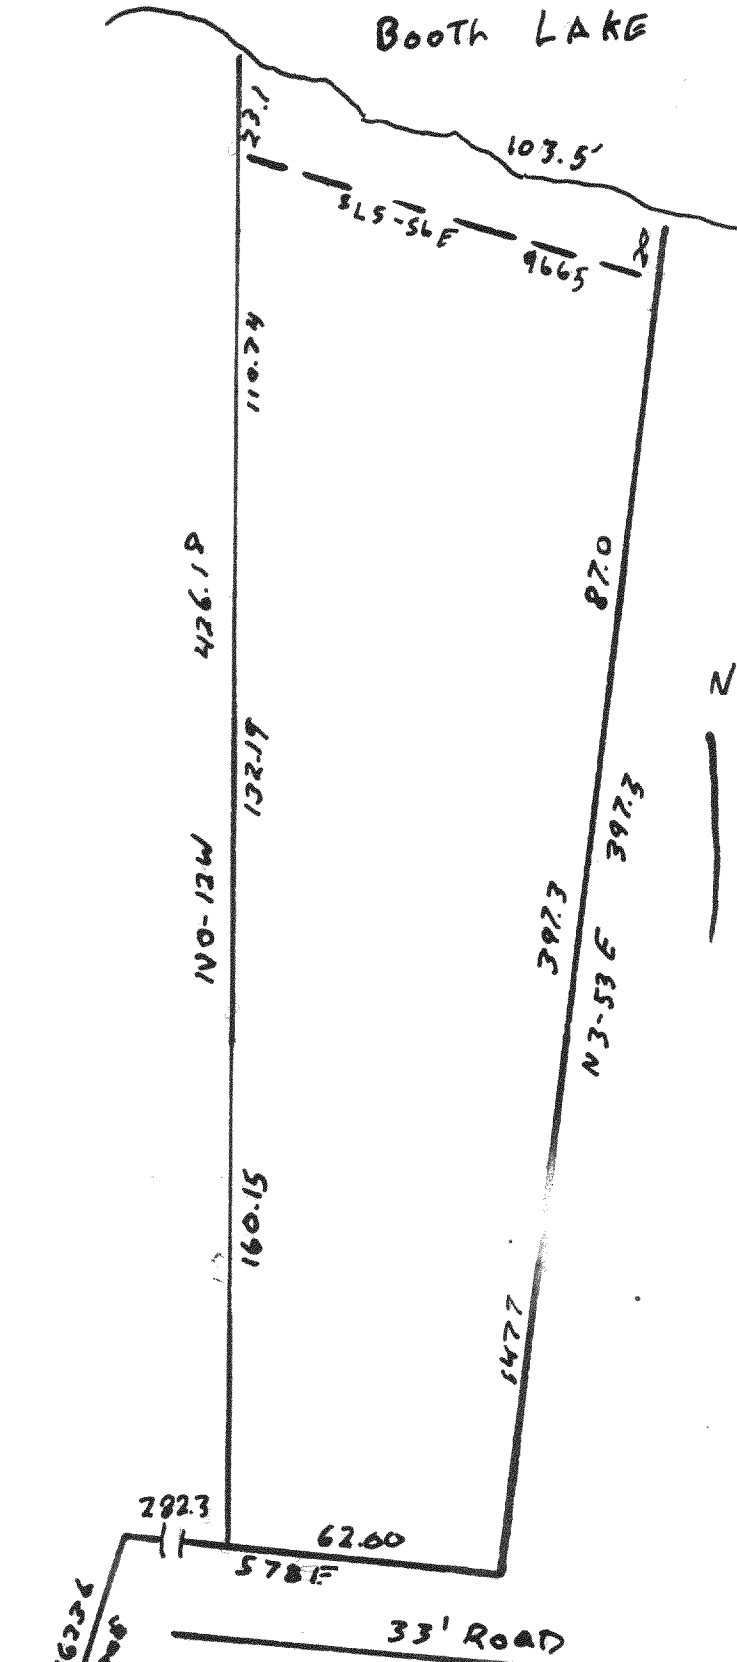

Plat of Survey of Land in
 NE 1/2 SECTION 24 T4N R1E
 Walworth County Wisconsin
 June 1954 LLJ CS