


4561

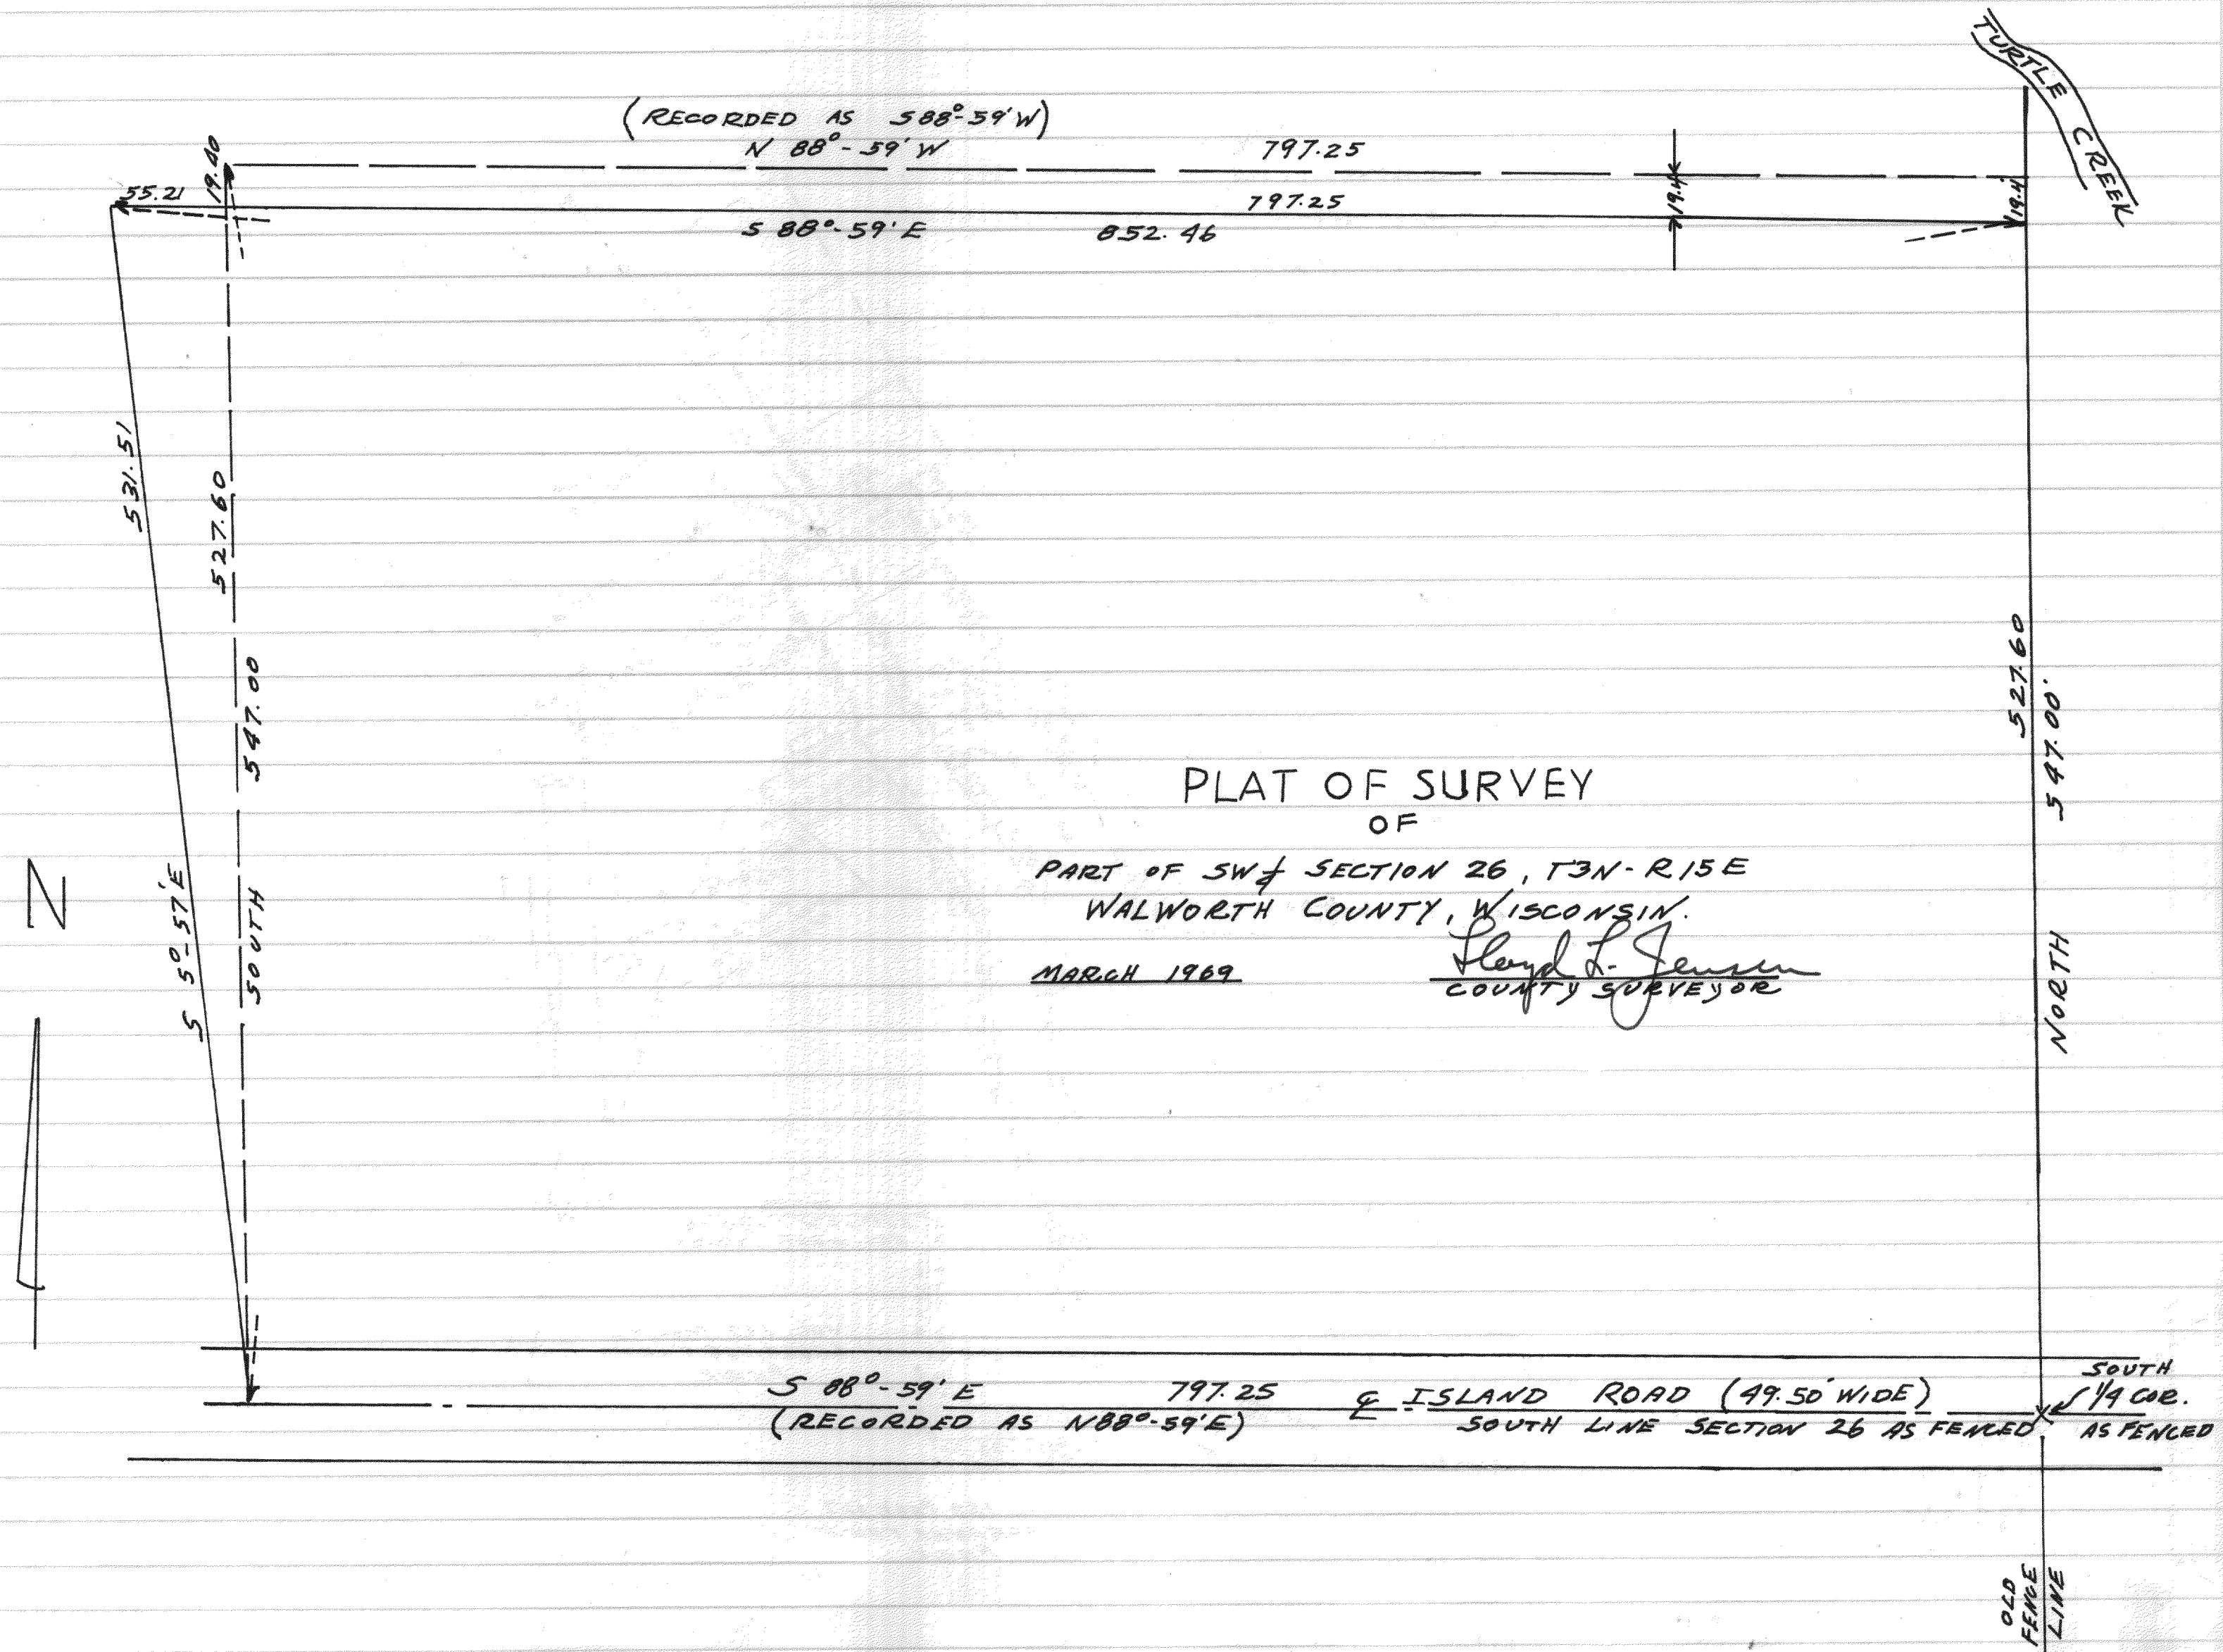

PLAT OF SURVEY
OF

PART OF SW 1/4 SECTION 26, T3N-R15E
WALWORTH COUNTY, WISCONSIN.

MARCH 1969

Floyd L. Jensen
COUNTY SURVEYOR

