



#2933

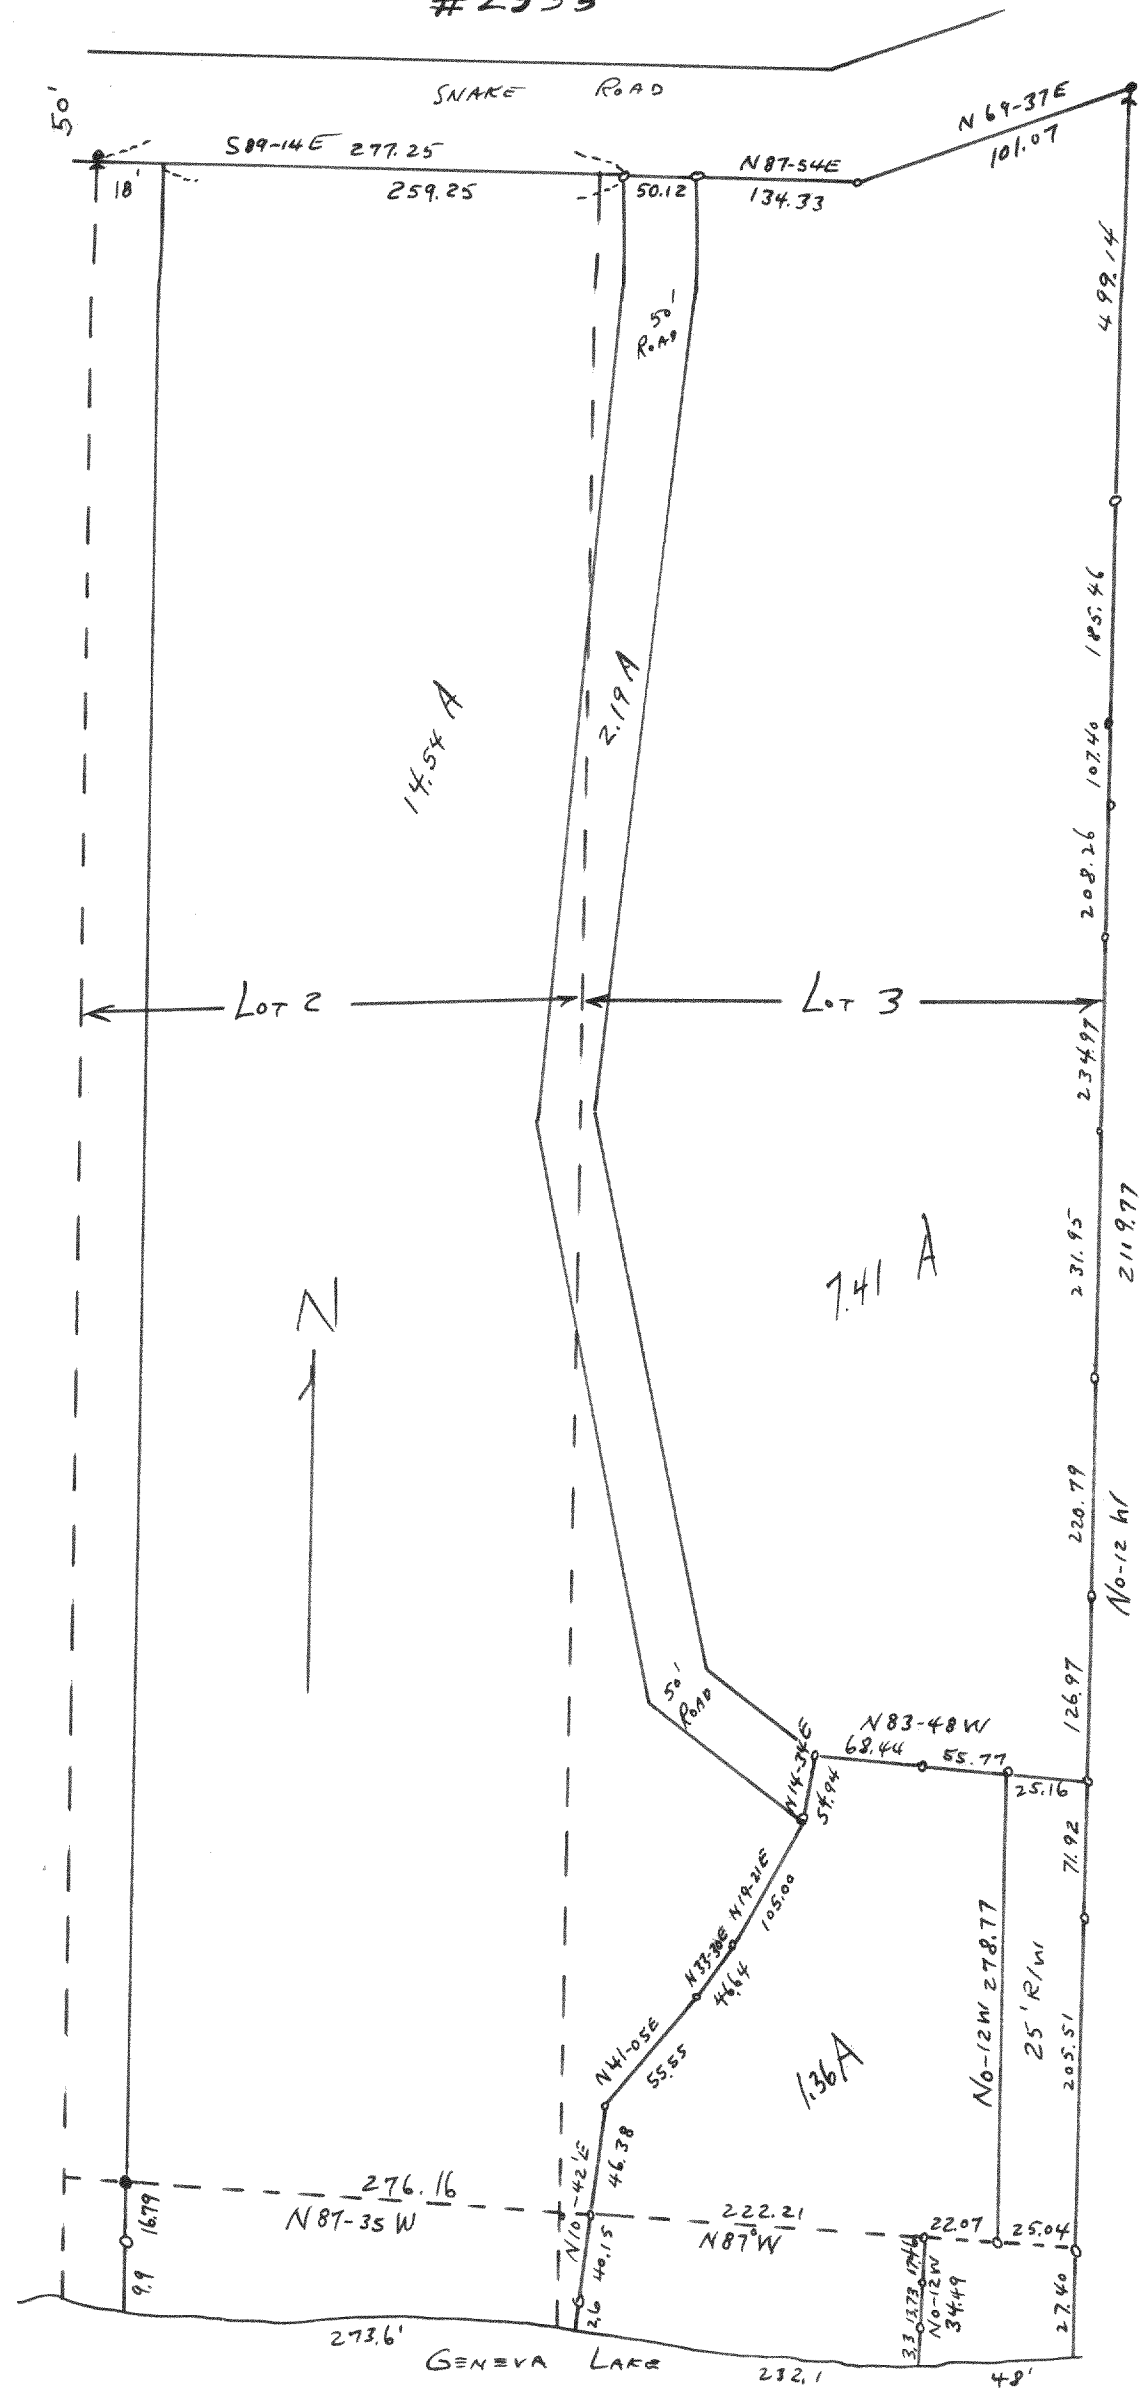

PLAT OF SURVEY OF LOTS 2-3 OF MALLORY SPRINGS SUB IN GOLF LOT 3
 & SECT 3 TINRITE, WALWORTH COUNTY, WISCONSIN
 September 1954
 Lloyd J. Jensen
 County Surveyor


71

#2934

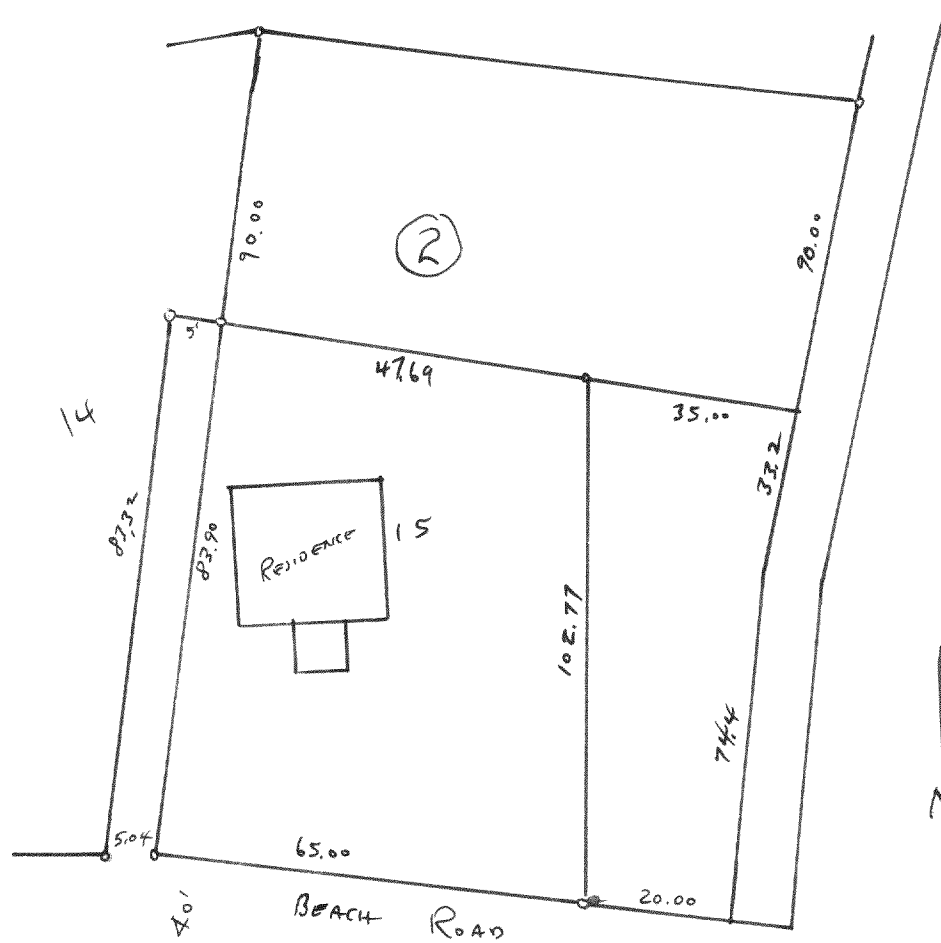


PLAT OF SURVEY OF PART OF LOTS 14-15 BLOCK 2
 OF WOODALE LOCATED IN TINRITE WALWORTH COUNTY
 WISCONSIN August 1954
 Lloyd J. Jensen
 County Surveyor

#2935

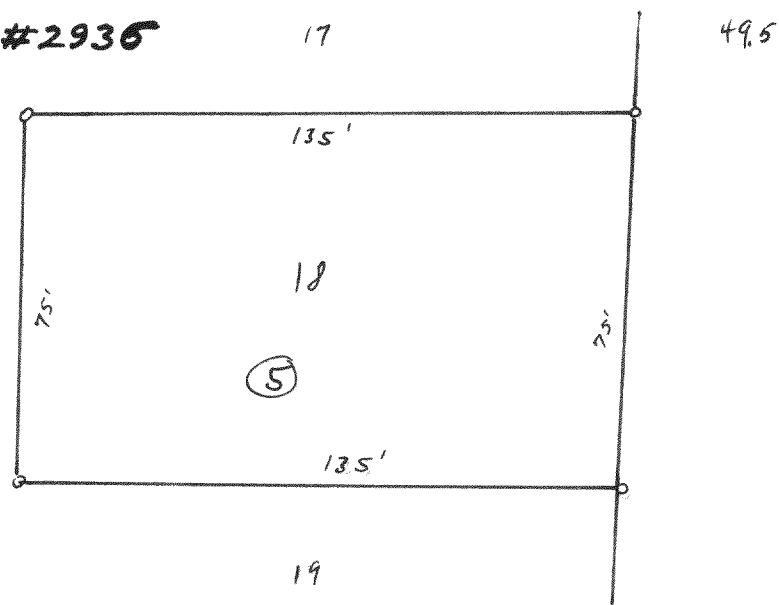

PLAT OF SURVEY OF LOT 18 BLOCK 5
 SUNSET HILLS IN SEC 4 TINRITE
 WALWORTH COUNTY WIS
 MAY 1954
 Lloyd J. Jensen
 County Surveyor

#2935

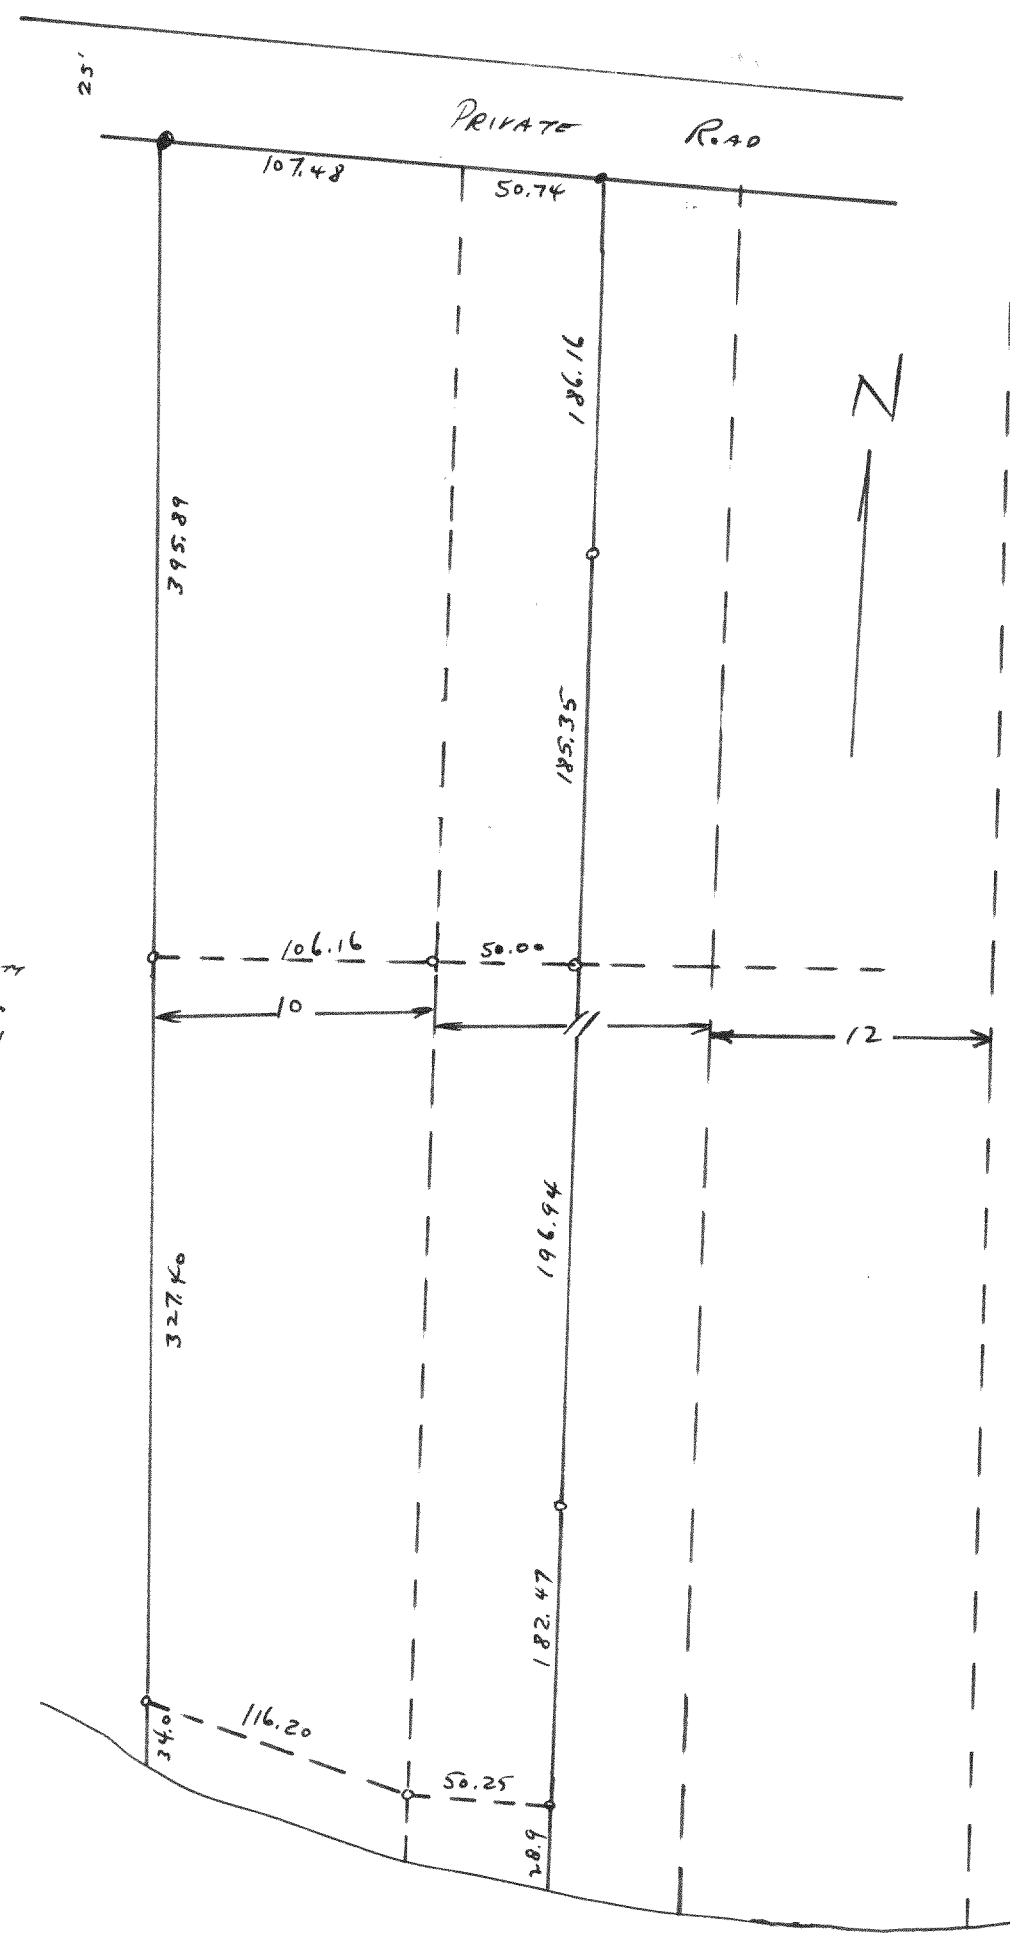

GENEVA LAKE
 PLAT OF SURVEY OF LOT 10 AND WEST 50' OF LOT 11 OF S.B. CHAPIN SUB
 IN FC SEC 4, TINRITE WALWORTH COUNTY, WISCONSIN
 MAY 1954
 Lloyd J. Jensen
 County Surveyor