



#2987

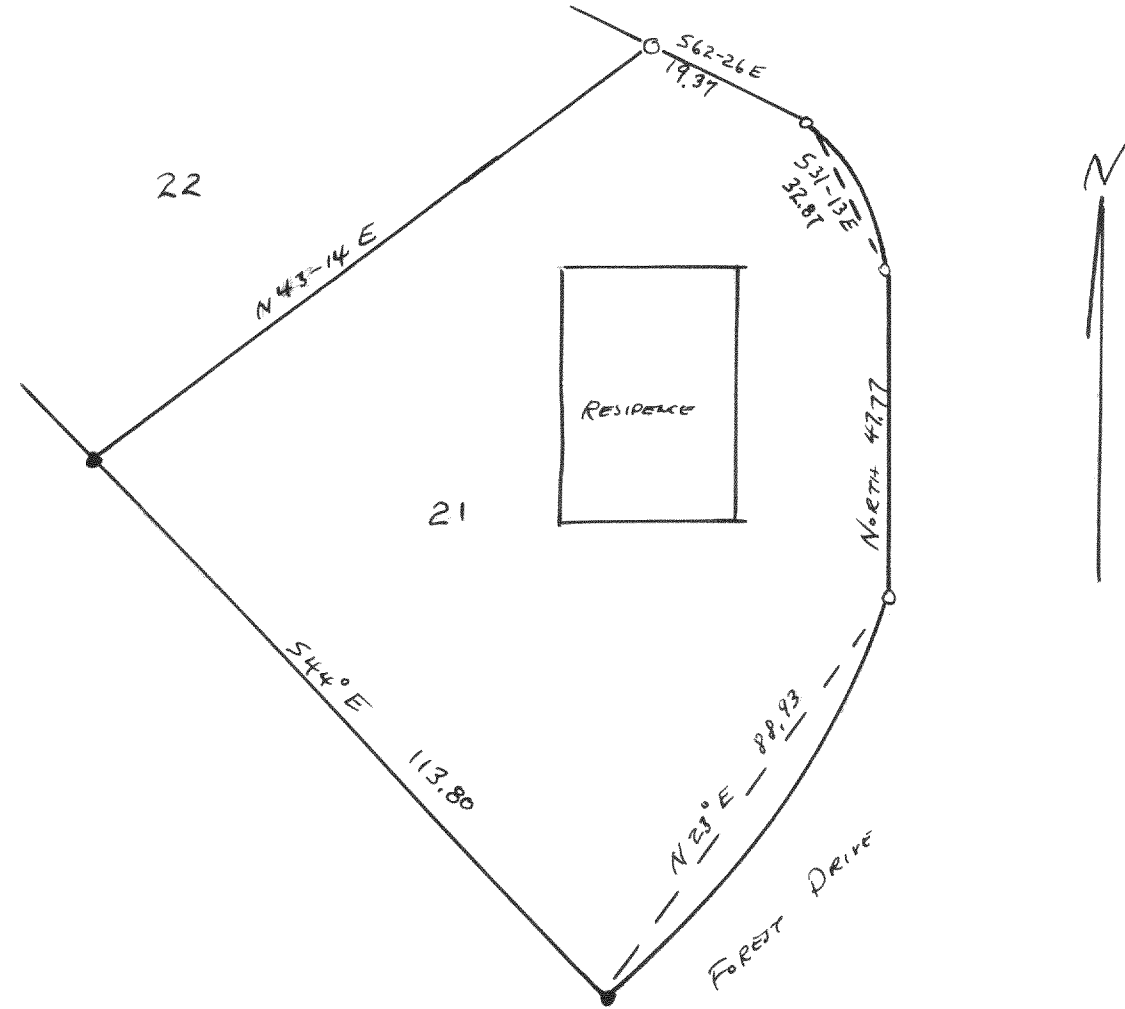

PLAT OF SURVEY OF LOT 21 ADD'N "D" TO COUNTRY CLUB ESTATES
 VILLAGE OF FONTANA OR - GENEVA LAKE
 WALWORTH COUNTY, WISCONSIN
 Nov 1954
 Lloyd J. James
 County Surveyor


For Survey of Addition "E" to
 Country Club Estates Part of O.K. 98
 Village of Fontana, Wisconsin Located in
 Sections 14 & 23, See Volume 12
 pages 101 & 102 in Register of
 Deeds Office, Walworth County, Wisconsin.

#2988

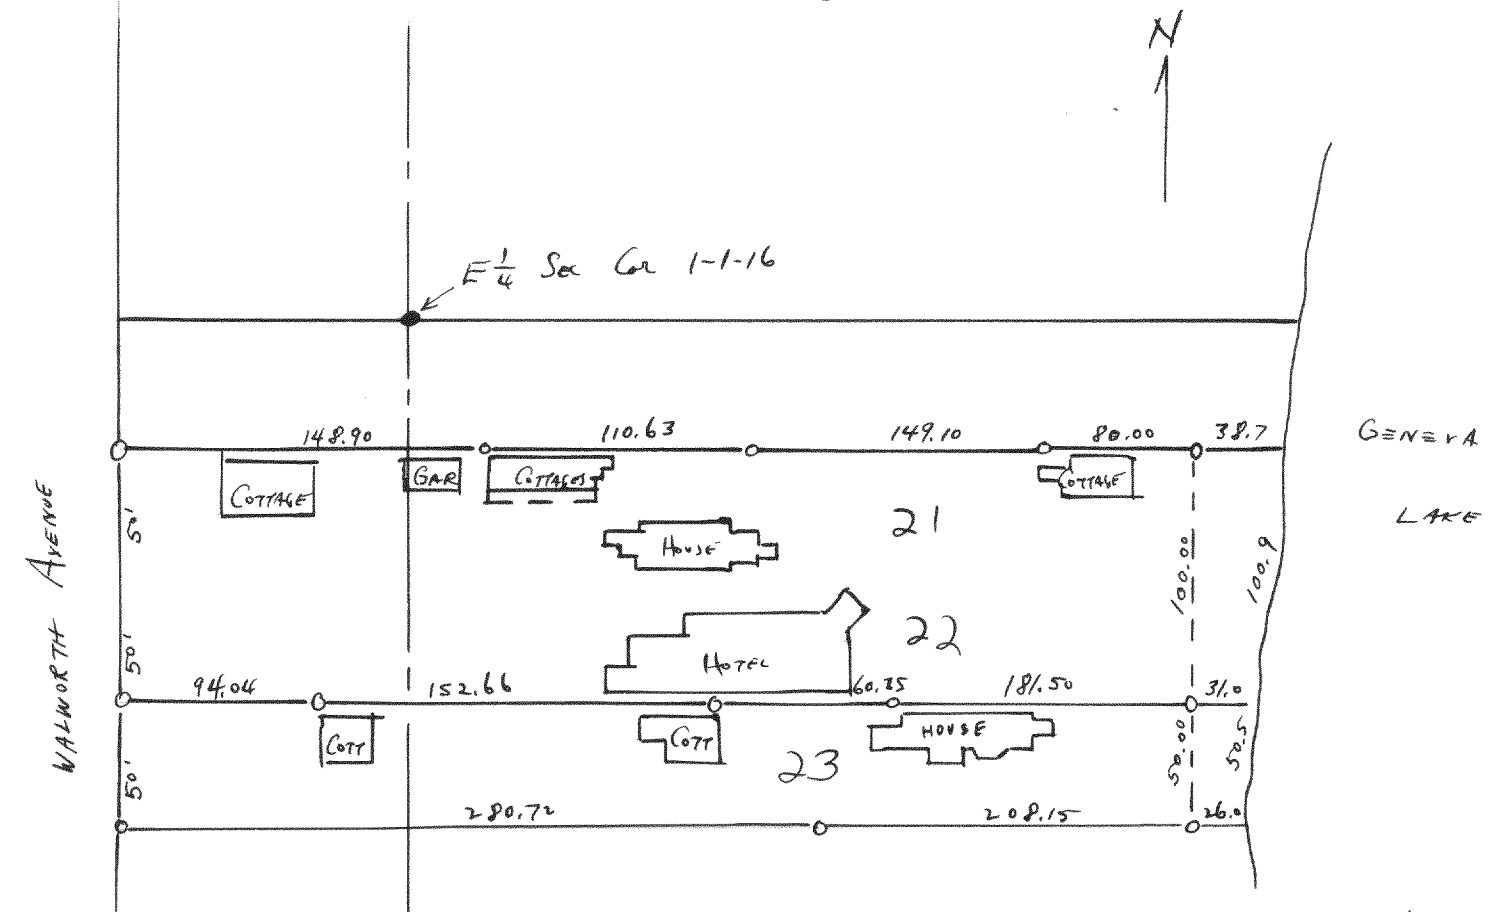

PLAT OF SURVEY OF LOTS 21-23, BLOCK 7 OF WILLIAMS THIRD ADD'N
 VILLAGE OF WILLIAMS BAY, WALWORTH COUNTY, WIS
 Dec 1954
 Lloyd J. James
 County Surveyor

#2989

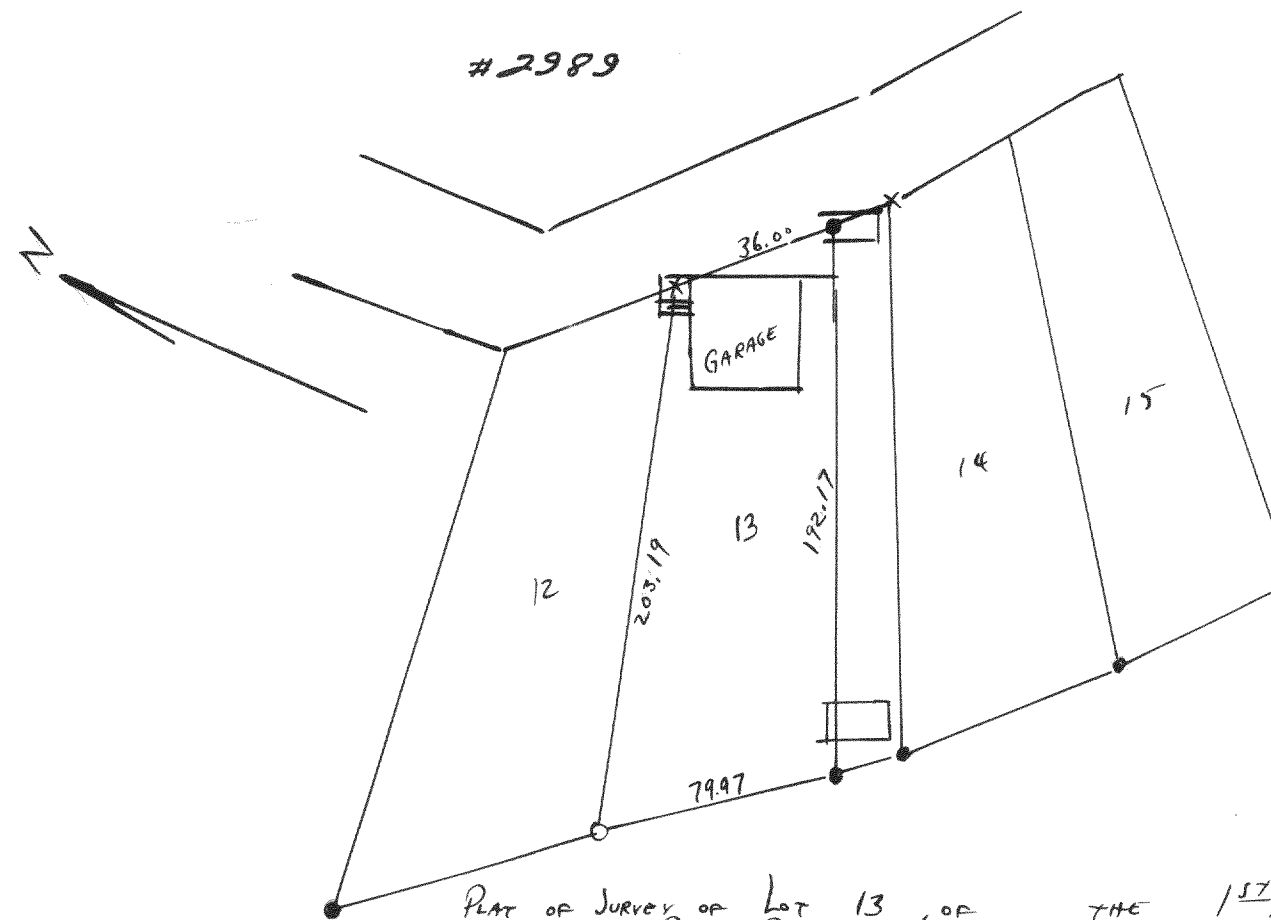

PLAT OF SURVEY OF LOT 13 OF THE 1ST ADDITION
 TO CEDAR POINT PARK, VILLAGE OF WILLIAMS BAY,
 WALWORTH COUNTY, WIS
 Oct 1954
 Lloyd J. James
 County Surveyor