


PLAT OF SURVEY OF  
PART OF LOT 27 MILLSITE  
SUB. NW $\frac{1}{4}$  SECTION 4, T4N  
R18E, WAL. CO. WISCONSIN

JULY 1967



*Floyd L Jensen*  
*Lloyd L JENSEN N*  
COUNTY SURVEYOR

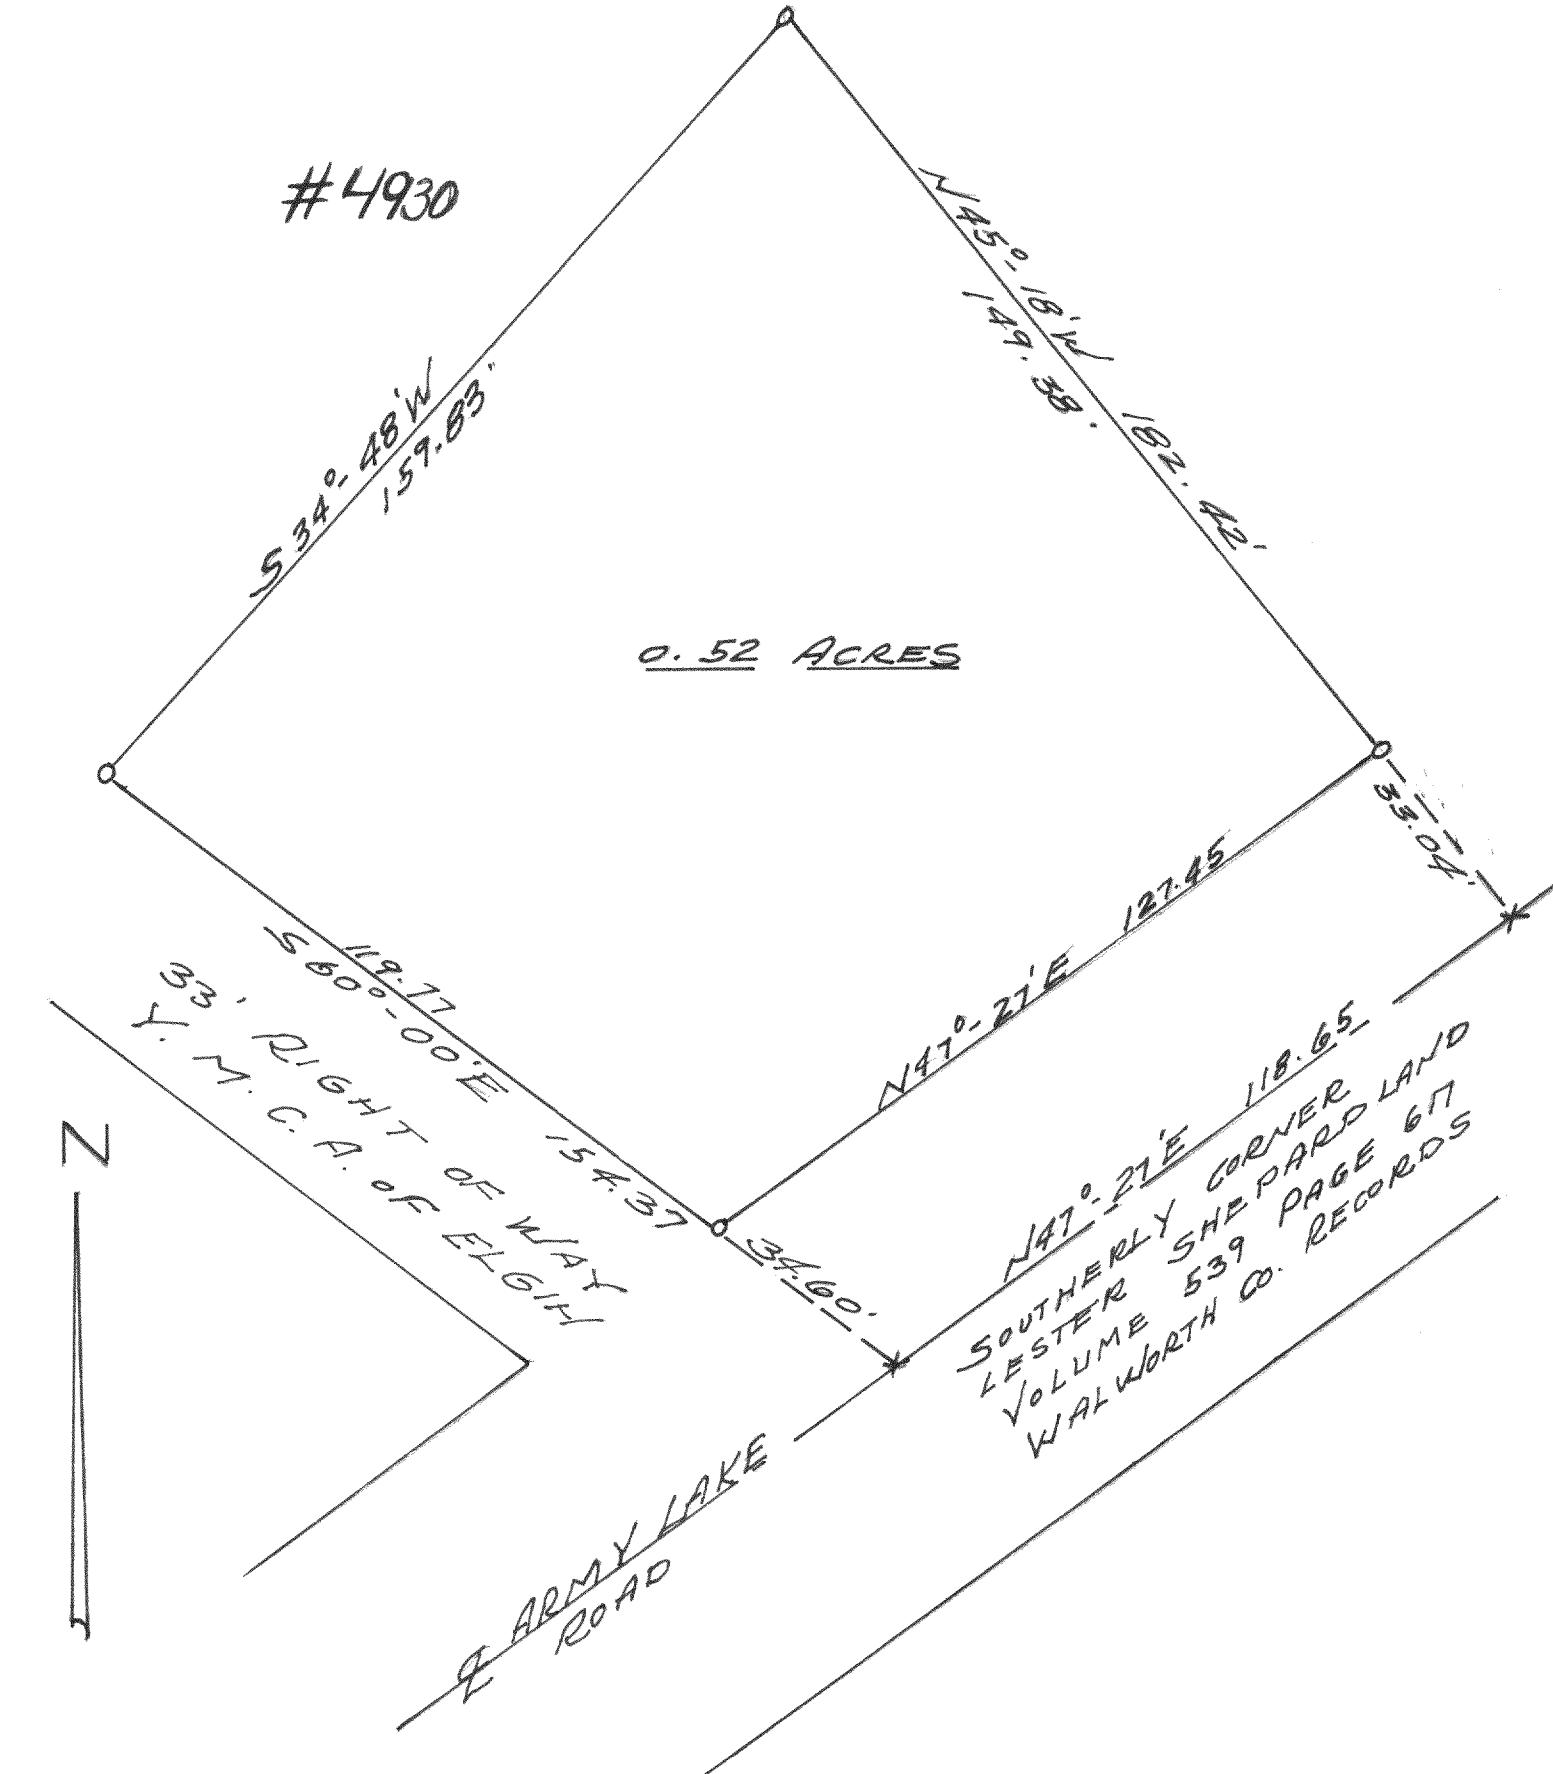

PLAT OF SURVEY OF LAND LOCATED IN  
SE $\frac{1}{4}$  SECTION 9, T4N R18E TOWN OF  
EAST TROY, WAL. CO. WIS.

AUG. 1967

*Floyd L Jensen*  
*Lloyd L JENSEN*  
COUNTY SURVEYOR

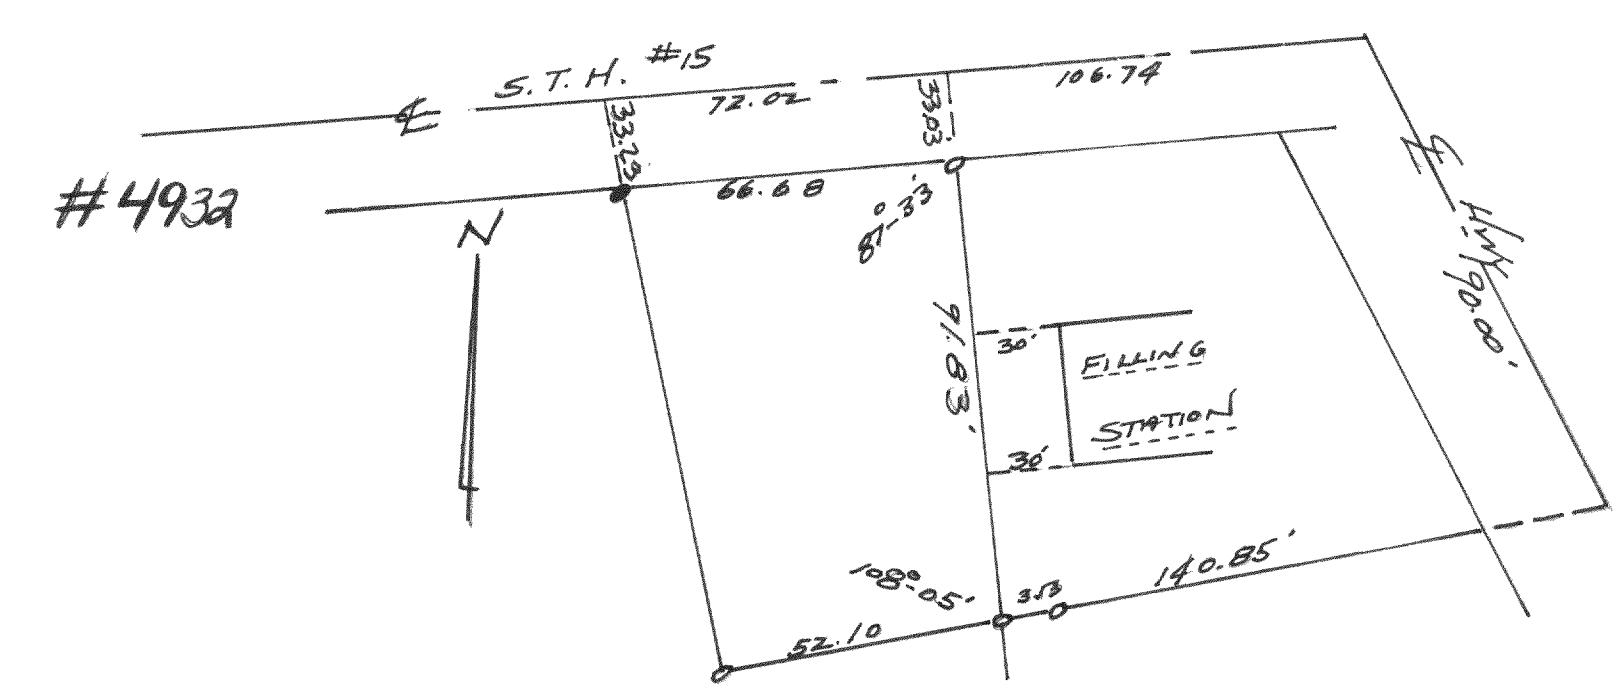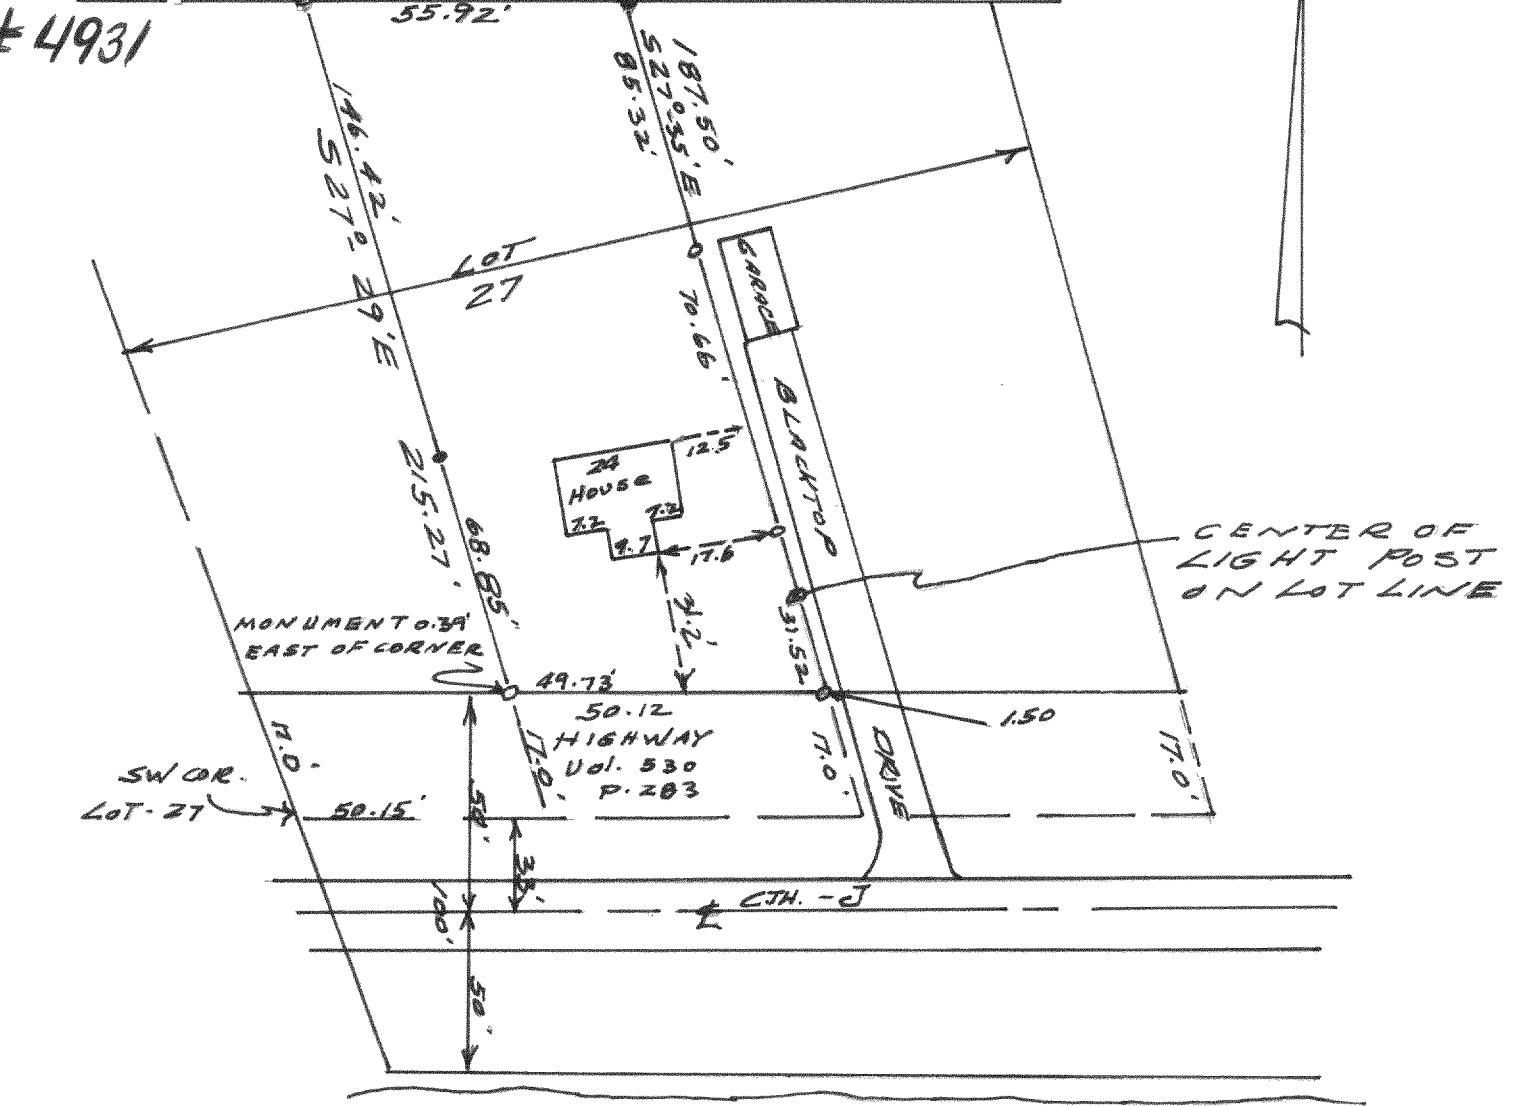

PLAT OF SURVEY OF LAND LOCATED IN  
THE SOUTHWEST  $\frac{1}{4}$  OF SECTION 27, T4N R18E  
OF WALWORTH COUNTY, WISCONSIN

JULY 1966

*Floyd L Jensen*  
*Lloyd L JENSEN*  
COUNTY SURVEYOR