


PLAT OF SURVEY OF

Lot 361 & THE N. 2.0' OF Lot 360
LAKE DELAVAN HIGHLANDS
T2N R16E, WAL. CO. WIS.
MAY 1969

Lloyd Jensen
COUNTY SURVEYOR

o = IRON PIPE SET
⊕ = IRON PIPE FOUND

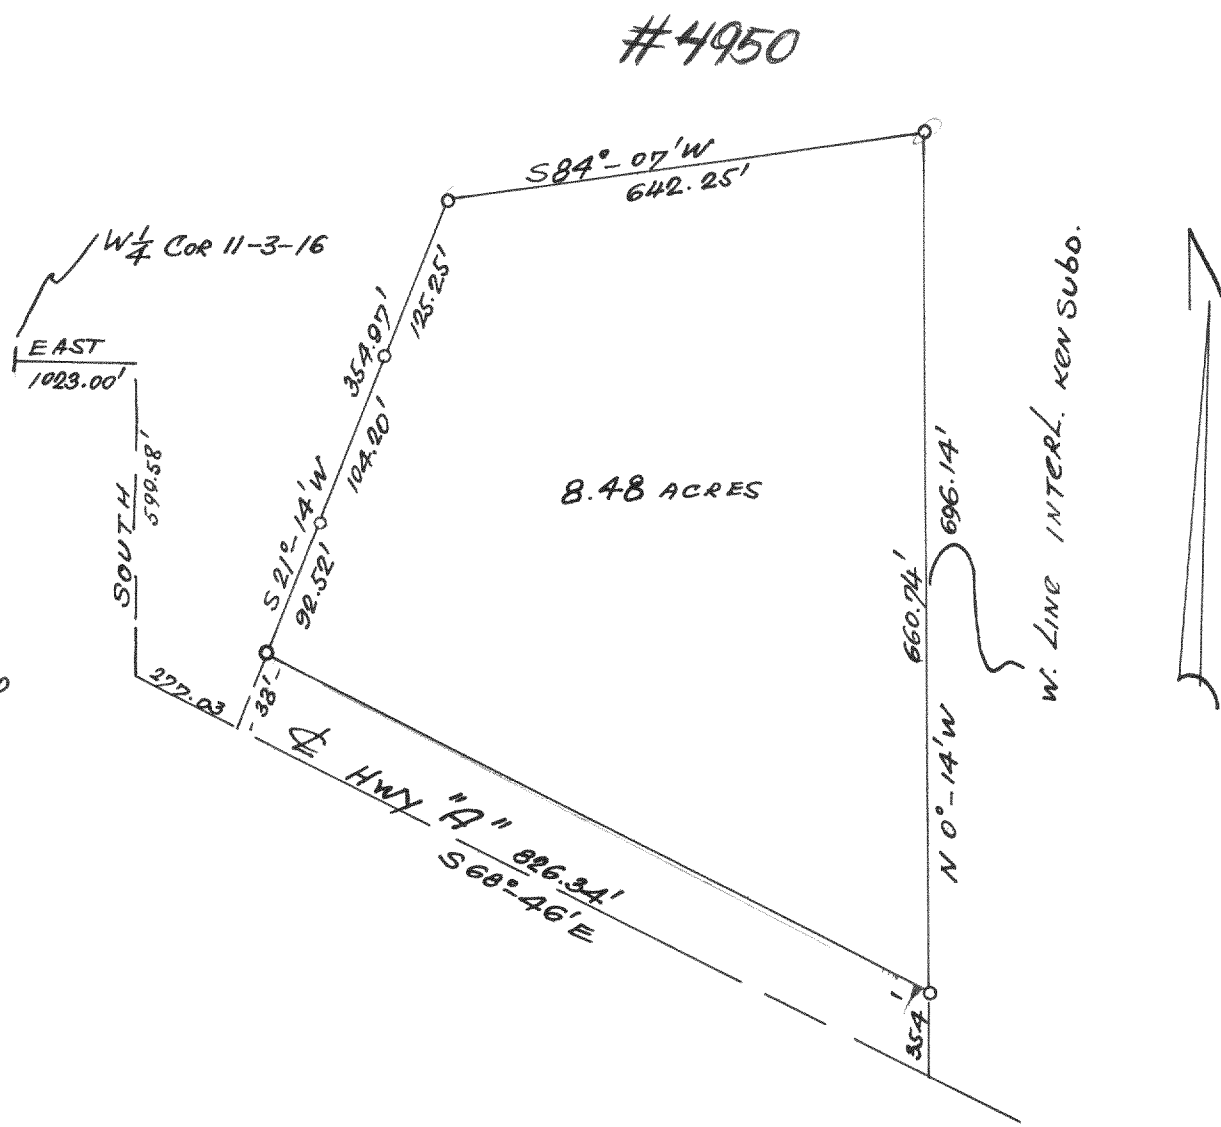


SURVEY OF PARCEL IN THE
SW 1/4 SEC. 11-3-16
JULY 1968

Lloyd Jensen
CO. SURVEYOR

SURVEY OF PARCEL IN
THE N 1/2 S 1/2 SEC 25-4-16
MAY 1970


Lloyd Jensen
CO. SURVEYOR

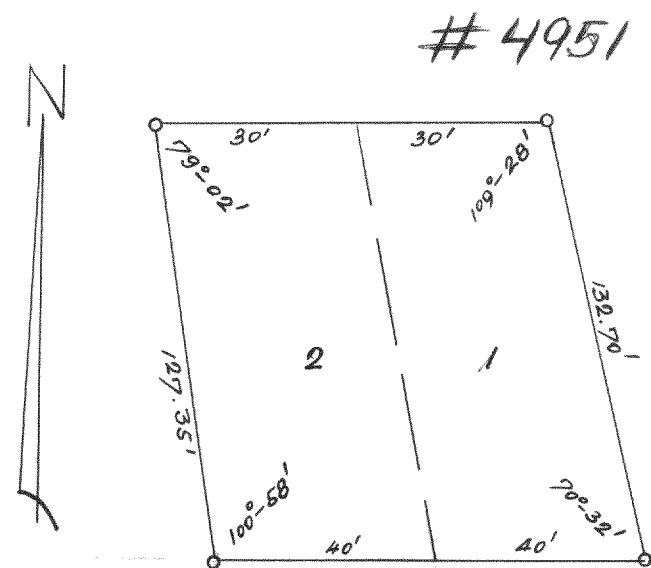

PLAT OF SURVEY
OF LOTS 1 & 2 BLK. 1
NORTH LAKE SHORE WOODS
SEPT. 1968

Lloyd Jensen
CO. SURVEYOR

o = CONC. MONU. SET

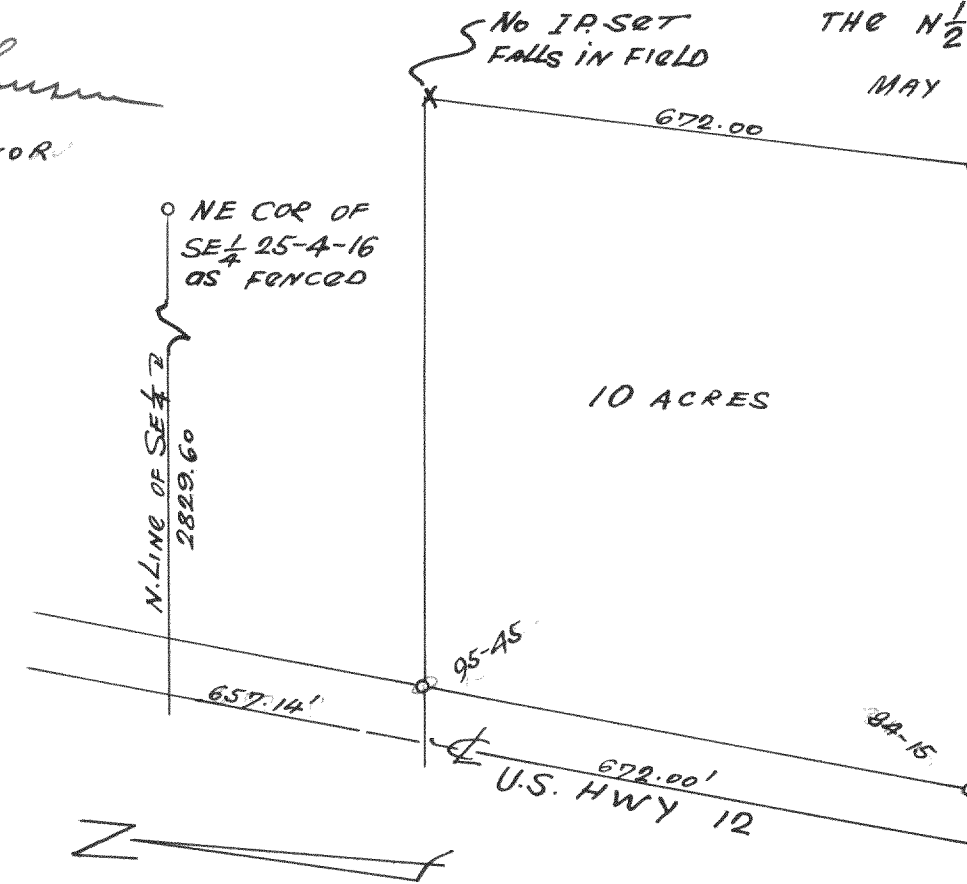

#4952