



LOTS 8172 TO 8181
SECTION 5 OF PELL LAKE
WALWORTH COUNTY WISCONSIN
LLOYD L. JENSEN
COUNTY SURVEYOR
APRIL 1956
P.J.

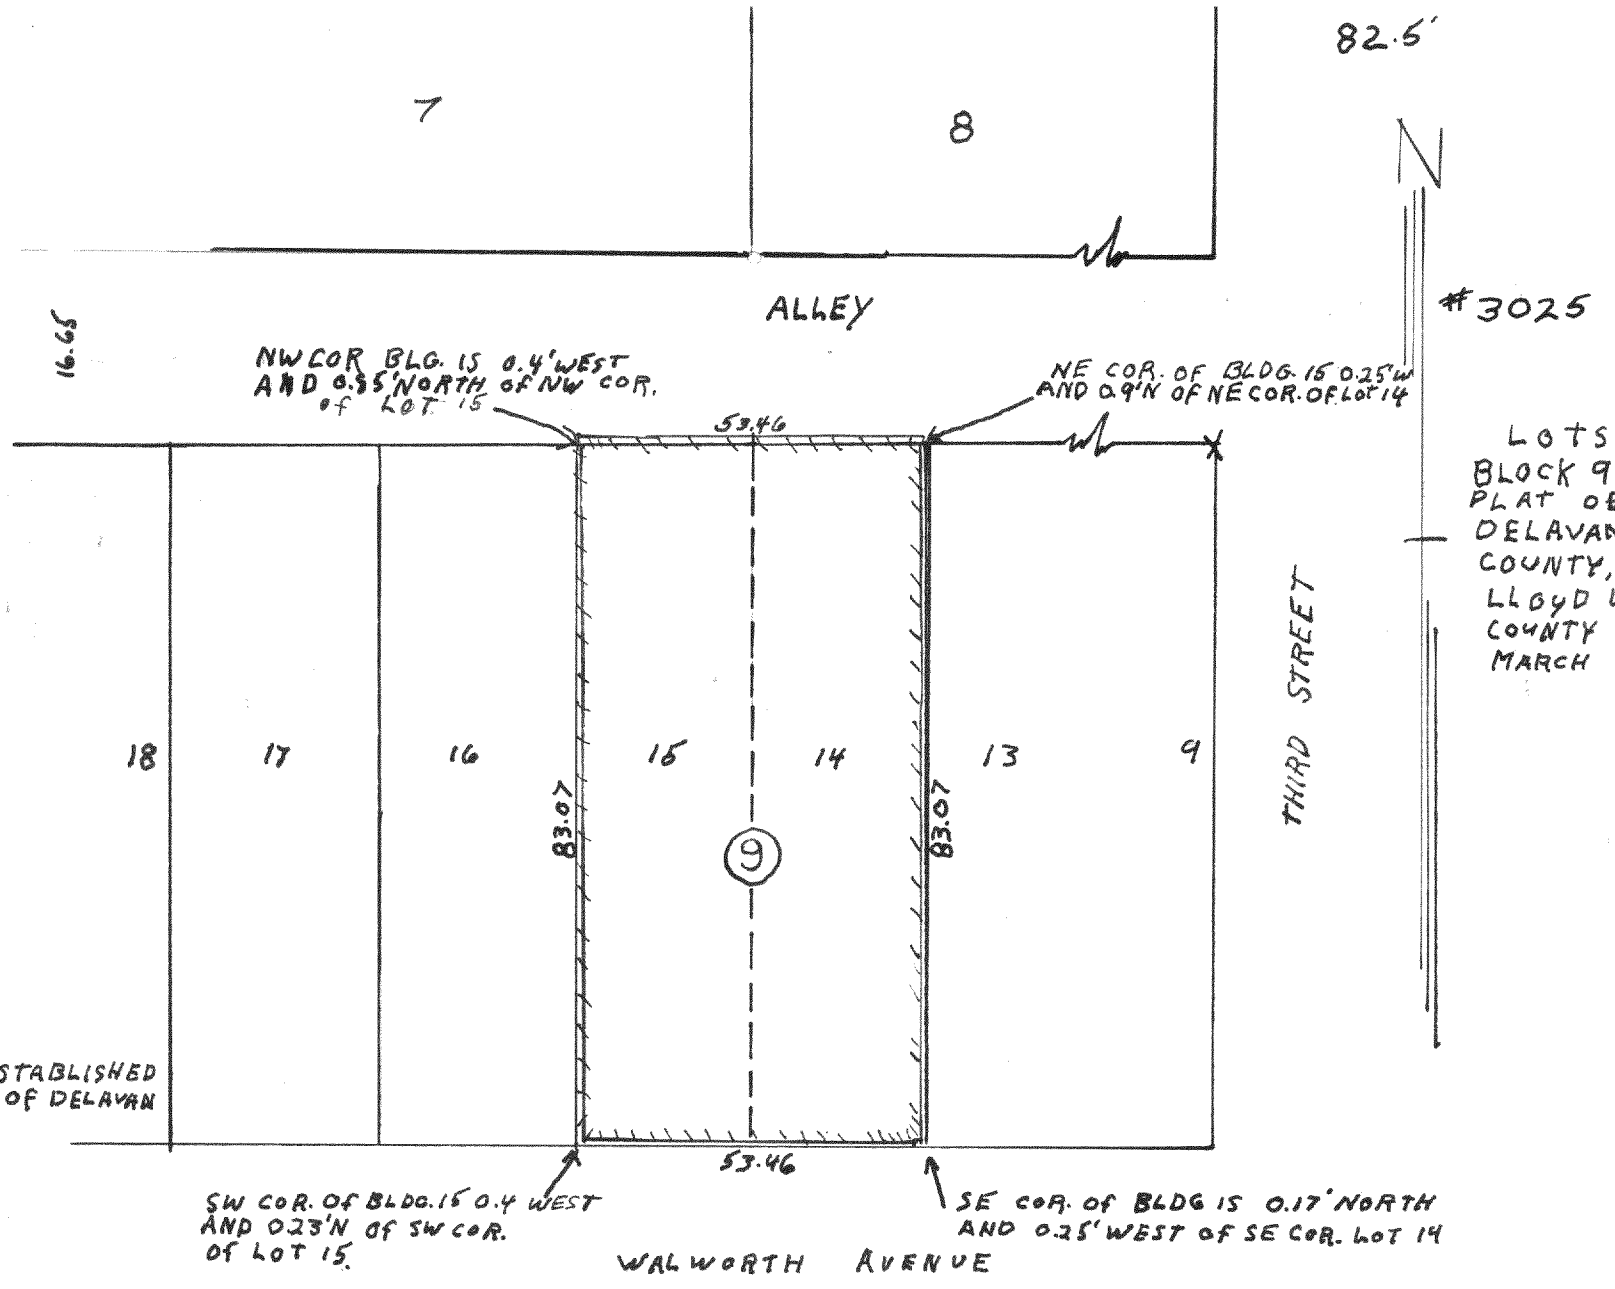

LOTS 14 AND 15 OF
BLOCK 9 OF THE ORIGINAL
PLAT OF THE CITY OF
DELAVER, WALWORTH
COUNTY, WISCONSIN
LLOYD L. JENSEN
COUNTY SURVEYOR
MARCH 1955

POINTS ESTABLISHED
USING CITY OF DELAVER
PLAT

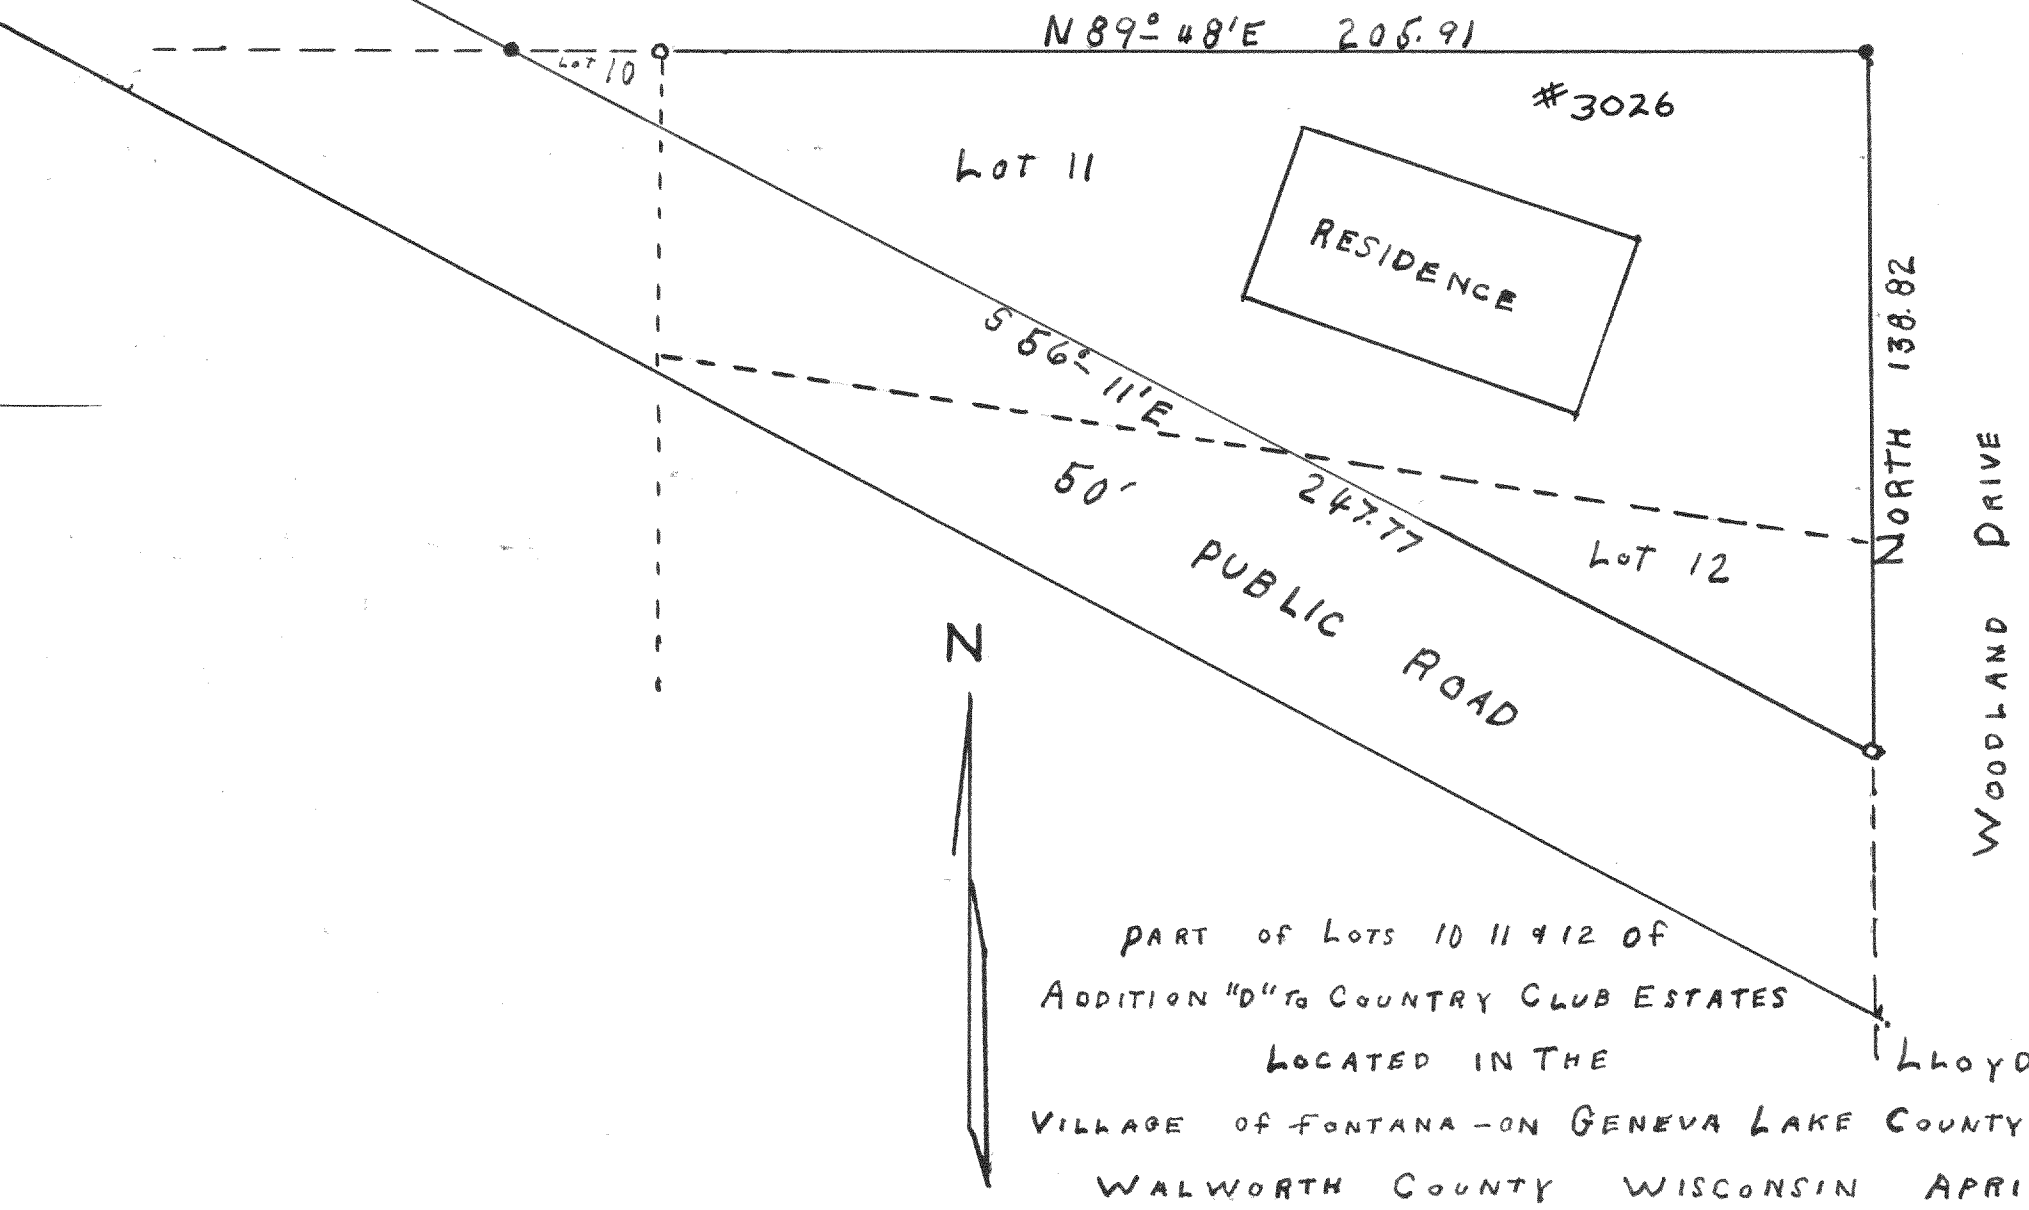

PART OF LOTS 10 11 & 12 OF
ADDITION "D" TO COUNTRY CLUB ESTATES
LOCATED IN THE
VILLAGE OF FONTANA - ON GENEVA LAKE COUNTY SURVEYOR
WALWORTH COUNTY WISCONSIN APRIL 1956

LLOYD L. JENSEN