

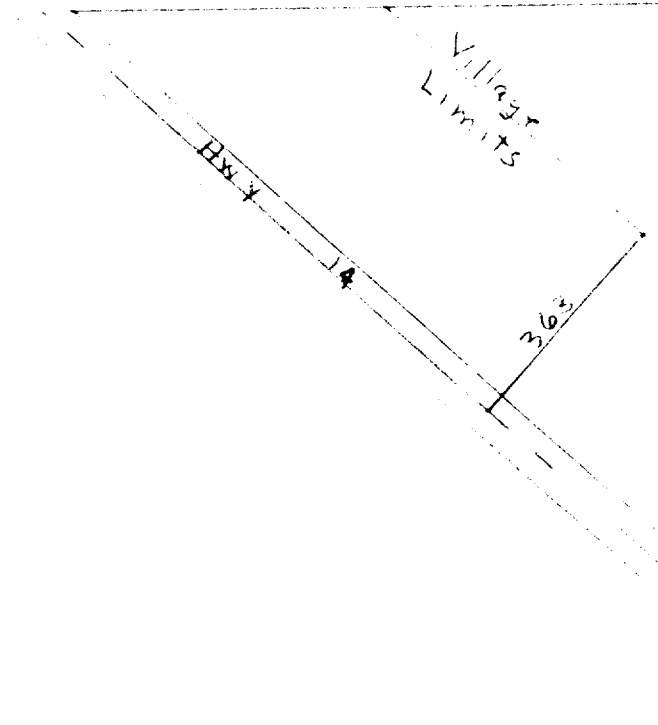


GEORGE T. DUNHAM
SURVEYING & SUBDIVIDING
DELAVER, WISCONSIN

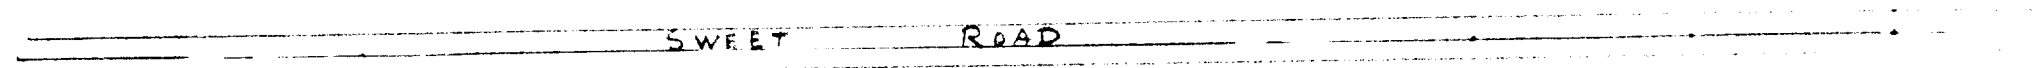

SCALE - 1" = 300'

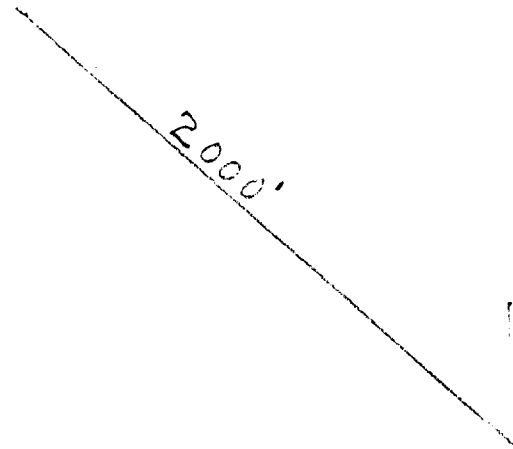

215-70

135