COOPER SURVEYING SERVICES

Rural - Residential - Commercial


DANIEL D. COOPER
Registered Land Surveyor

Route 3, Box 255 :: Elkhorn, Wisconsin 53121

Phone (414) 723-6265

SURVEYING & PLANNING
SUBDIVISIONS - LOT SURVEYS
CONSTRUCTION STAKING MAPPING

RECEIVED
MAR 10 1987

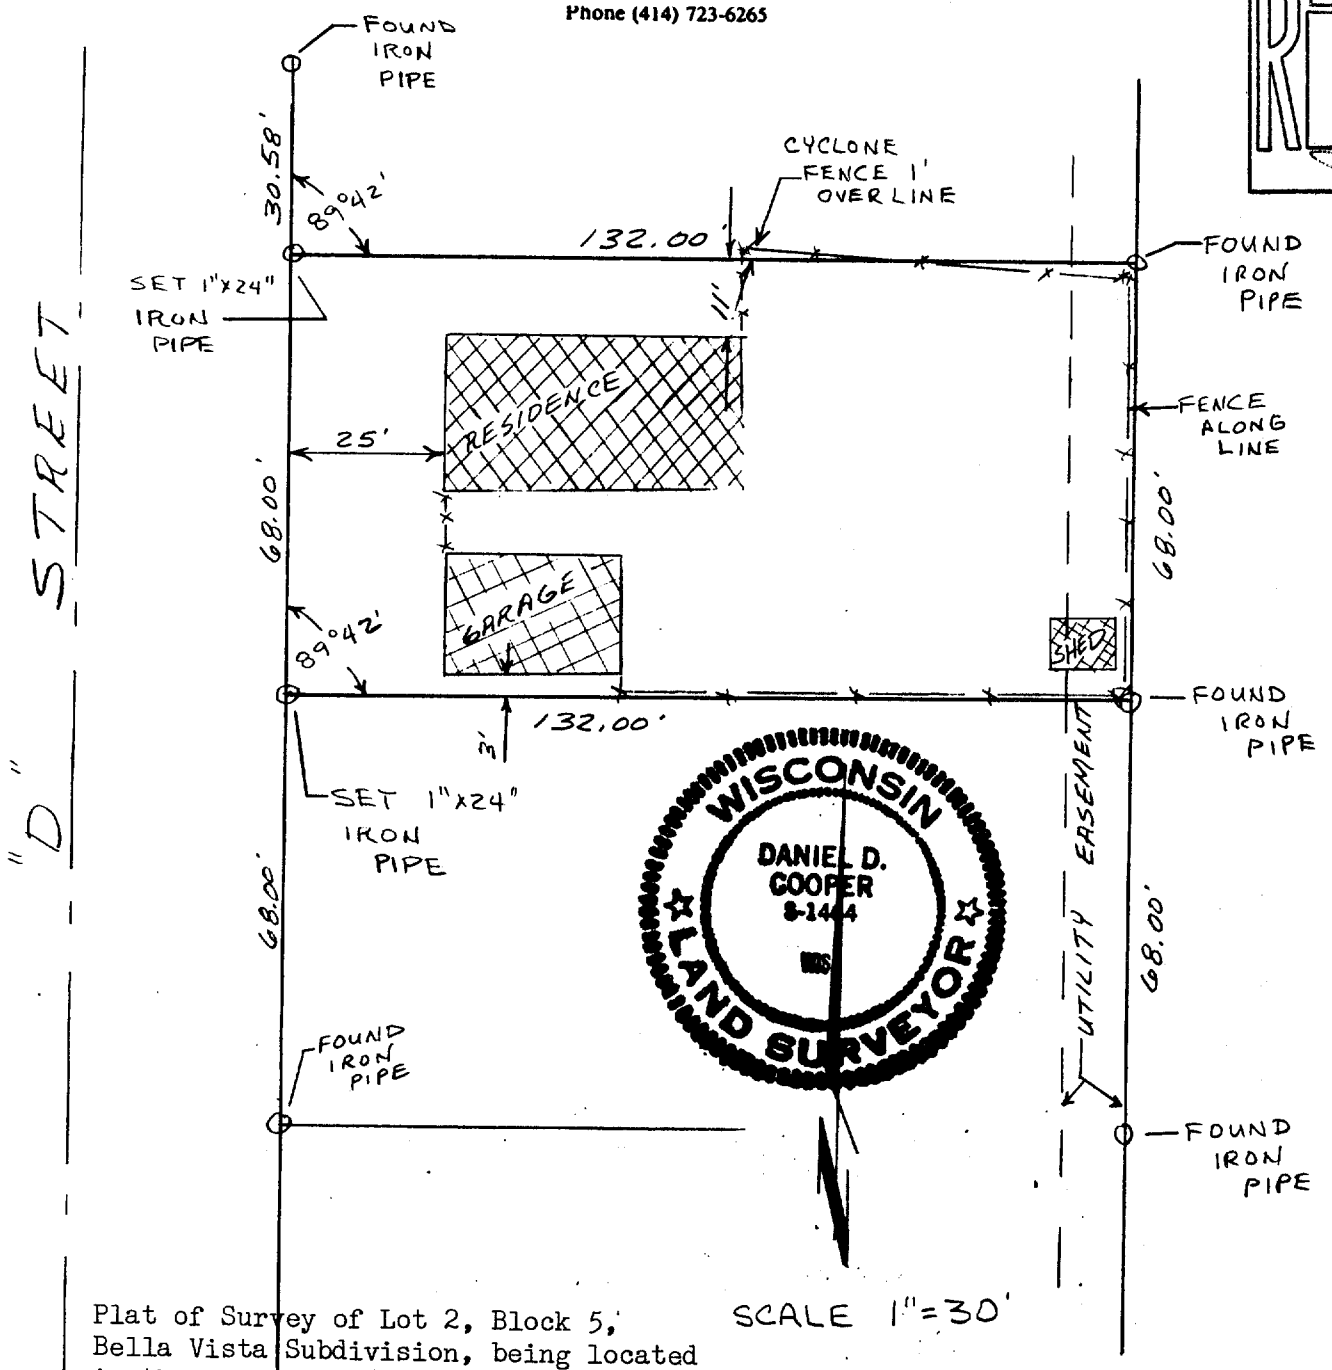

SCALE 1"=30'

Plat of Survey of Lot 2, Block 5, Bella Vista Subdivision, being located in the Village of Darien, Walworth County Wisconsin.

Work ordered by First State Savings, Elkhorn Wisconsin

I hereby certify that I have surveyed the property described hereon and that the above map is a true and accurate representation therof to the best of my professional knowledge and belief..

Dated this 30 day of Sept, 1983

Daniel D. Cooper

Daniel D. Cooper, RLS No. S-1464

DRAWING NO. 1873

TAX Parcel QB 00038

1-193