



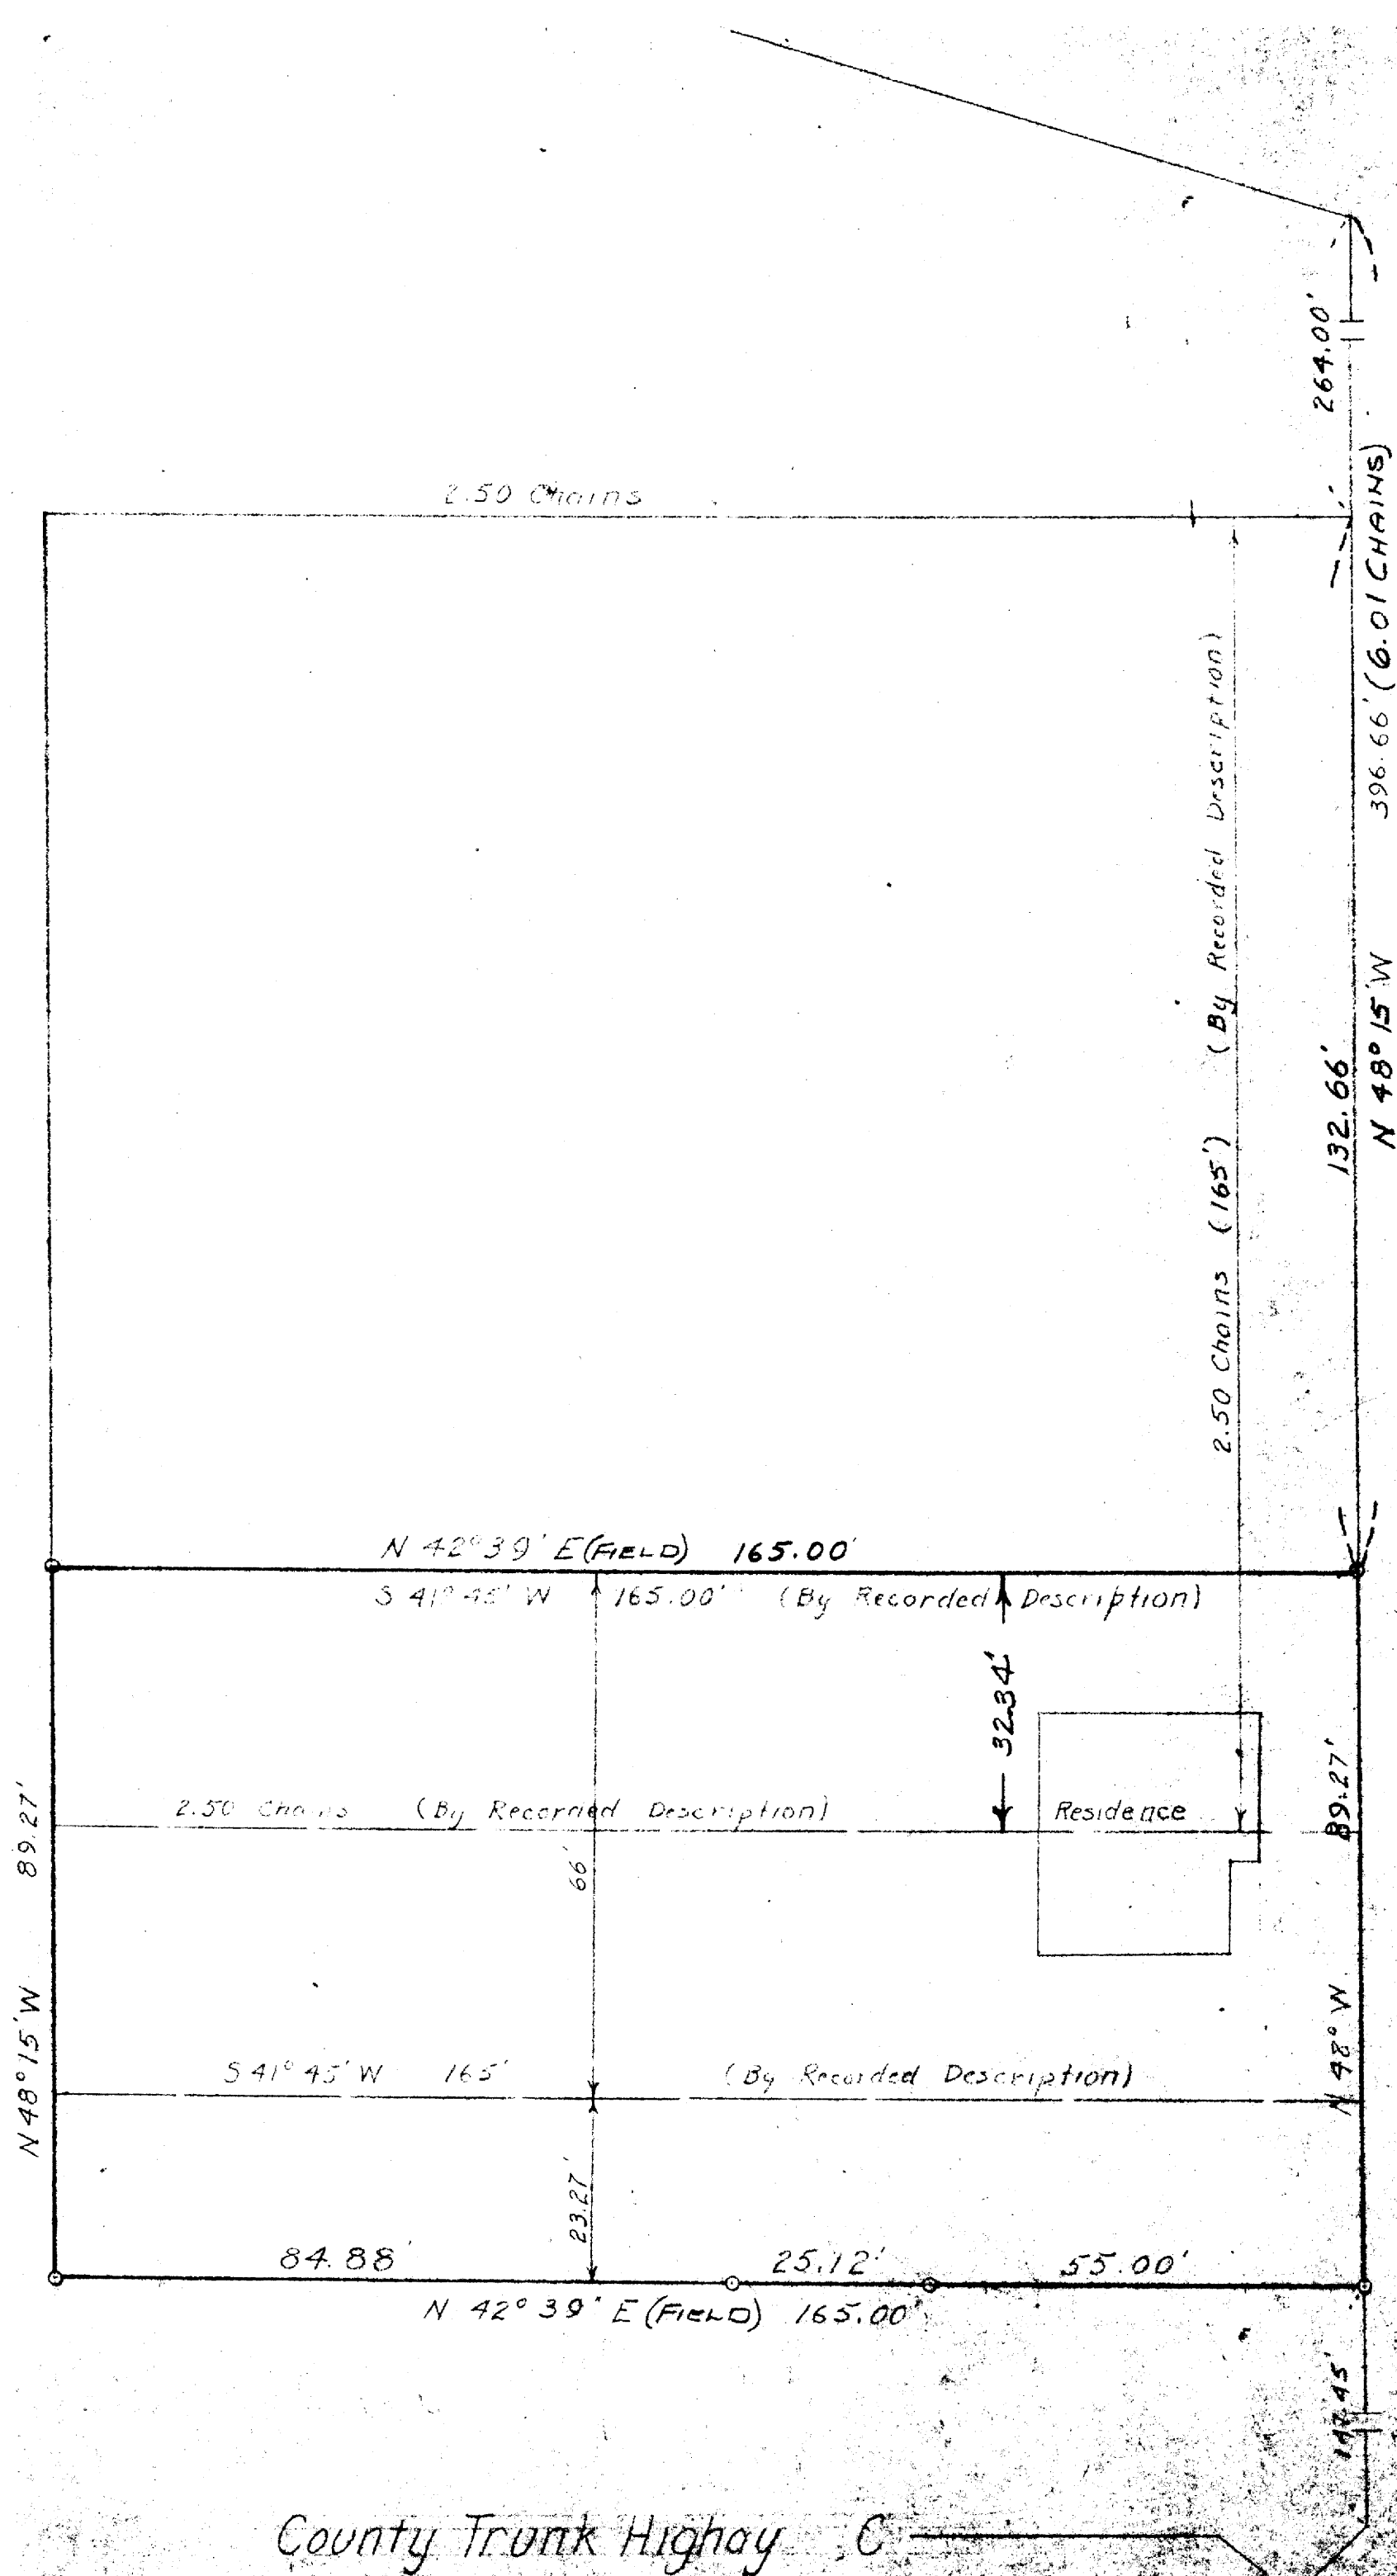

State Highway 15
FORMERLY KNOWN AS THE MILWAUKEE
AND BELLOIT ROAD.

US Highway 14

FORMERLY KNOWN AS THE CHICAGO AND
MADISON TERRITORIAL ROAD.

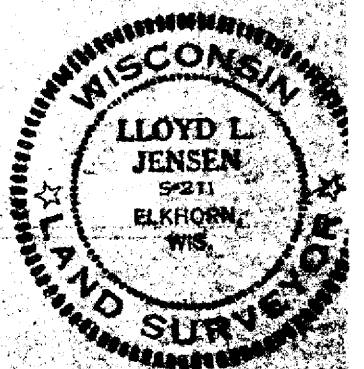

o- Iron Pipe

PLAT OF SURVEY OF

A parcel of land located in the
SW $\frac{1}{4}$ of Section 27, T2N, R15E
Village of Darlen, Walworth
County, Wisconsin.