
DUNHAM SURVEYING, S. C.

SURVEYING & SUBDIVIDING

DELAVAN, WISCONSIN 53115

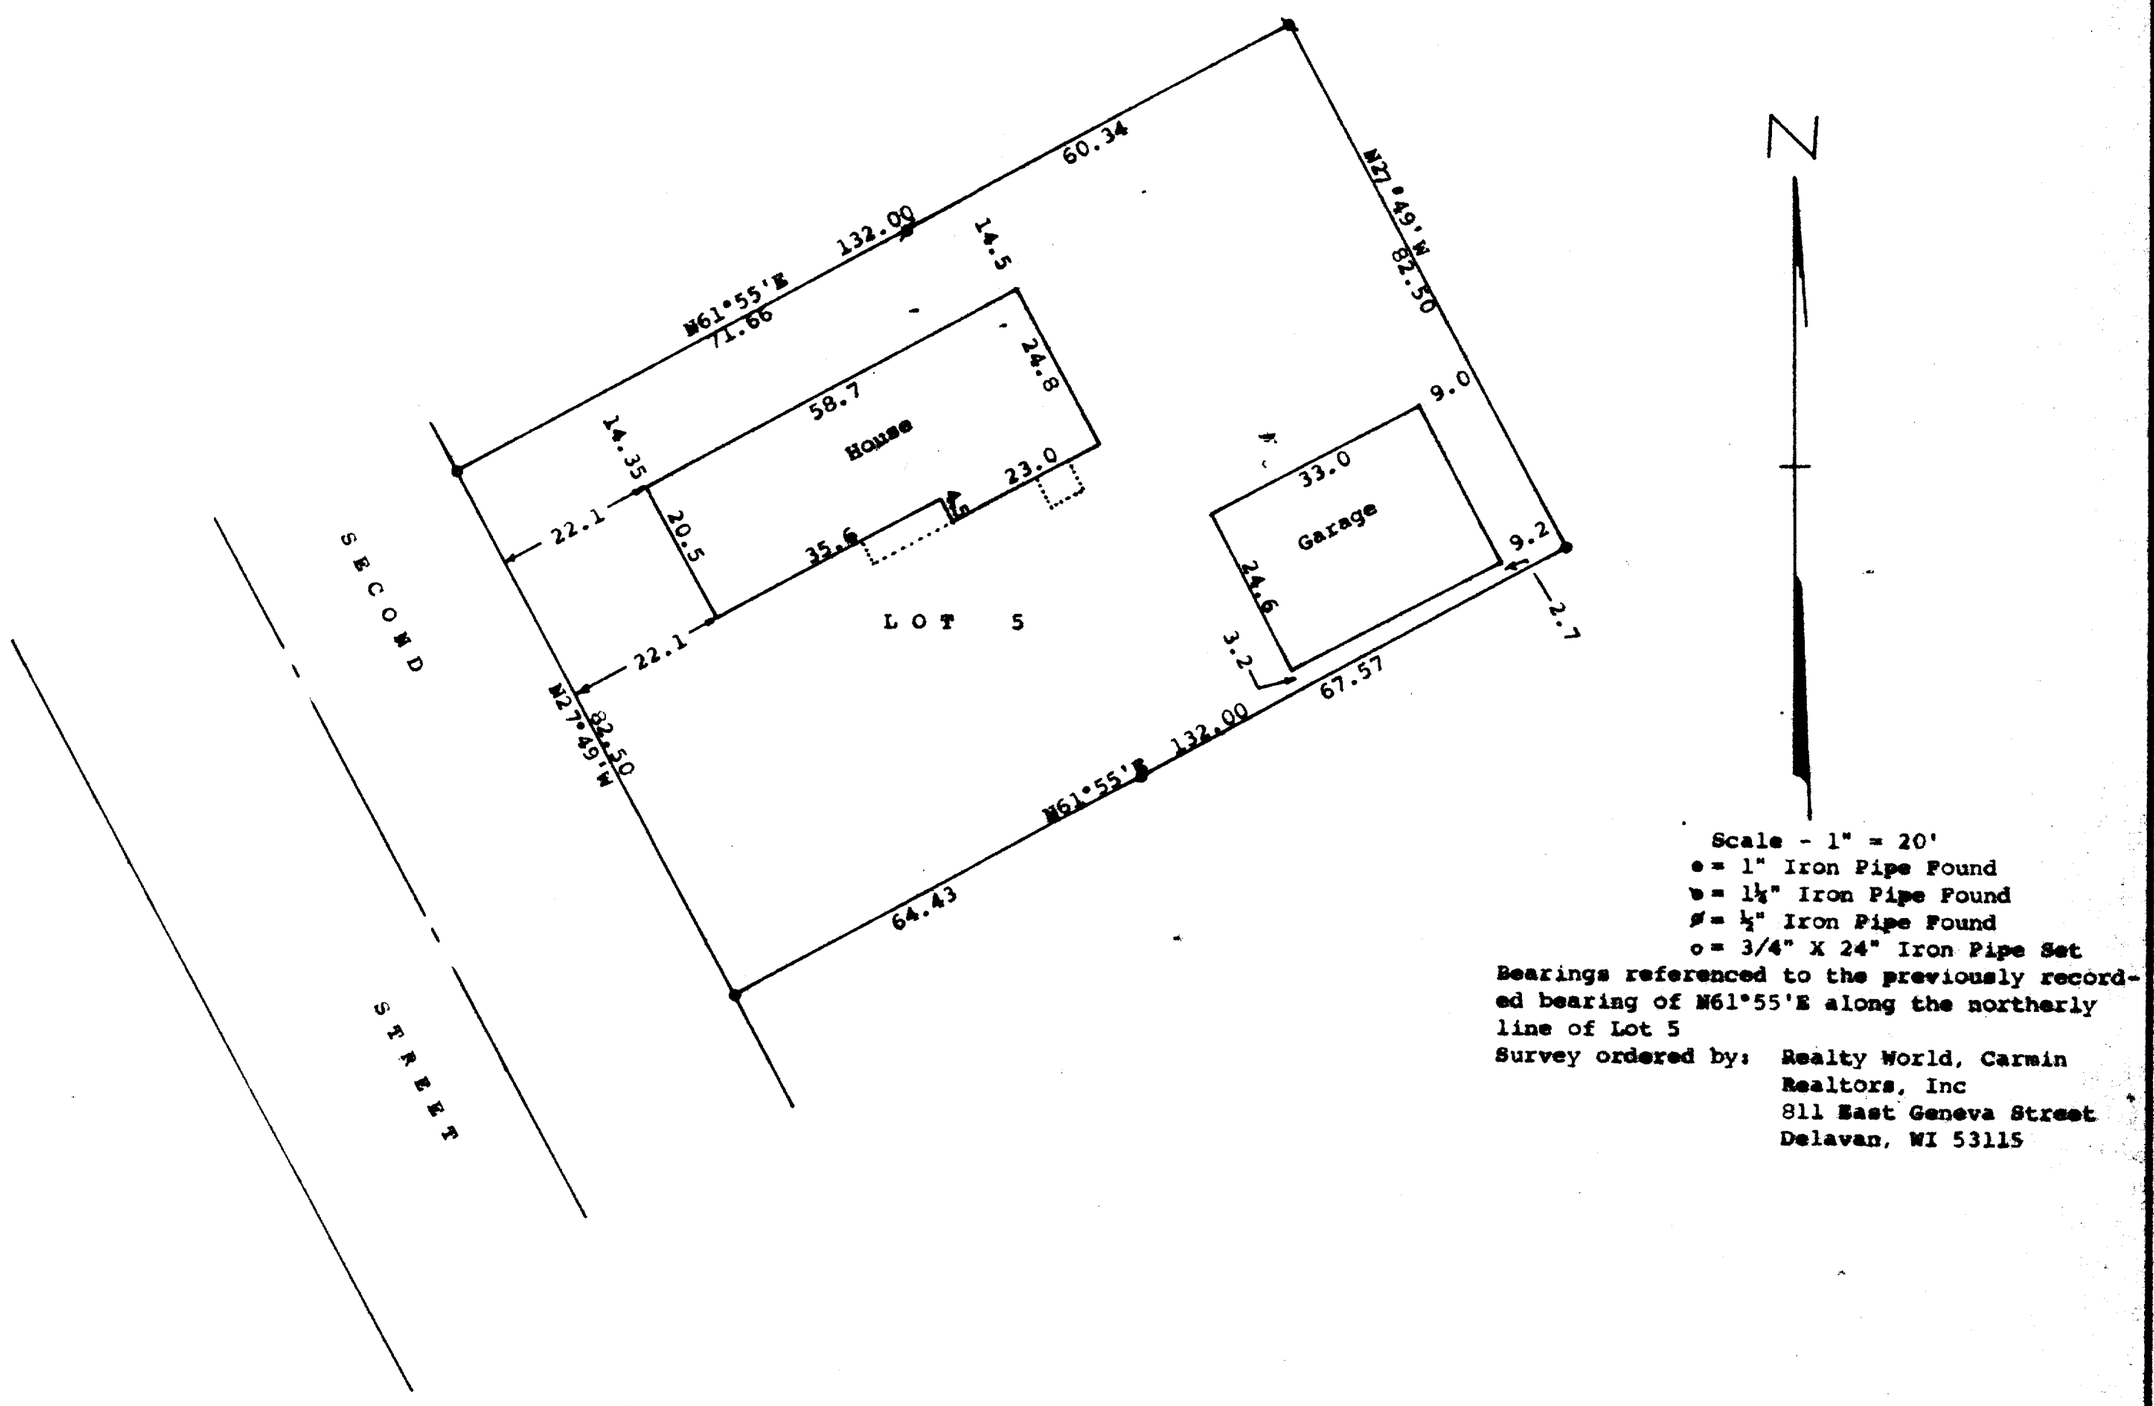

Scale - 1" = 20'
● = 1" Iron Pipe Found
◑ = 1¼" Iron Pipe Found
ø = ½" Iron Pipe Found
o = 3/4" X 24" Iron Pipe Set

Bearings referenced to the previously recorded bearing of N61°55'E along the northerly line of Lot 5

Survey ordered by: Realty World, Carmin Realtors, Inc
811 East Geneva Street
Delavan, WI 53115

STATE OF WISCONSIN)
SS
COUNTY OF WALWORTH)

I, George T. Dunham, Surveyor, certify that I have surveyed the property described as follows:

Lot 5 in Block 1 of the Original Plat of the Village of Darien, Walworth County, Wisconsin,

and that the plat shown hereon is a correct representation thereof and shows the size and location of the property, its exterior boundaries, the location of all visible structures and dimensions of all principal buildings thereon, boundary fences, apparent easements, roadways and visible encroachments, if any, and that I have surveyed the property hereon described, according to the official records, to the best of my knowledge and belief.

May 26, 1988

RECEIVED
AUG 29 1988

George T. Dunham, Surveyor

WISCONSIN
GEORGE T. DUNHAM
S-306
DELAVAN WIS.
LAND SURVEYOR

QOP-5

GMB 1020

1-204