
DUNHAM SURVEYING, S.C.
SURVEYING & SUBDIVIDING
DELAVAN, WISCONSIN 53115

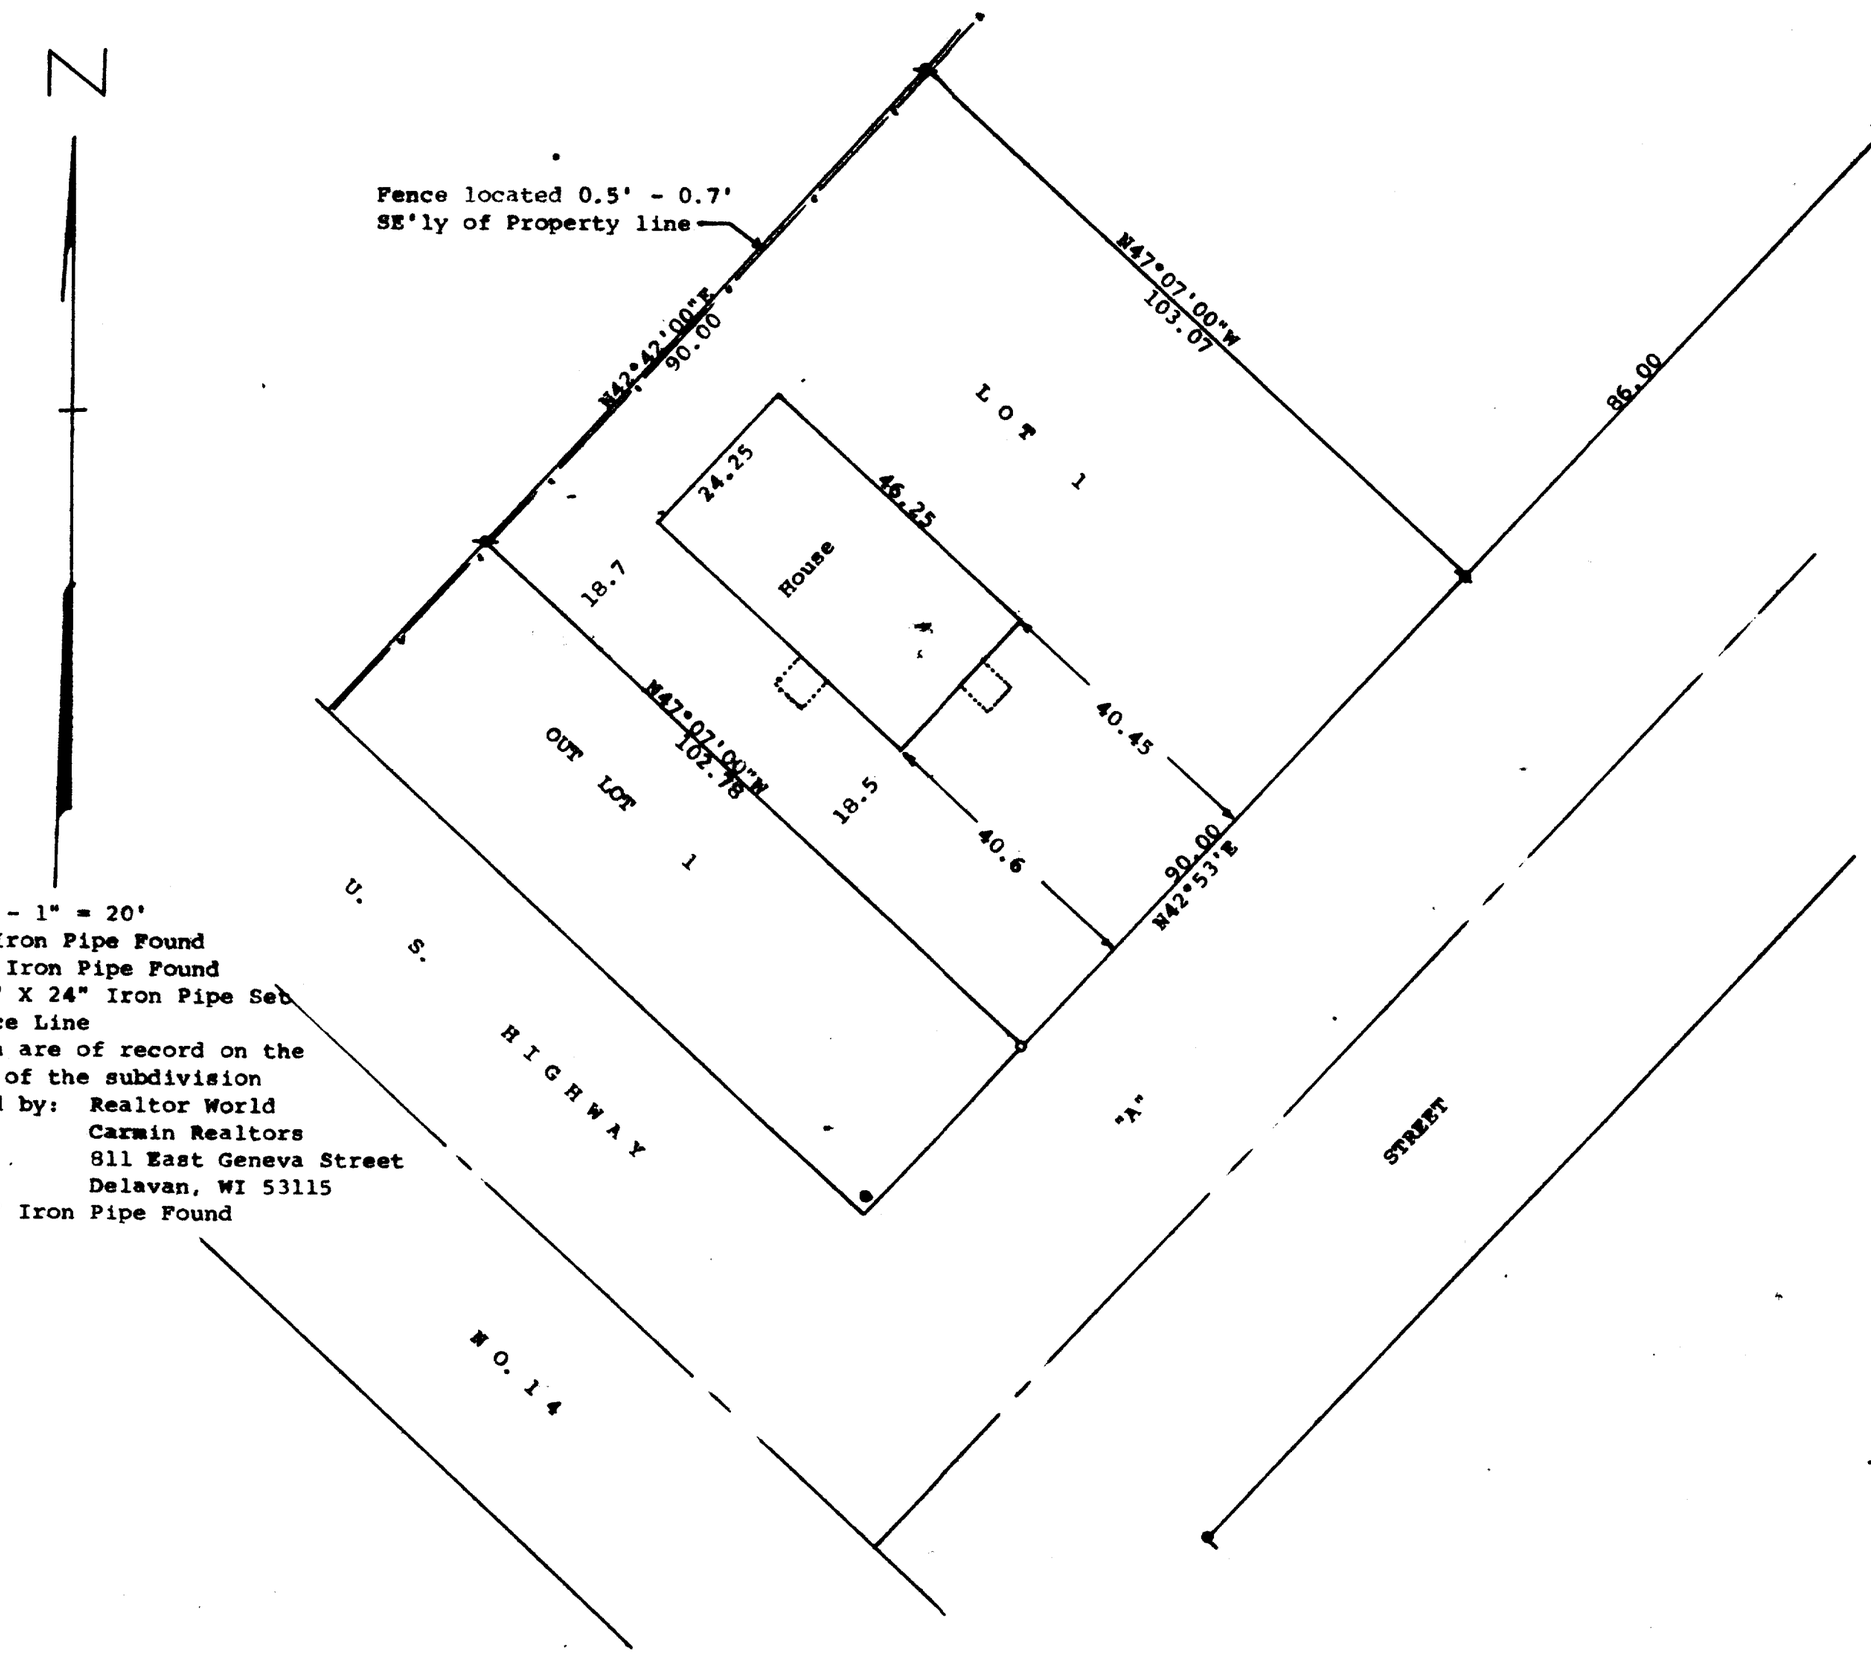

Scale - 1" = 20'
● = 2" Iron Pipe Found
⊸ = 1¼" Iron Pipe Found
○ = 3/4" X 24" Iron Pipe Set
— + — = Fence Line
Bearings shown are of record on the recorded plat of the subdivision
Survey ordered by: Realtor World
Carmin Realtors
811 East Geneva Street
Delavan, WI 53115
↖ = 3/4" Iron Pipe Found

STATE OF WISCONSIN)
COUNTY OF WALWORTH) SS

I, George T. Dunham, Surveyor, certify that I have surveyed the property described as follows:

Lot 1 in Block 1 of Belle Vista, a subdivision located in the Southwest ¼ of the Northwest ¼ and in the Southeast ¼ of the Northwest ¼ of Section 27, T 2 N, R 15 E, Village of Darien, Walworth County, Wisconsin,

and that the plat shown hereon is a correct representation thereof and shows the size and location of the property, its exterior boundaries, the location of all visible structures and dimensions of all principal buildings thereon, boundary fences, apparent easements, roadways and visible encroachments, if any, and that I have surveyed the property hereon described, according to the official records, to the best of my knowledge and belief.

May 18, 1988

George T. Dunham, Surveyor

RECEIVED
AUG 29 1988

WISCONSIN
GEORGE T. DUNHAM
S-306
DELAVAN WIS.
LAND SURVEYOR

QB-1

1-206