
DUNHAM SURVEYING, S.C.

SURVEYING & SUBDIVIDING
DELAVAN, WISCONSIN 53115

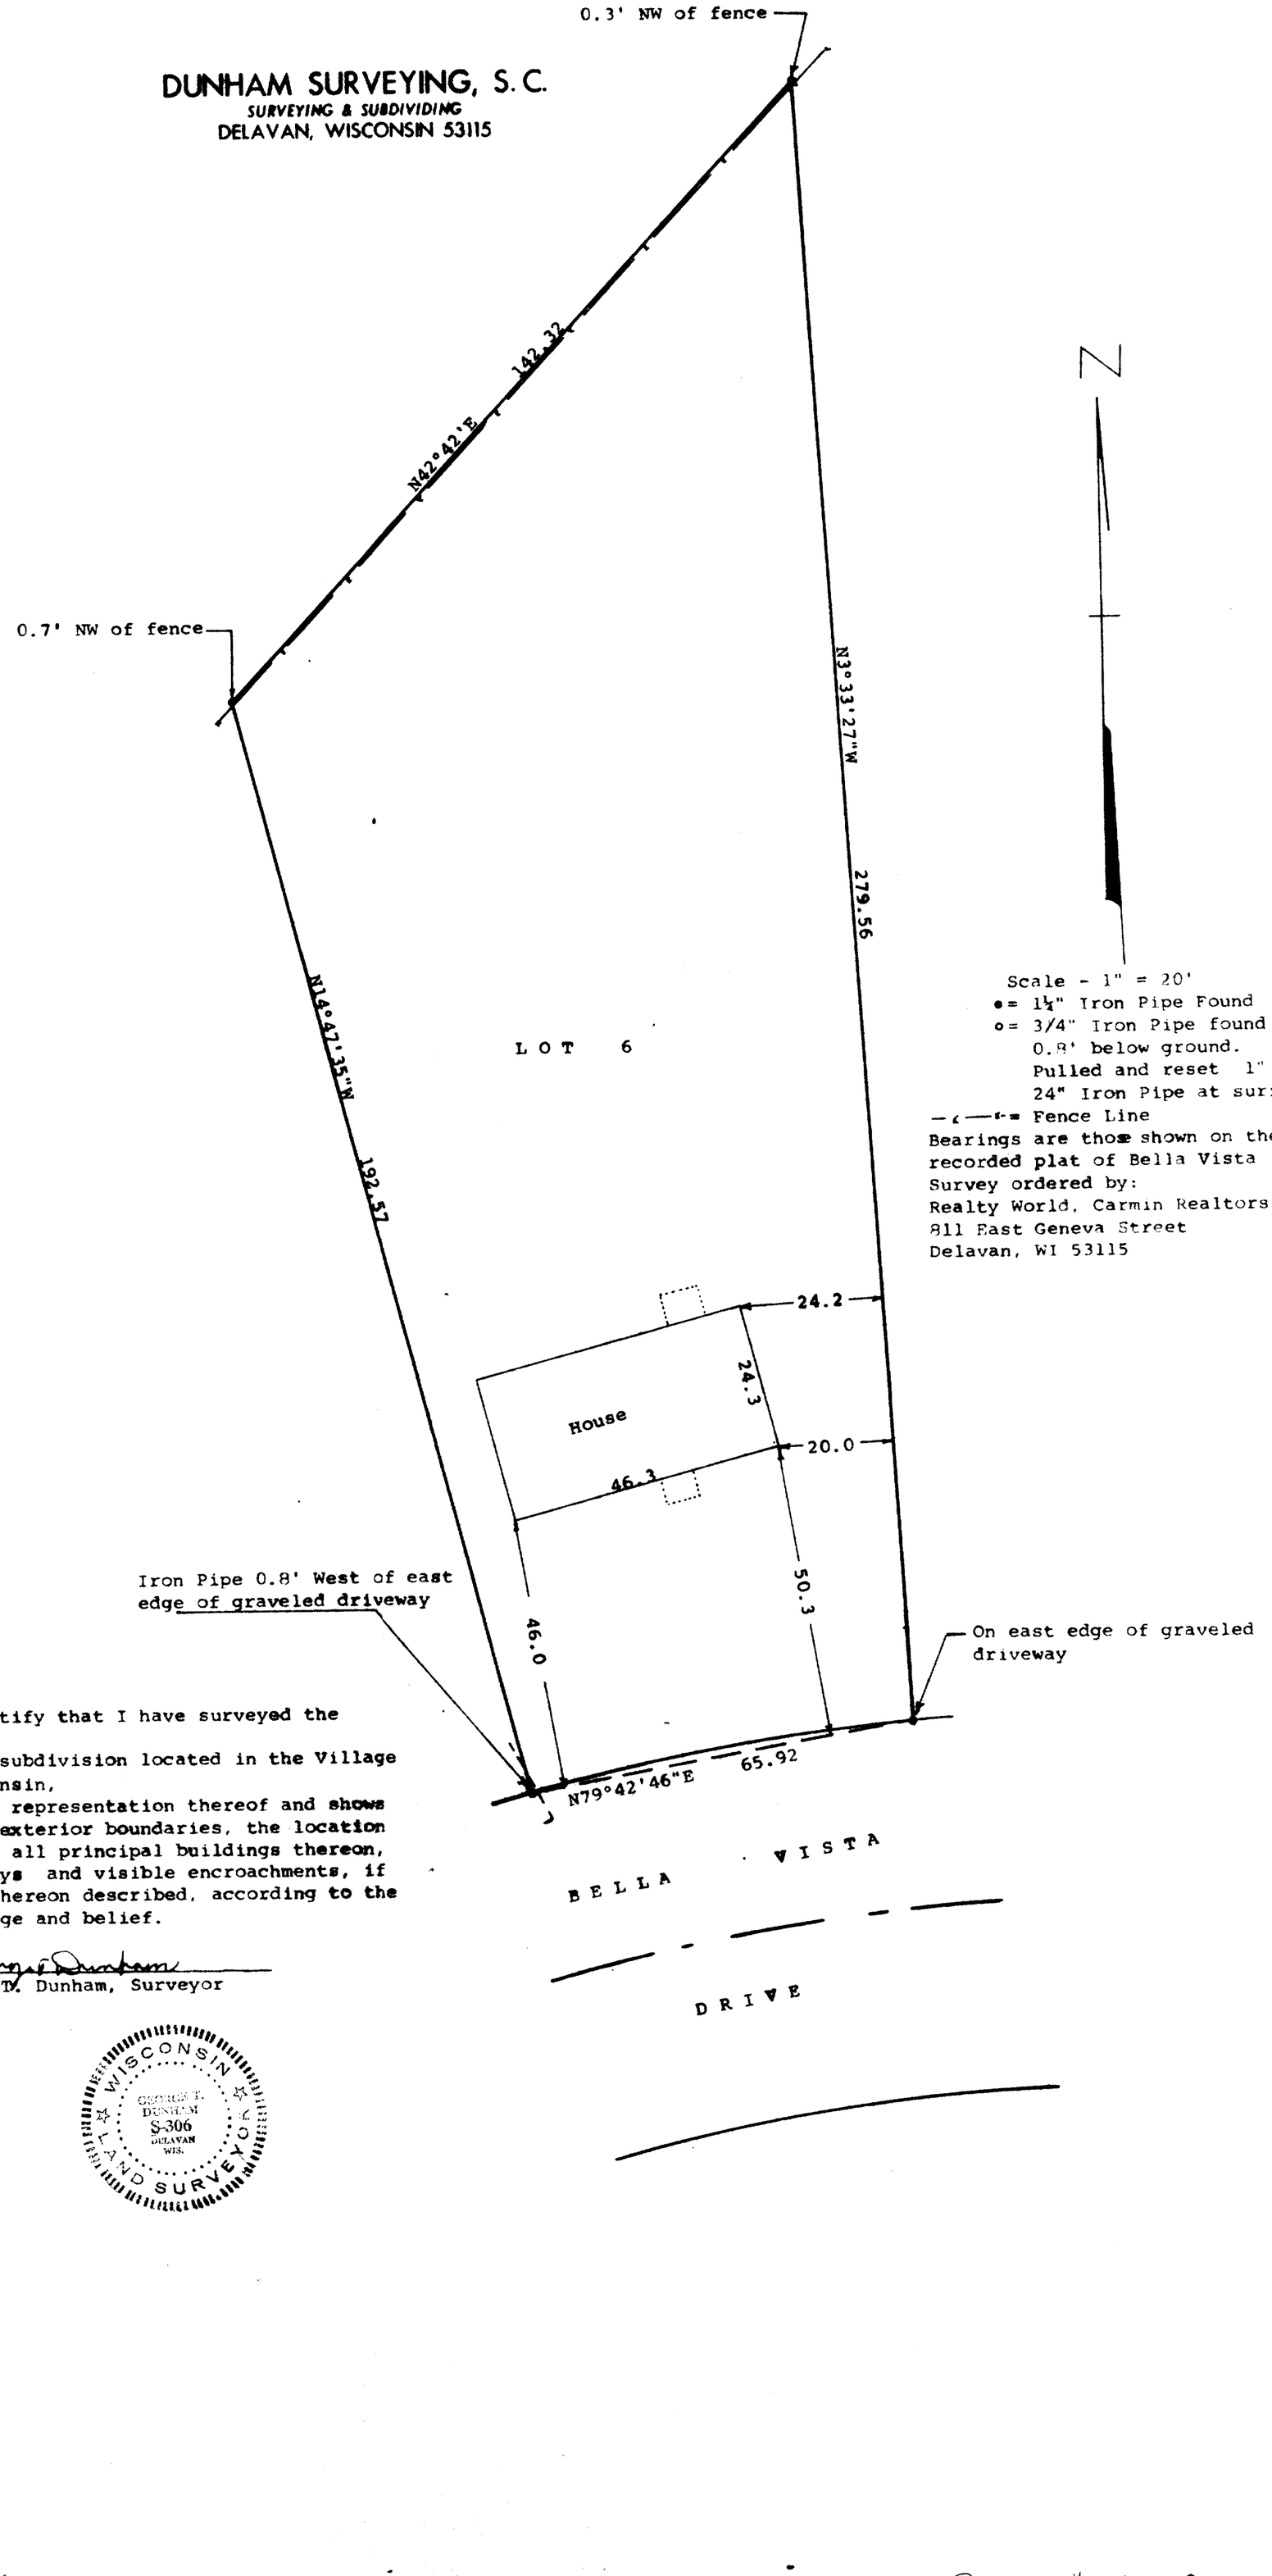

Scale - 1" = 20'
● = 1½" Iron Pipe Found
o = 3/4" Iron Pipe found bent 0.8' below ground. Pulled and reset 1" X 24" Iron Pipe at surface
—‹—+— = Fence Line
Bearings are those shown on the recorded plat of Bella Vista
Survey ordered by:
Realty World, Carmin Realtors
811 East Geneva Street
Delavan, WI 53115

STATE OF WISCONSIN)
COUNTY OF WALWORTH) SS

I, George T.Dunham, Surveyor, certify that I have surveyed the property described as follows:

Lot 6 in Block 1, Bella Vista, a subdivision located in the Village of Darien, Walworth County, Wisconsin,

and that the plat shown hereon is a correct representation thereof and shows the size and location of the property, its exterior boundaries, the location of all visible structures and dimensions of all principal buildings thereon, boundary fences, apparent easements, roadways and visible encroachments, if any, and that I have surveyed the property hereon described, according to the official records, to the best of my knowledge and belief.

February 16, 1990

George T. Dunham, Surveyor

RECEIVED
AUG 16 1990

WISCONSIN LAND SURVEYOR
GEORGE T. DUNHAM
S-306
DELAVAN WIS.

TAX KEY # QB 00006

SURVEY # 1-228