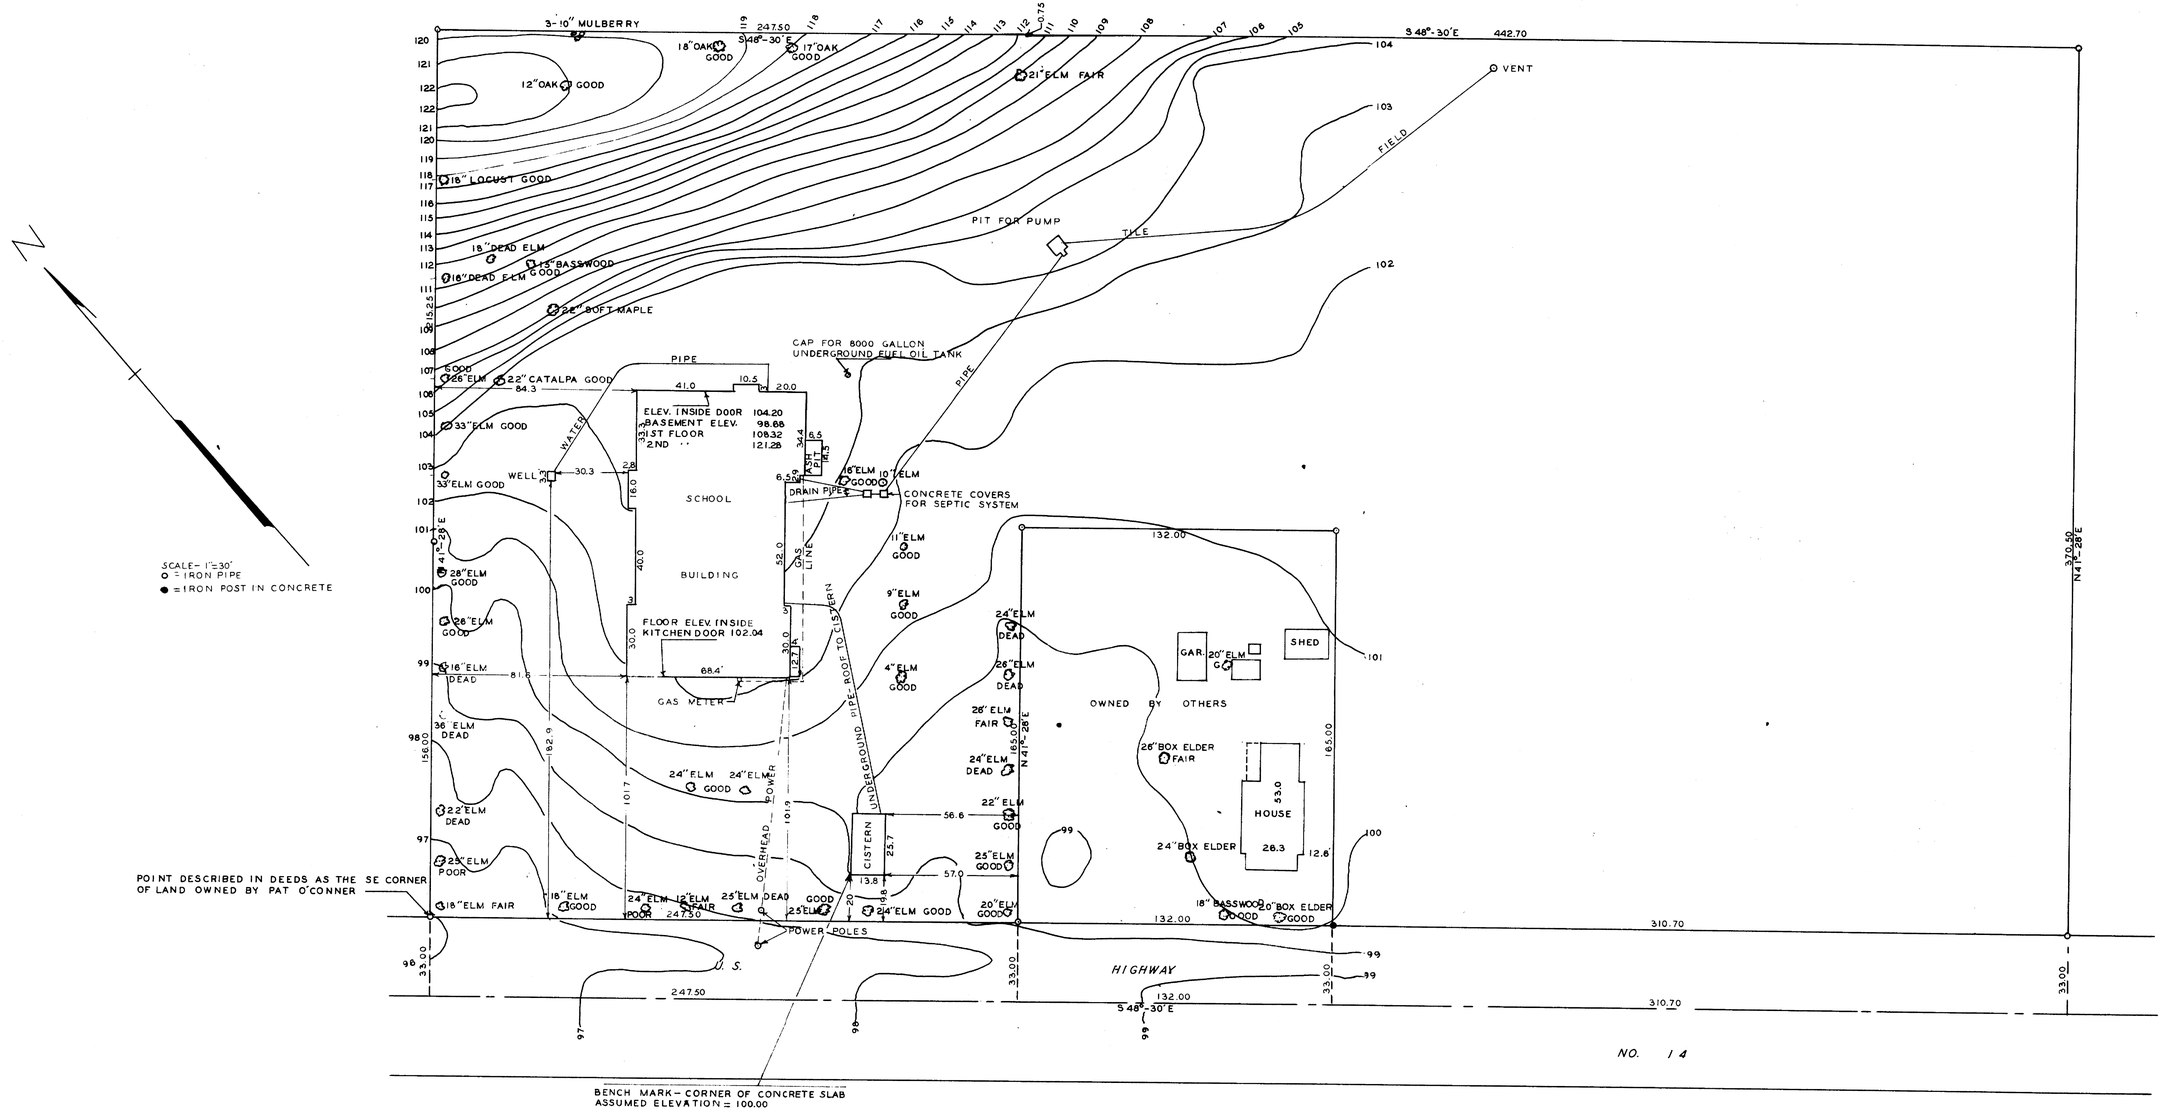

PLAT OF SURVEY OF A PARCEL OF LAND LOCATED IN THE SOUTHEAST 1/4 OF SECTION 27, T2N R15E, VILLAGE OF DARIEN, WALWORTH COUNTY WISCONSIN OWNED BY SCHOOL DISTRICT NO.7 JOINT IN TOWNS OF DARIEN AND SHARON. JUNE 1985

George T. Dunham

GEORGE T. DUNHAM SURVEYOR

VD-103 & VD-104