FARRIS, HANSEN & ASSOCIATES, INC.

ENGINEERING, ARCHITECTURE, SURVEYING

7 RIDGWAY COURT - P.O.BOX 437, ELKHORN, WISCONSIN 53121

PHONE: (414) 723-2098 FAX: (414) 723-5886

PLAT OF SURVEY

LOT 48 OF OAK RIDGE SUBDIVISION

ADDITION NO. 1


LOCATED IN THE SW 1/4 OF THE SW 1/4 OF SEC. 26


TOWN 2 NORTH, RANGE 15 EAST, VILLAGE OF DARIEN

WALWORTH COUNTY, WISCONSIN

WORK ORDERED BY: BRUCE LINDSTRAND
PO OX 181
S. BELOIT, IL. 61080

● = FOUND IRON REBAR STAKE
◢ = SET IRON REBAR STAKE
(xxx) = RECORDED AS

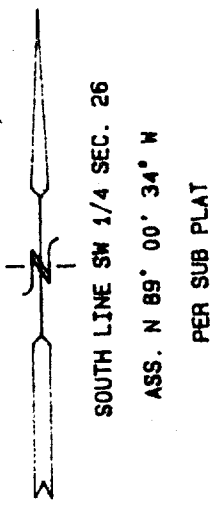

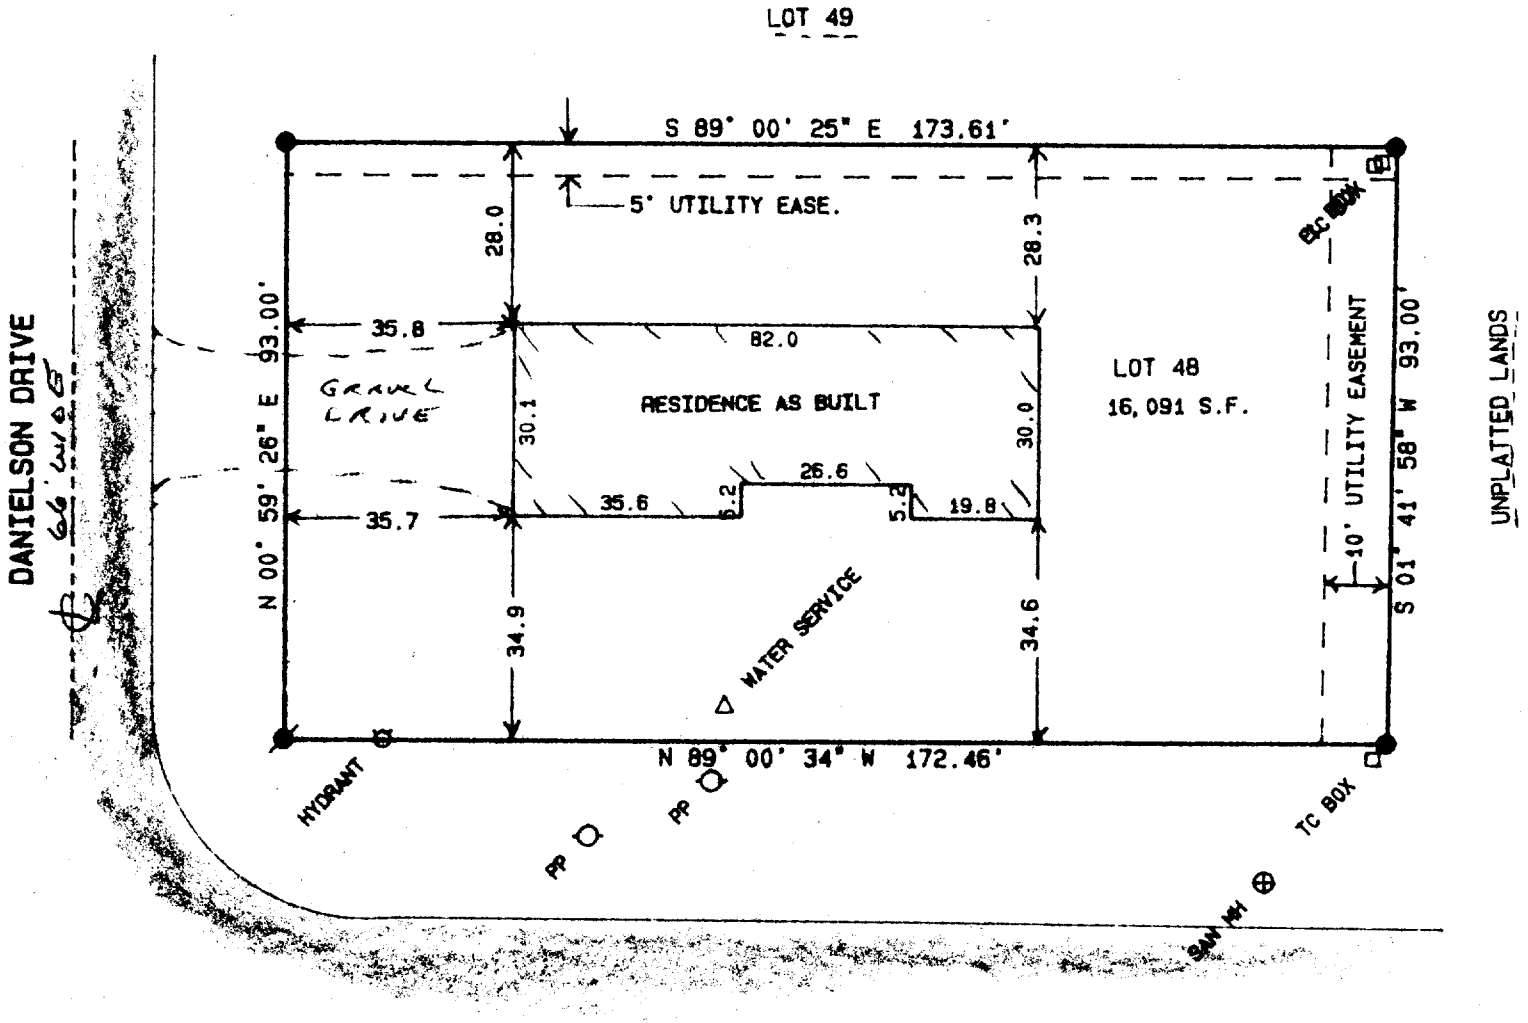

SWEET ROAD

66' WIDE

100 90 80 70 60 50 40 30 20 10 0 50 100

MAP SCALE IN FEET ORIGINAL 1" = 30'

NOTE: COPIES OF THIS MAP TO WHICH THE FOLLOWING CERTIFICATE WILL APPLY ARE BLUE LINE PRINTS SHOWING SURVEYOR'S ORIGINAL SEAL AND SIGNATURE IN BLACK INK. COPIES BY ANY OTHER MEANS MAY HAVE ALTERATIONS WHICH DO NOT REPRESENT THE SURVEYOR'S WORK PRODUCT.

I HEREBY CERTIFY THAT THE ABOVE DESCRIBED PROPERTY HAS BEEN SURVEYED UNDER MY DIRECTION AND THAT THE ABOVE MAP IS A TRUE REPRESENTATION THEREOF AND SHOWS THE SIZE AND LOCATION OF THE PROPERTY AND ITS EXTERIOR BOUNDARIES. THIS SURVEY IS MADE FOR THE USE OF THE PRESENT OWNERS OF THE PROPERTY, AND ALSO THOSE WHO PURCHASE, MORTGAGE, OR GUARANTEE THE TITLE THERETO WITHIN ONE YEAR FROM THE DATE HEREOF.

DATED: 11-5-1996

PETER S. GORDON R.L.S. 2101

WISCONSIN
PETER S. GORDON
S-2101
ELKHORN, WI
LAND SURVEYOR

RECEIVED
NOV 14 1996

PROJ 3575.48
11-05-1996

QOR1-4

001-340