
PLAT OF SURVEY

A PARCEL OF LAND IN THE NE. 1/4 OF THE NW. 1/4 OF SECT. 34, T2N, R15E, VILLAGE OF DARIEN, WALWORTH COUNTY, STATE OF WISCONSIN, DESCRIBED AS FOLLOWS:

COMMENCING AT THE NORTH 1/4 CORNER OF SECTION 34, T2N, R15E; THENCE S0°05'19"E, 198.00' ALONG THE EAST LINE OF THE NW. 1/4 OF SECT. 34, T2N, R15E TO THE POINT OF BEGINNING; THENCE S0°05'19"E, 17.00' ALONG SAID EAST LINE; THENCE S88°40'30"W, 33.00'; THENCE N0°07'41"W, 7.00'; THENCE S88°40'30"W, 186.90'; THENCE N0°07'08"W, 10.00'; THENCE N88°40'30"E, 219.89' TO THE POINT OF BEGINNING. SAID PARCEL OF LAND CONTAINING 0.056 ACRES ±.

ORDERED BY: LYDIA RUBENDALL
621 PARK AVE.
DELAVAN, WI.
53115

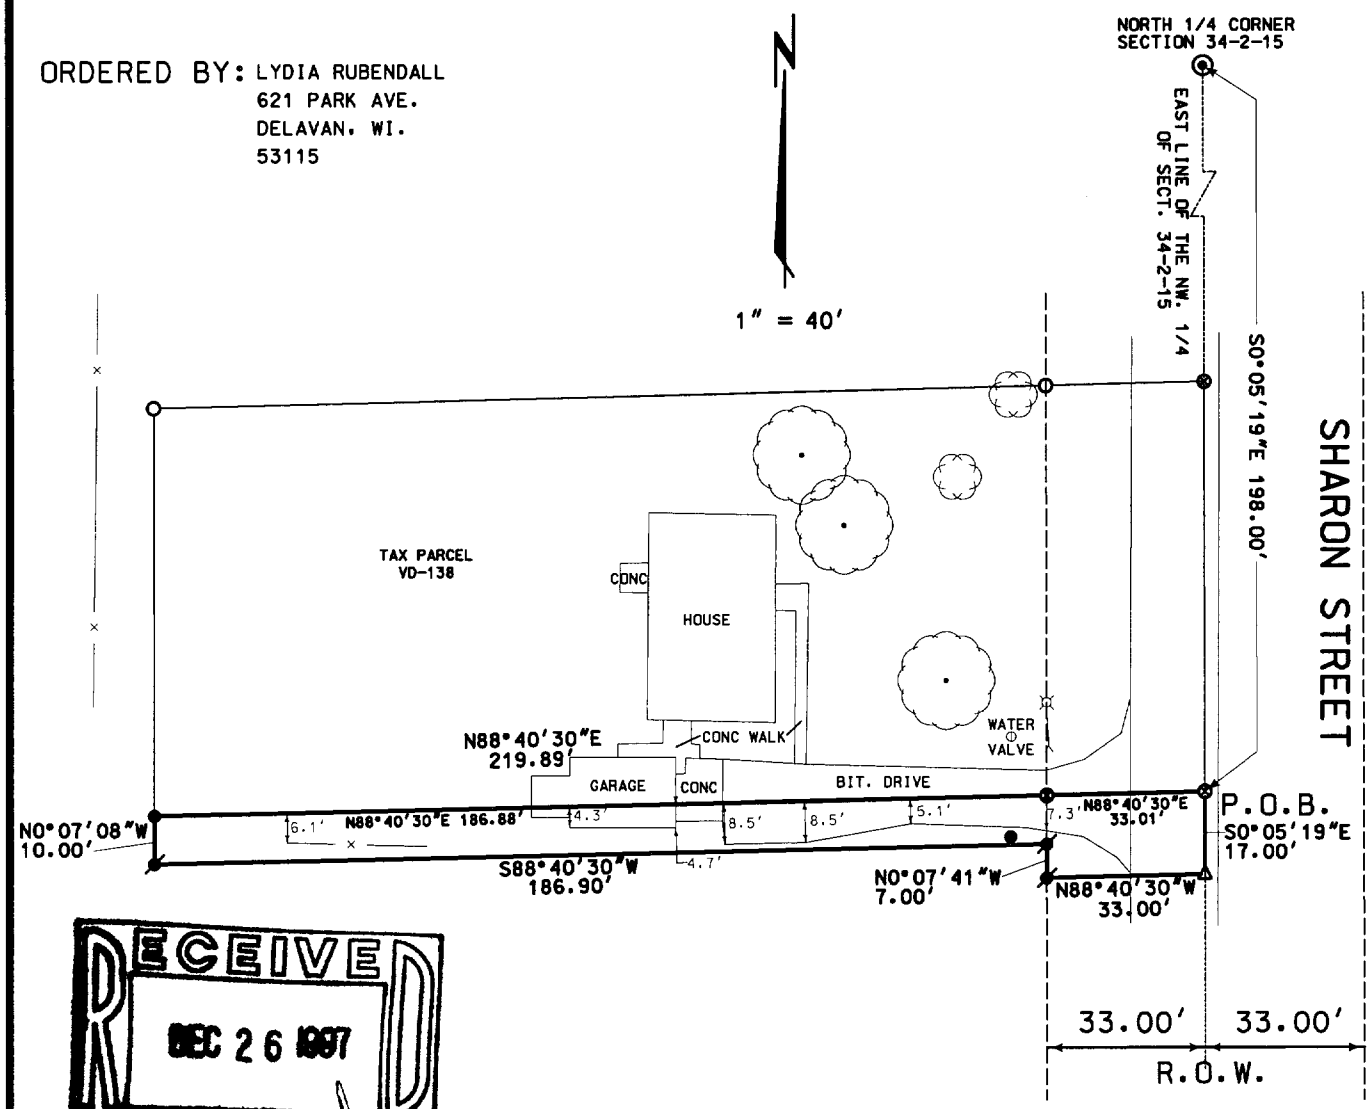

RECEIVED
DEC 26 1997

WISCONSIN
JEFFREY A. NIPPLE
S-1929
ELKHORN, WI
LAND SURVEYOR

I, JEFFREY A. NIPPLE, DO HEREBY CERTIFY THAT I HAVE SURVEYED THE PROPERTY HEREON DESCRIBED ACCORDING TO THE OFFICIAL RECORDS, AND THAT THE PLAT HEREON IS A CORRECT REPRESENTATION OF THE PROPERTY LINES TO THE BEST OF MY KNOWLEDGE AND BELIEF.

Jeffrey A. Nipple

JEFFREY A. NIPPLE
WISCONSIN REGISTERED LAND SURVEYOR, S-1929
CRISPELL - SNYDER, INC.
ELKHORN, WISCONSIN

9/19/97
DATE

LEGEND

- ⊙ FOUND CONC MON W/BRASS CAP
- ○ FOUND IRON PIPE
- ● FOUND IRON ROD
- ⊗ FOUND PK NAIL
- △ SET PK NAIL
- SET A 3/4" X 24" IRON ROD WEIGHING 1.50 lbs/LIN. FT.

QVD-138 001-352


PLAT OF SURVEY

A PARCEL OF LAND IN THE NE. 1/4 OF THE NW. 1/4 OF SECT. 34, T2N, R15E, VILLAGE OF DARIEN, WALWORTH COUNTY, STATE OF WISCONSIN, DESCRIBED AS FOLLOWS:

COMMENCING AT THE NORTH 1/4 CORNER OF SECTION 34, T2N, R15E, ; THENCE S0°05'19"E, 198.00' ALONG THE EAST LINE OF THE NW. 1/4 OF SECT. 34, T2N, R15E TO THE POINT OF BEGINNING; THENCE S88°40'30"W, 219.89'; THENCE N0°07'08"W, 84.66'; THENCE N88°35'31"E, 219.96'; THENCE S0°05'19"E, 85.00' TO THE POINT OF BEGINNING.
SAID PARCEL OF LAND CONTAINING 0.428 ACRES ±.

ORDERED BY: LYDIA RUBENDALL
621 PARK AVE.
DELAVAN, WI.
53115

RECEIVED
DEC 26 1997

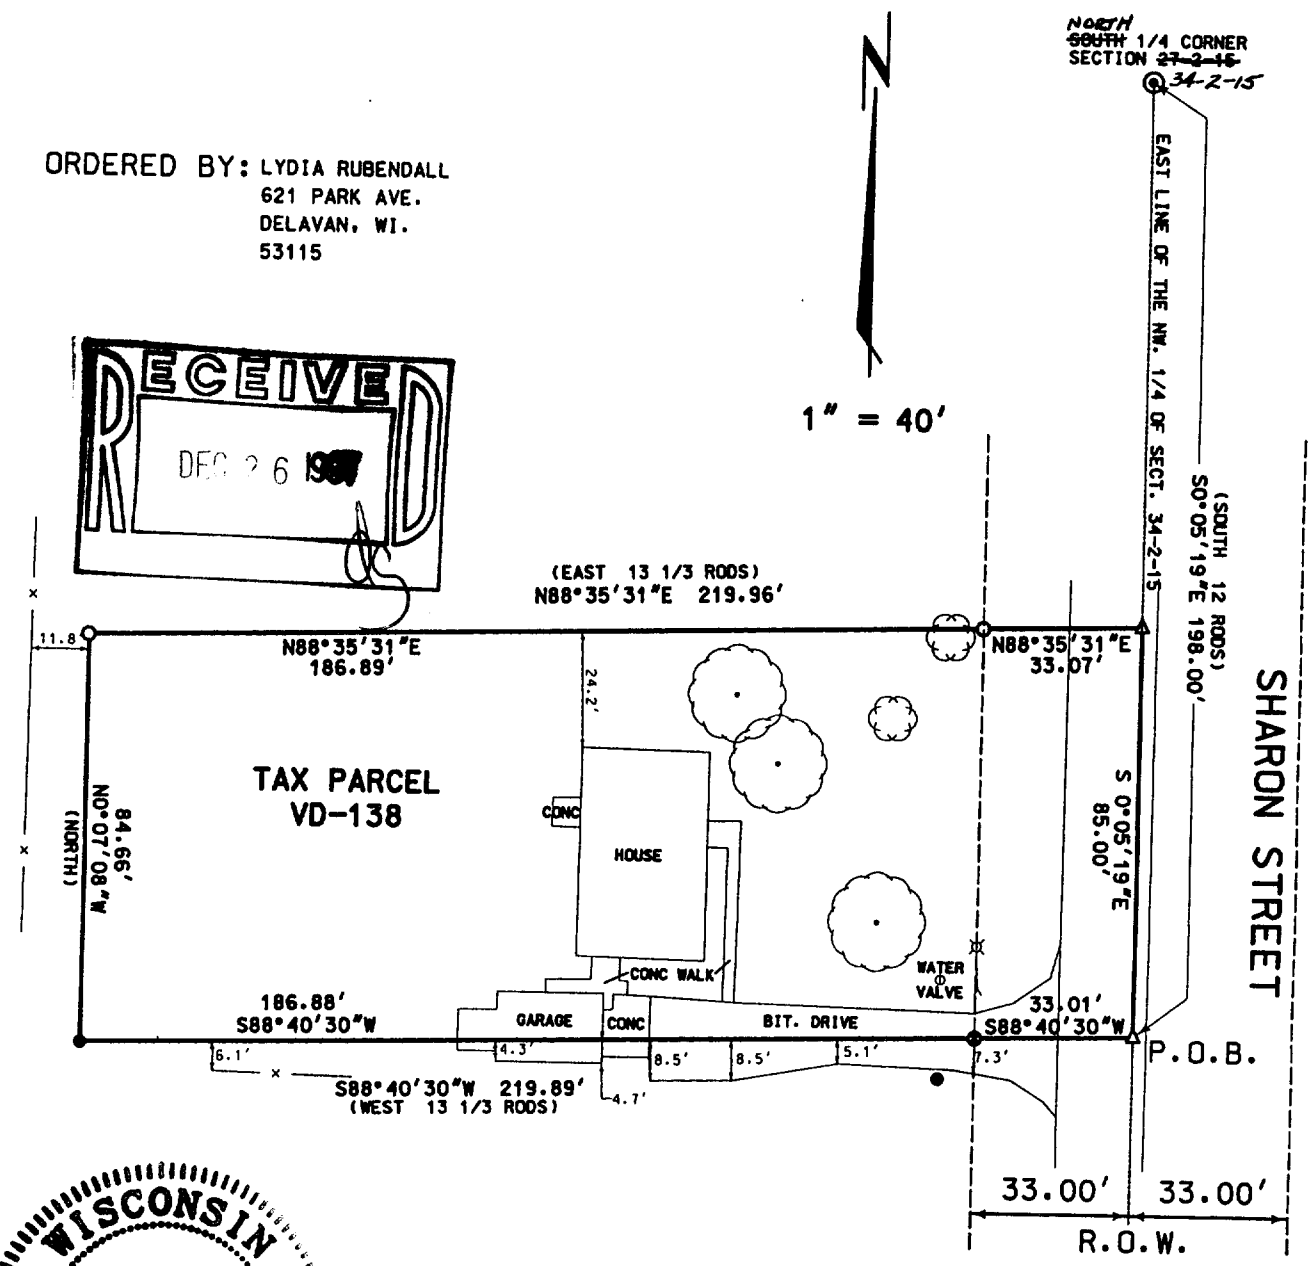

WISCONSIN
JEFFREY A. NIPPLE
S-1929
ELKHORN, WI
LAND SURVEYOR

I, JEFFREY A. NIPPLE, DO HEREBY CERTIFY THAT I HAVE SURVEYED THE PROPERTY HEREON DESCRIBED ACCORDING TO THE OFFICIAL RECORDS, AND THAT THE PLAT HEREON IS A CORRECT REPRESENTATION OF THE PROPERTY LINES TO THE BEST OF MY KNOWLEDGE AND BELIEF.

Jeffrey A Nipple

JEFFREY A. NIPPLE
WISCONSIN REGISTERED LAND SURVEYOR, S-1929
CRISPELL - SNYDER, INC.
ELKHORN, WISCONSIN

9/19/97
DATE
REVISED 9/19/97

LEGEND

- ⊙ FOUND CONC MON W/BRASS CAP
- ○ FOUND IRON PIPE
- ● FOUND IRON ROD
- ⊗ FOUND PK NAIL
- △ SET PK NAIL
- ( ) RECORDED AS