
ABELL
SURVEYING & MAPPING
1140 SEQUOIA STREET · DELAVAN, WISCONSIN 53115
262-728-6737

N

SCALE 1"=20'

LEGEND

- -IRON PIPE FOUND
- -1" DIA IRON PIPE SET
- -V CUT IN EDGE OF CONCRETE SIDEWALK
- -WOOD FENCE
- -CHAINLINK FENCE
- CS -CONCRETE STOOP
- ( )-RECORDED AS

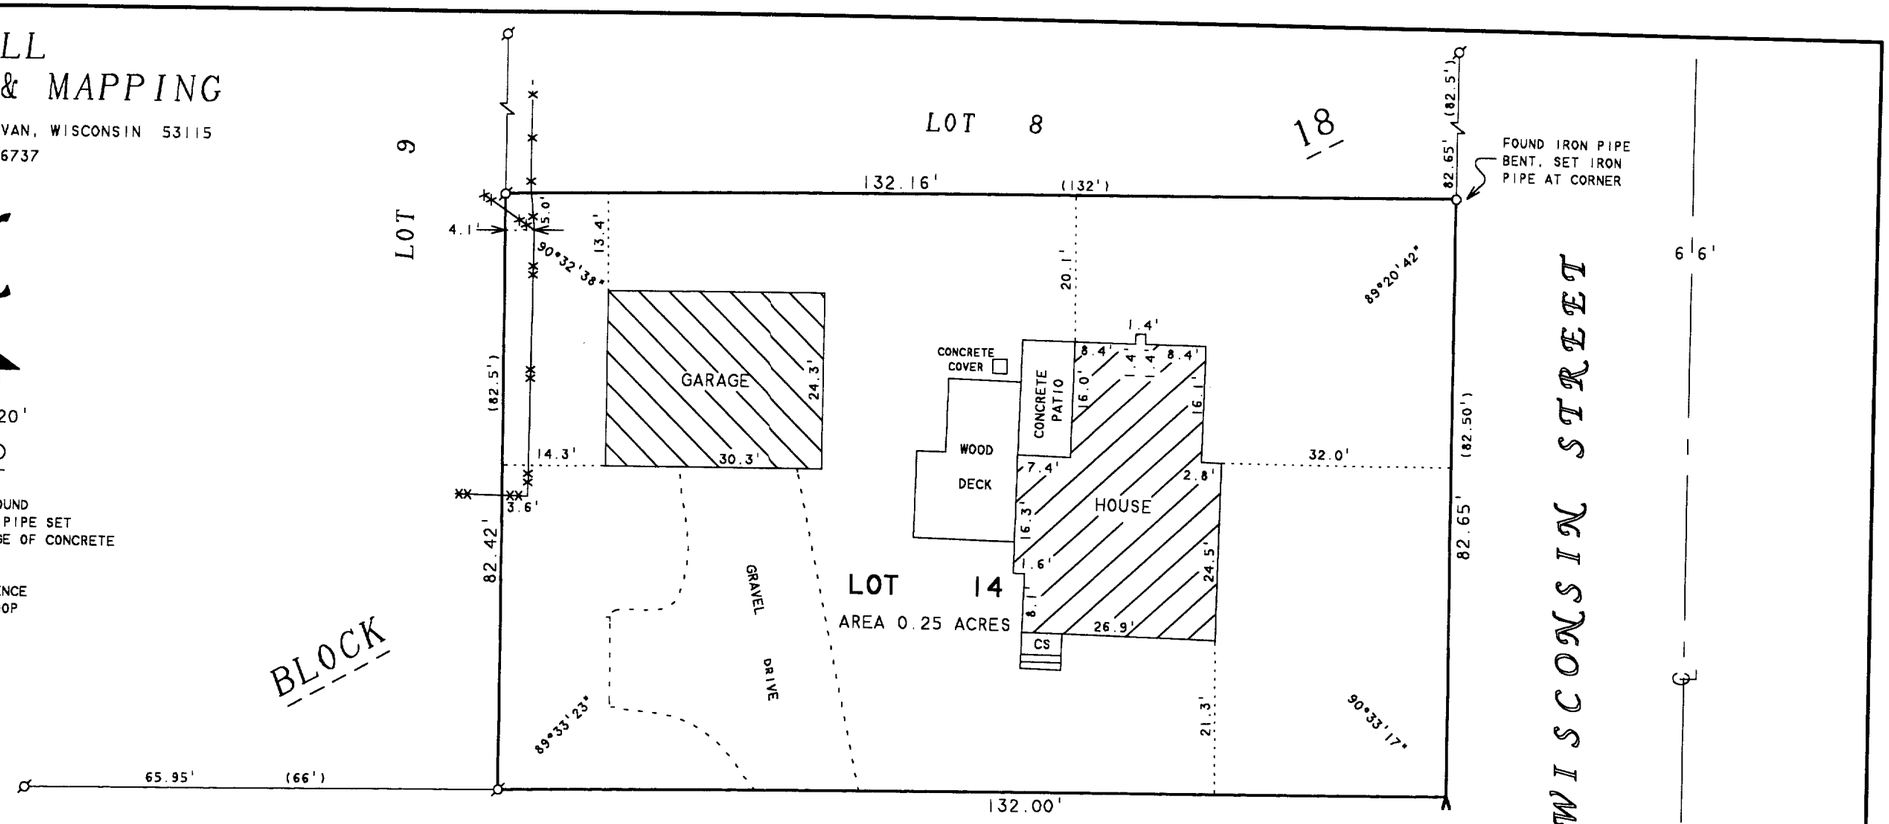

RECEIVED
MAY 10 2002

PLAT OF SURVEY OF

LOT 14, BLOCK 18, STONE & TOPPING'S ADDITION TO THE VILLAGE OF DARIEN, WALWORTH COUNTY, WISCONSIN.

ORDERED BY: CENTURY 21-SKANDIA REALTY
822 E. GENEVA STREET
DELAVAN, WI 53115

I HEREBY CERTIFY THAT I HAVE SURVEYED THE ABOVE DESCRIBED PROPERTY AND THAT THE ABOVE MAP IS A TRUE REPRESENTATION THEREOF AND SHOWS THE SIZE AND LOCATION OF THE PROPERTY, ITS EXTERIOR BOUNDARIES, THE LOCATION OF ALL VISIBLE STRUCTURES AND DIMENSIONS OF ALL PRINCIPAL BUILDINGS THEREON, BOUNDARY FENCES, APPARENT EASEMENTS, ROADWAYS AND VISIBLE ENCROACHMENTS, IF ANY, TO THE BEST OF MY KNOWLEDGE AND BELIEF.

THIS SURVEY IS MADE FOR THE USE OF THE PRESENT OWNERS OF THE PROPERTY, AND ALSO THOSE WHO PURCHASE, MORTGAGE, OR GUARANTEE THE TITLE THERETO WITHIN ONE (1) YEAR FROM DATE HEREON.

David F. Abell

DAVID F. ABELL
WISCONSIN REGISTERED LAND SURVEYOR, S-1596

January 5, 2002
DATE

JOB NUMBER - 02001

NOTE: THIS IS NOT A CERTIFIED COPY UNLESS SEALED.

QSaT-45 001-434