
DUNHAM SURVEYING, S. C.

SURVEYING & SUBDIVIDING

DELAVAN, WISCONSIN 53115



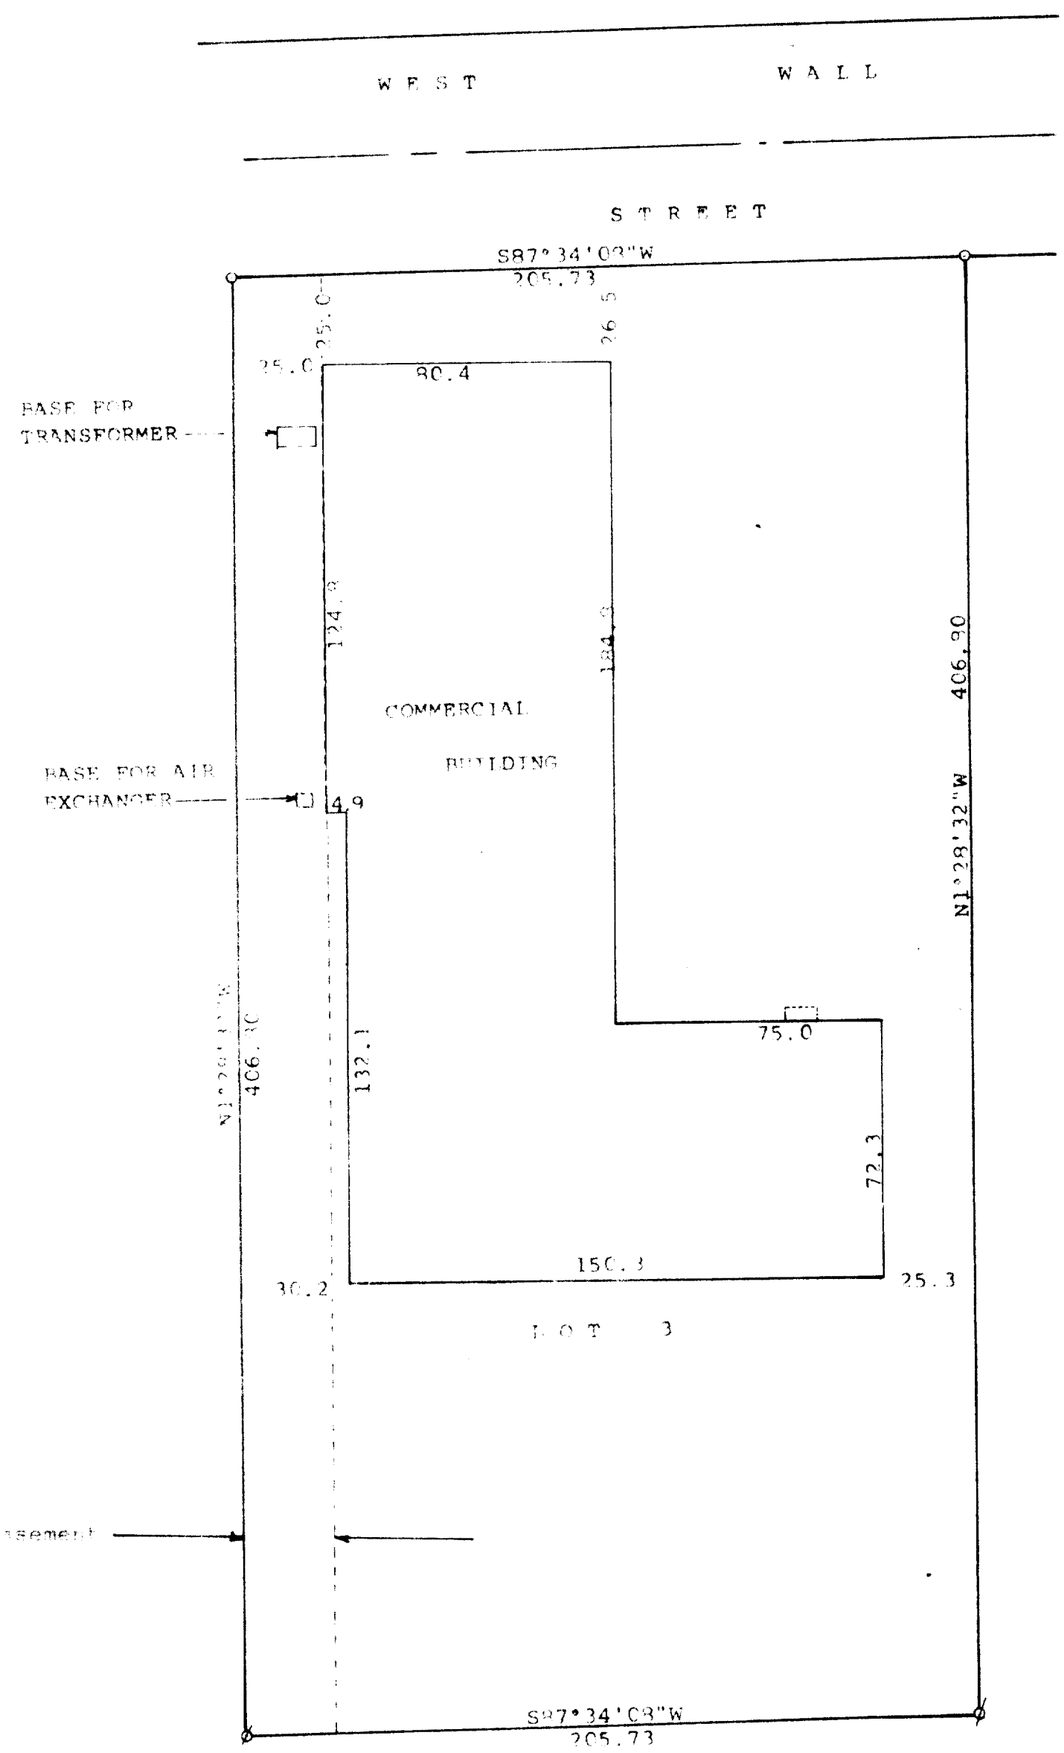

Scale - 1" = 40'
ø = 3/4" Iron Pipe Found
o = 1" Iron Pipe Found
Bearings are those on the recorded plat of Certified Survey Map No. 1921
Survey for: L C Products, Inc.
523 West Wall
Darien, WI 53114

STATE OF WISCONSIN)
COUNTY OF WALWORTH) SS

I, George T. Dunham, Surveyor, certify that I have surveyed the property described as follows:

Lot 3 of Certified Survey No. 1921, recorded in Volume 9 of Certified Surveys, on page 131, Document No. 191920, Walworth County Records, on March 27, 1990, in the Office of Register of Deeds, Elkhorn, Wisconsin and being a parcel of land located in the Northeast ¼ of the Southeast ¼ of Section 28, T 2 N, R 15 E, Walworth County, Wisconsin,

and that the plat shown hereon is a correct representation thereof and shows the size and location of the property, its exterior boundaries, the location of all visible structures and dimensions of all principal buildings thereon, boundary fences, apparent easements, roadways and visible encroachments, if any, and that I have surveyed the property hereon described, according to the official records, to the best of my knowledge and belief.

April 9, 1997
Revised April 11, 1997

George T. Dunham, Surveyor

WISCONSIN LAND SURVEYOR S-500 DELAVAN WIS.

RECEIVED
APR 9 2003
DRP

545273

GMB 1020

QA1921-3

001-457