PREPARED FOR:
COLDWELL BANKERS PRIMUS
c\o KAREN PEARCE
1823 E. GENEVA ST.
DELAVAN , WI
53115

PLAT OF SURVEY


- OF -

LOT 3 AND THE WEST 1/2 OF THE NORTH 1/2 OF LOT 2
BLOCK 18, STONE AND TOPPING'S ADDITION TO THE
VILLAGE OF DARIEN, WALWORTH COUNTY, WISCONSIN.

PATHFINDER SURVEYING INC.
N3705 WILLOW BEND LANE
LAKE GENEVA WI. 53147
(262) 248-3697

C.L. JEFFERSON STREET

(66' WIDE ROAD)

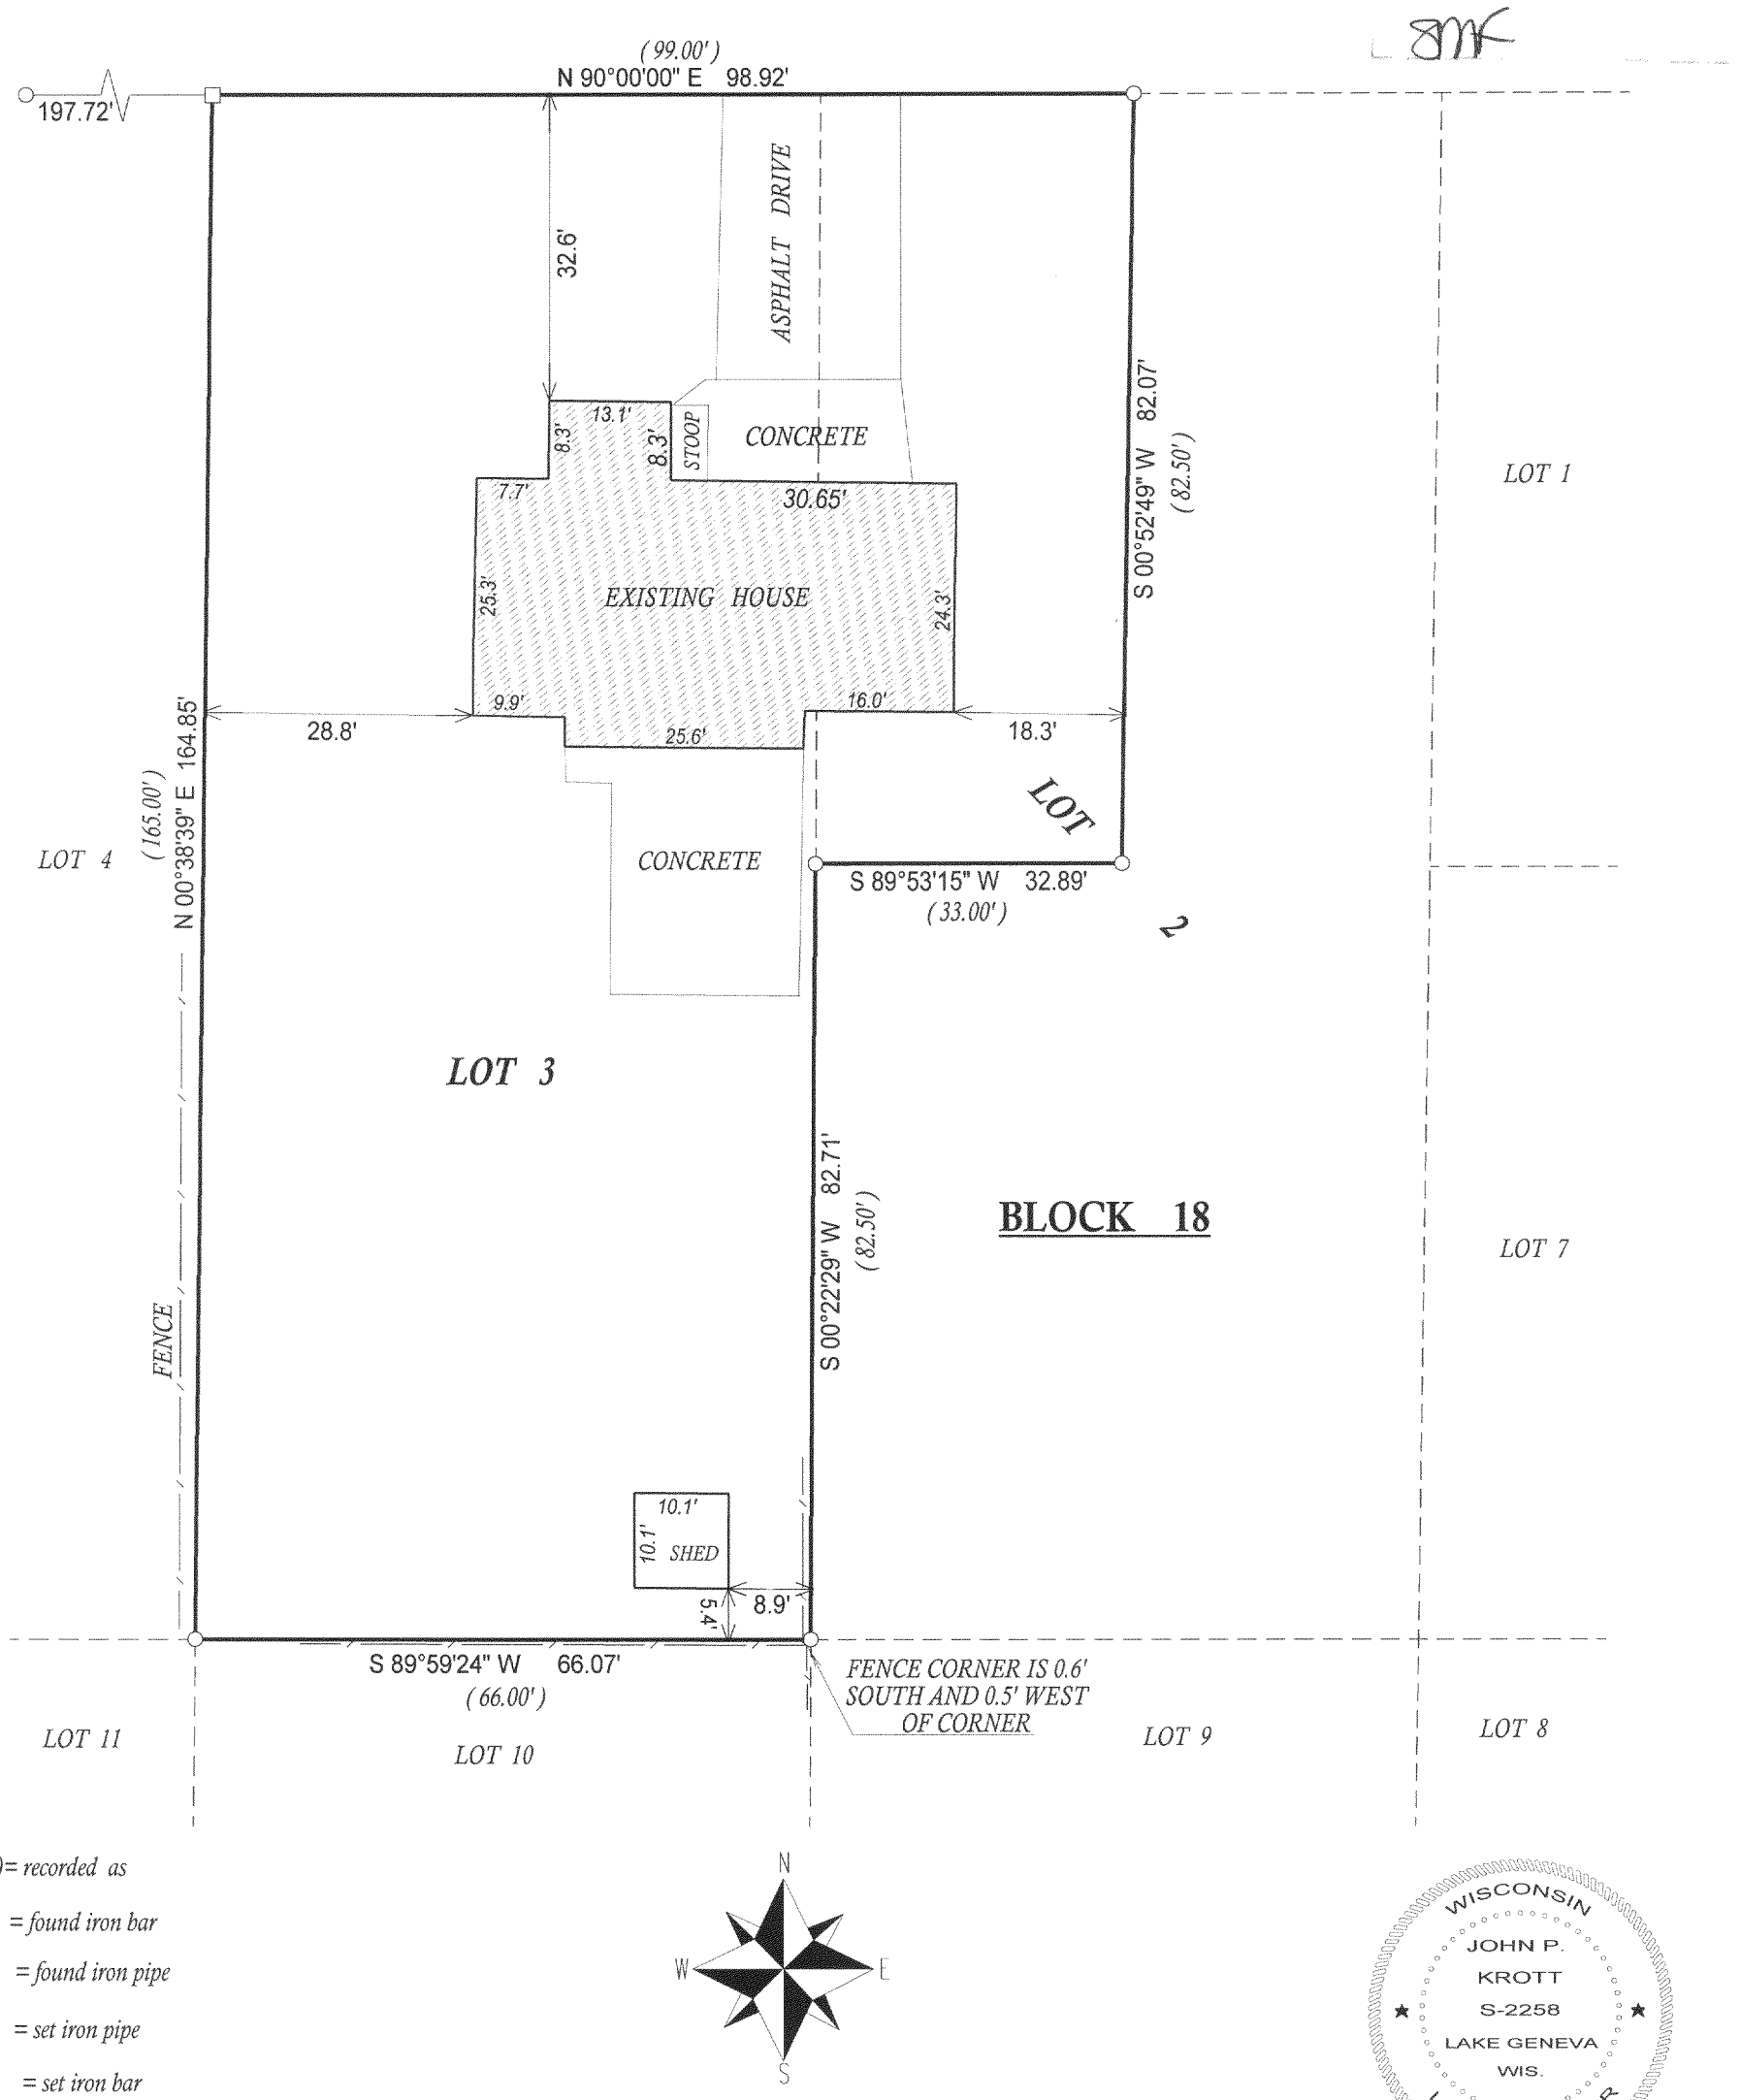

( )= recorded as

= found iron bar

= found iron pipe

= set iron pipe

= set iron bar

SCALE 1" = 20'

JOB # 05-620

TAX ID # QS&T00035A

N
W E
S

COMPARE LEGAL DESCRIPTION ABOVE AND DRAWING WITH DEED. FOR BUILDING RESTRICTIONS AND EASEMENTS NOT SHOWN,REFER TO DEED, ABSTRACT SOURCES AND LOCAL MUNICIPAL CODES. NOTIFY THE SURVEYOR IMMEDIATELY OF ANY DISCREPANCY.

"I hereby certify that I have surveyed the above described property and that the above map, to the best of my knowledge and belief, is a true representation thereof and shows the size and location of all visible structures, apparent easements and encroachmentsif any."
This survey is made for the present owners of the property, and those who purchase, mortgage, or guarentee the title thereto, within one year from the date hereof.

WISCONSIN
JOHN P.
KROTT
S-2258
LAKE GENEVA
WIS.
LAND SURVEYOR

JOHN KROTT S - 2258
Wisconsin Registered Land Surveyor
(original if signed in red)
DATED THIS THE 29th DAY OF NOVEMBER 2005.

QS+T-35A

001-514