


# Plat of Survey

## of Lots 25 and 26 of The Ponds of Darien,

a subdivision located in the Northeast 1/4 of Section 27, Town 2 North,  
Range 15 East, Village of Darien, Walworth County, Wisconsin.

Surveyed for: **Dennis & Sadie Gunnink**  
N3752 County Road C  
Darien, Wisconsin. 53114

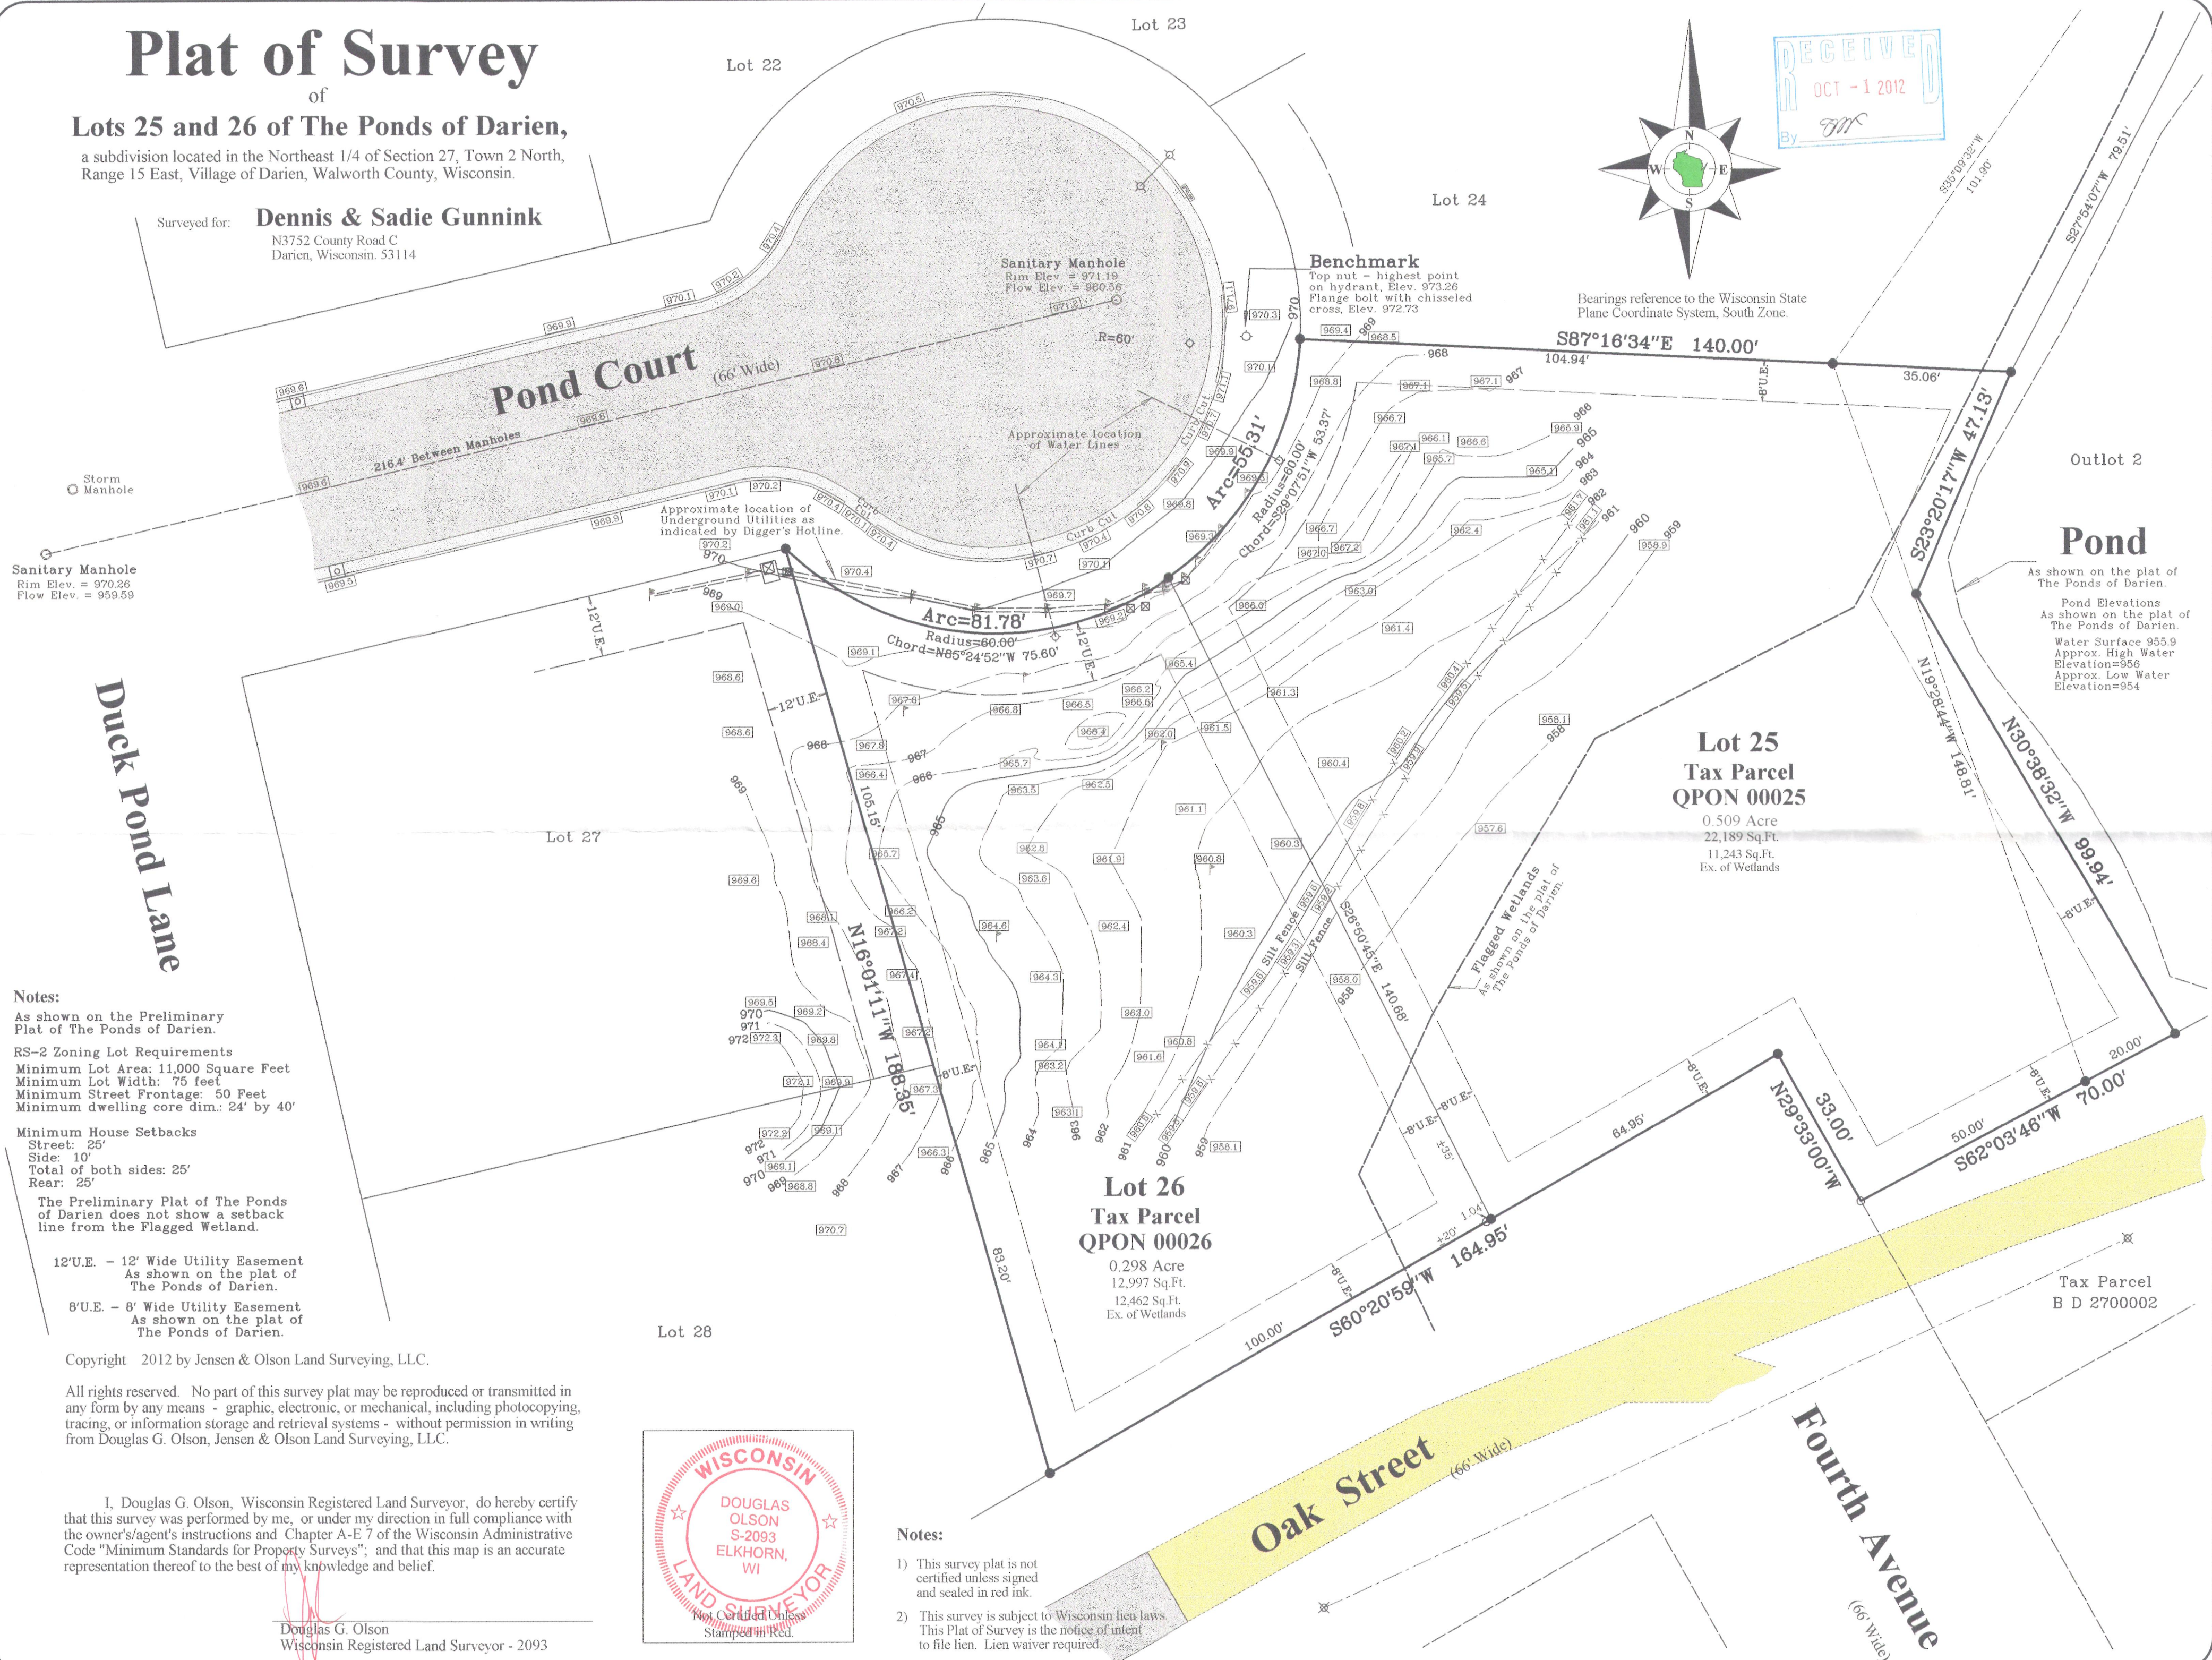

QPON-25 QPON-26

001-565