


Plat of Survey

of
Lots 25 and 26 of The Ponds of Darien,
a subdivision located in the Northeast 1/4 of Section 27, Town 2 North,
Range 15 East, Village of Darien, Walworth County, Wisconsin.

Surveyed for: **Dennis & Sadie Gunnink**
N3752 County Road C
Darien, Wisconsin. 53114

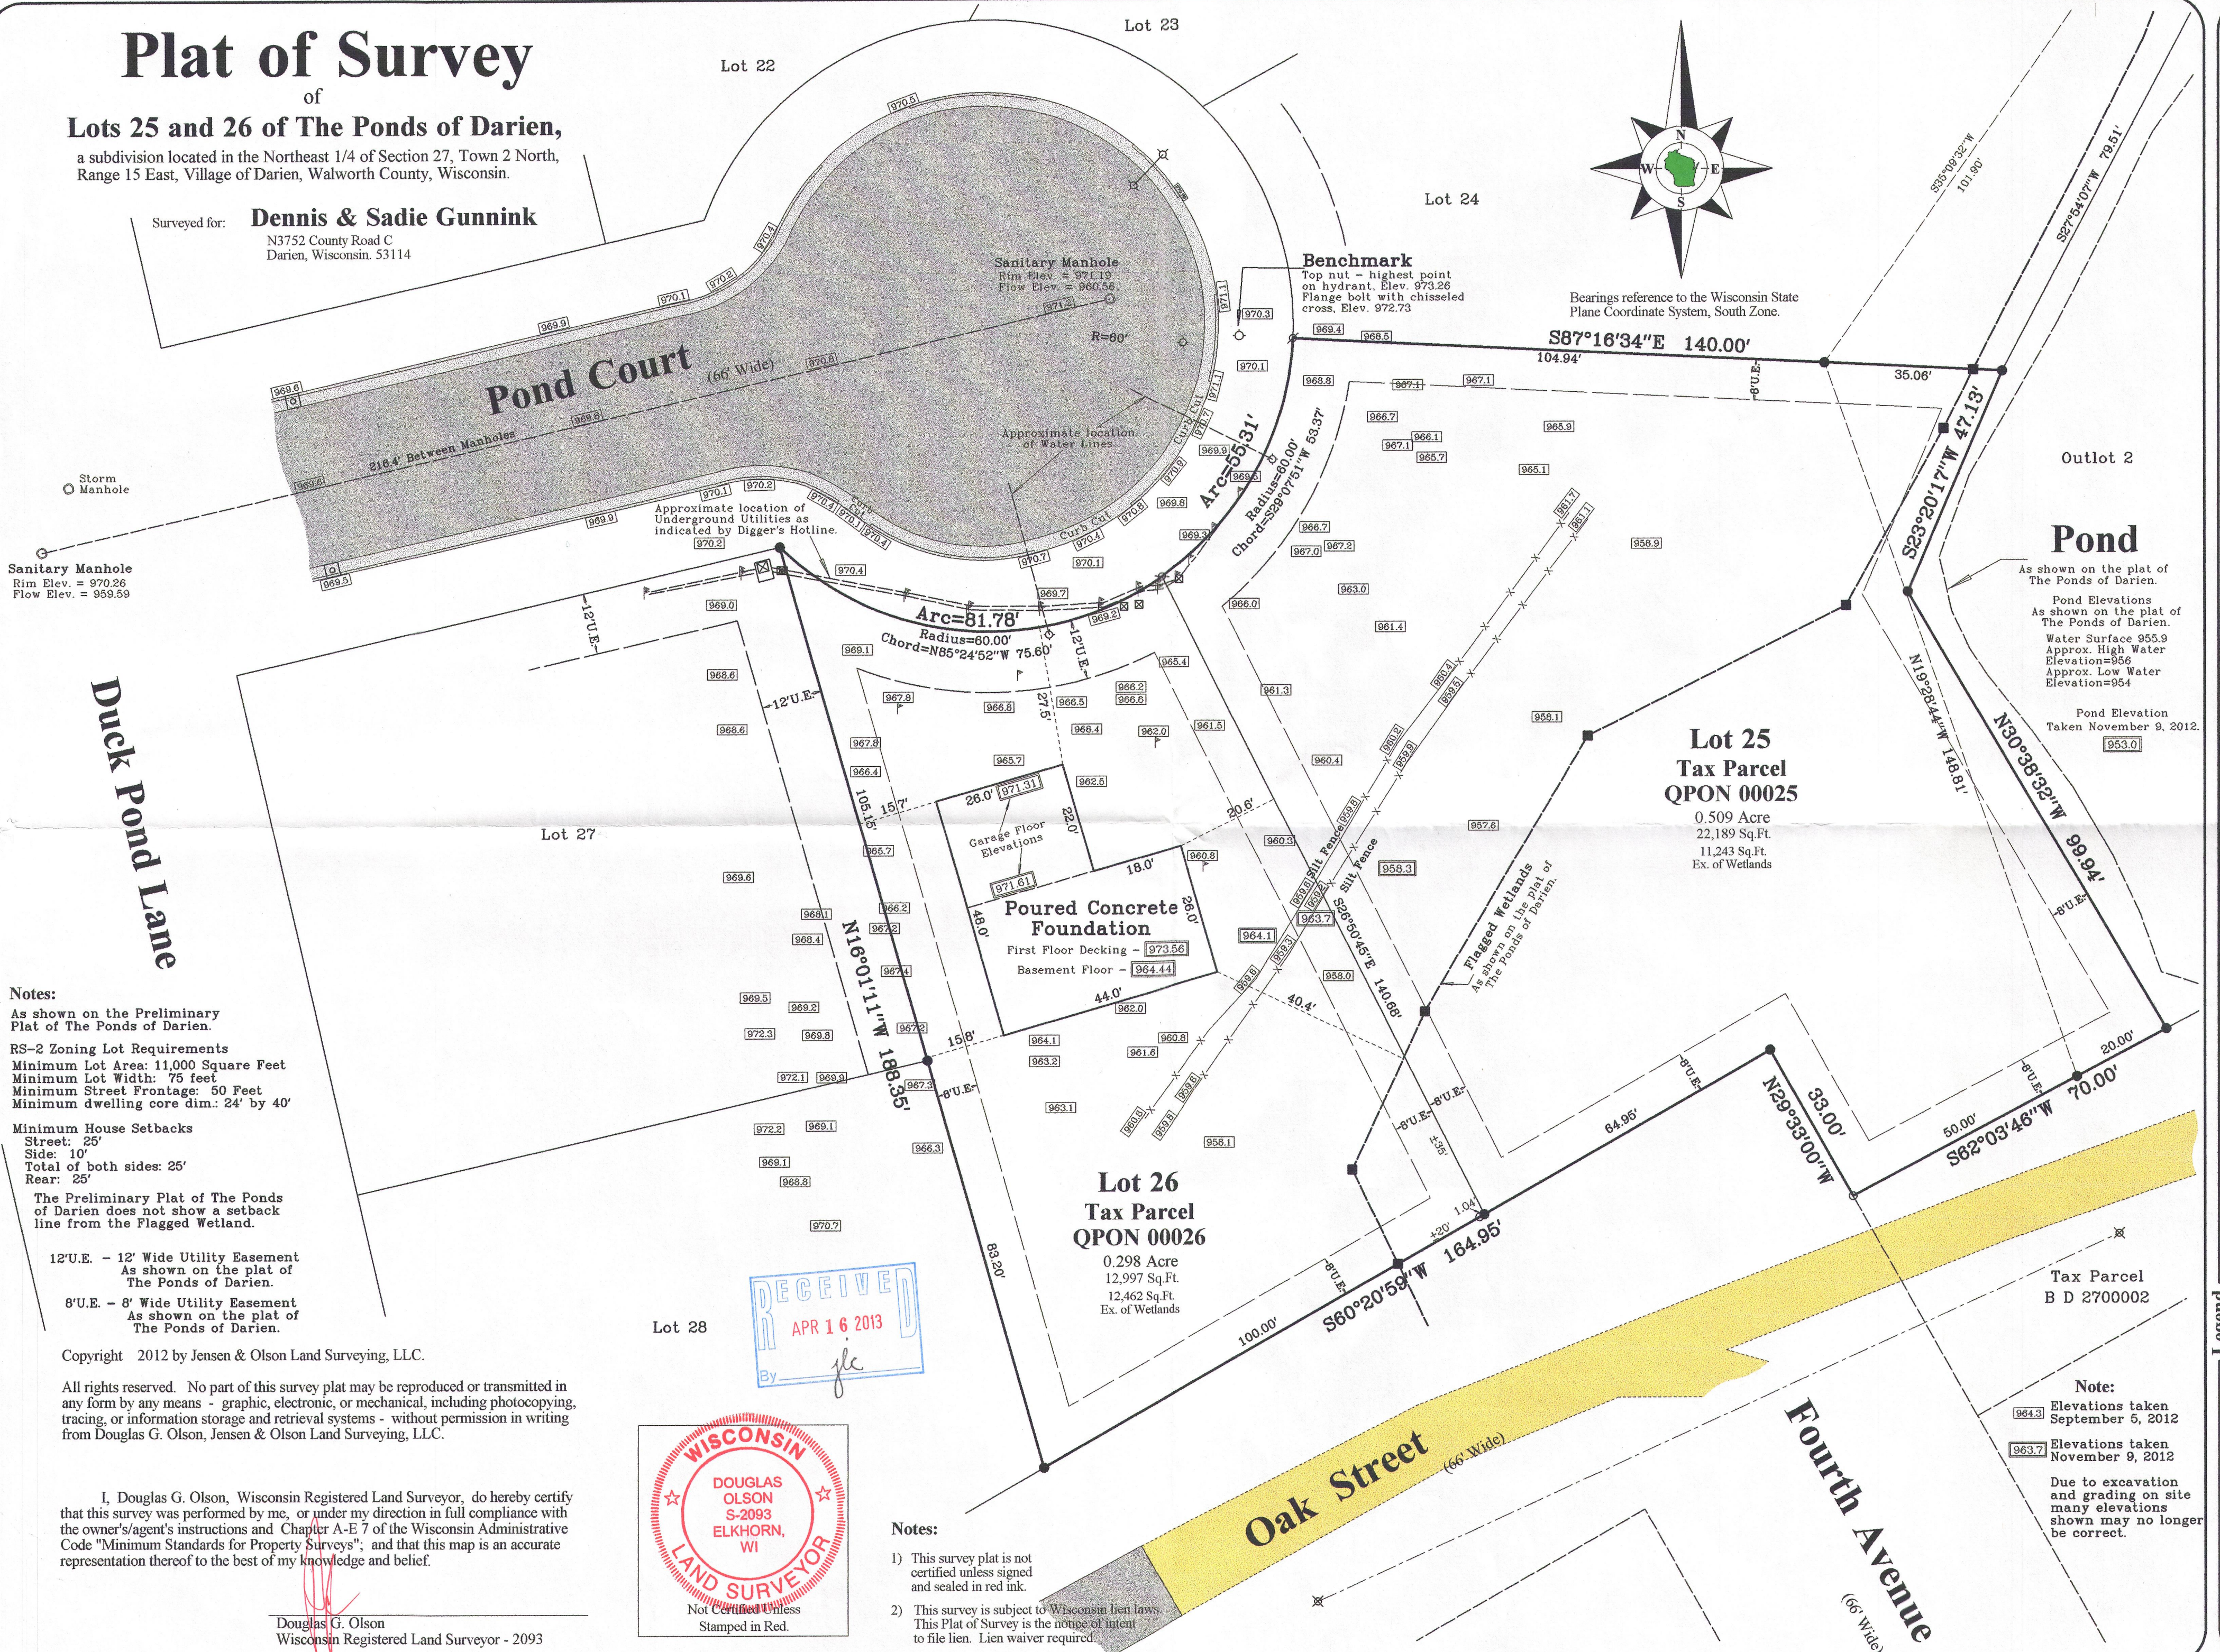

QPON 00025
QPON 00026

001-574