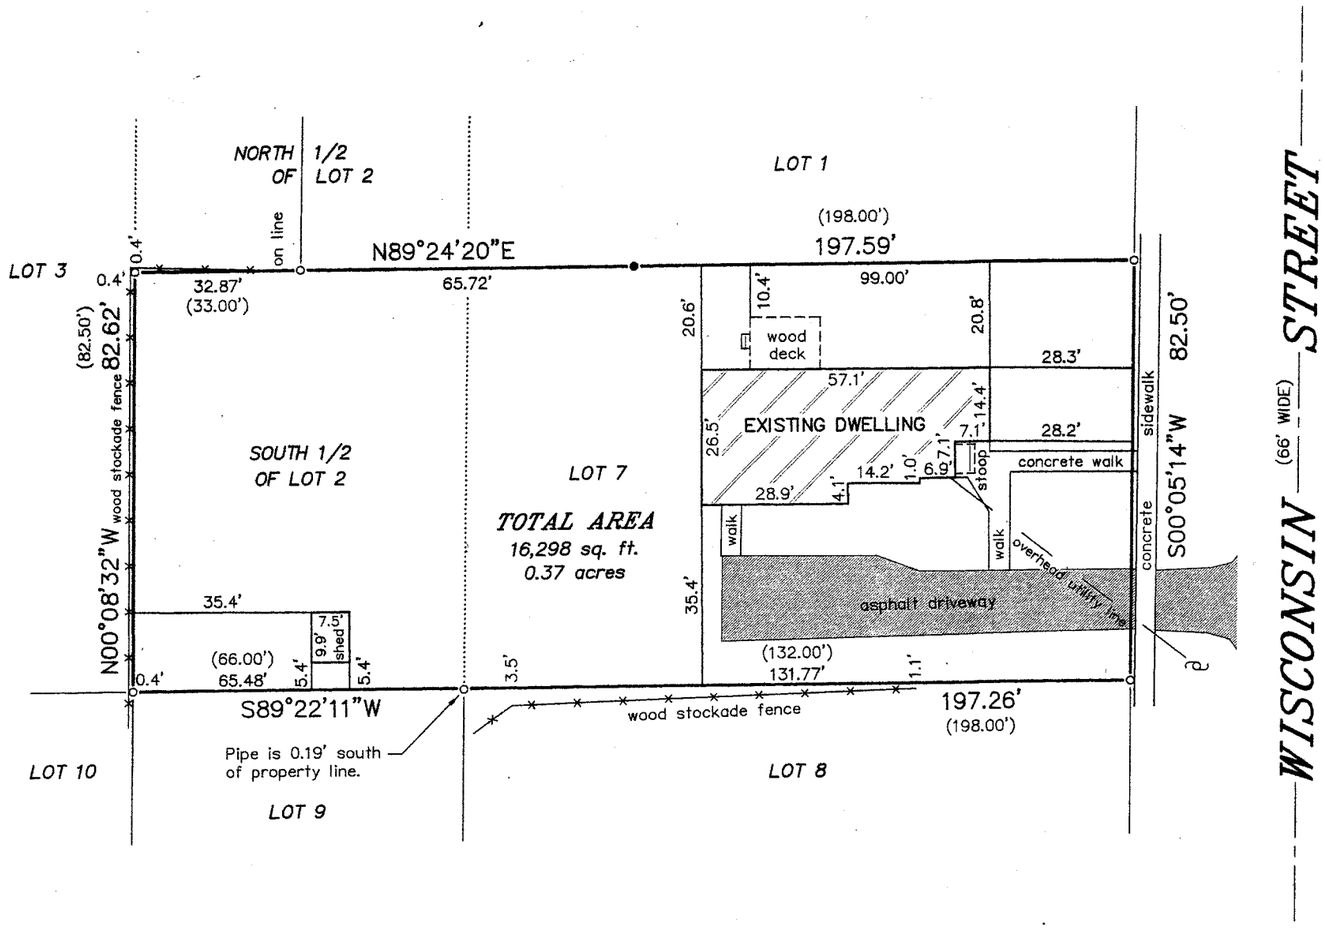

BEARINGS HEREON RELATE TO THE NORTH LINE OF LOT 7 IN BLOCK 18 OF STONE & TOPPING'S ADDITION TO THE VILLAGE OF DARIEN. ASSUMED BEARING OF NORTH 89°24'20" EAST TO ORIENTATE WITH A PREVIOUS SURVEY BY DUNHAM SURVEYING, S.C. DATED NOVEMBER 24, 1992.

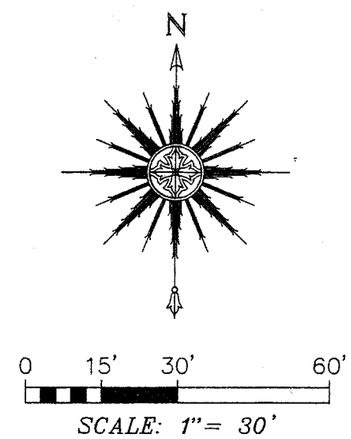

LEGEND

- ○ FOUND IRON PIPE
- ● SET IRON PIPE
- UTILITY POLE
- ( ) RECORDED AS

WISCONSIN
THOMAS L. SATTER
S-2850
BURLINGTON, WI
LAND SURVEYOR

THIS IS NOT AN ORIGINAL PRINT UNLESS THIS SEAL IS RED.

"I HEREBY CERTIFY THAT I HAVE SURVEYED THE ABOVE DESCRIBED PROPERTY AND THAT THE ABOVE MAP IS A CORRECT REPRESENTATION THEREOF AND SHOWS THE SIZE AND LOCATION OF THE PROPERTY, ITS EXTERIOR BOUNDARIES, THE LOCATION OF ALL VISIBLE STRUCTURES AND DIMENSIONS OF ALL PRINCIPAL BUILDINGS THEREON, BOUNDARY FENCES, APPARENT EASEMENTS, ROADWAYS AND ENCROACHMENTS, IF ANY."

"THIS SURVEY IS MADE FOR THE USE OF THE PRESENT OWNERS OF THE PROPERTY, AND THOSE WHO PURCHASE, MORTGAGE, OR GUARANTEE THE TITLE THERETO WITHIN ONE YEAR FROM DATE HEREOF."

SATTER SURVEYING, LLC
LAND SURVEYS, MAPPING AND PLANNING
272 ORIGEN STREET
BURLINGTON, WI 53105
262-661-4239

PLAT OF SURVEY
-OF-

LOT 7 AND THE SOUTH 1/2 OF LOT 2, BLOCK 18, STONE AND TOPPINGS ADDITION TO THE VILLAGE OF DARIEN. SAID LAND BEING IN THE VILLAGE OF DARIEN, COUNTY OF WALWORTH AND THE STATE OF WISCONSIN.

SURVEY FOR: CHRISTOPHER PHILLIPS OF SHOREWEST REALTORS, INC.
SURVEY ADDRESS: 220 N. WISCONSIN STREET, DARIEN, WI 53114

RECEIVED
APR 8 2014
By gle

Thomas L. Satter
THOMAS L. SATTER S-2850

MARCH 31, 2014 — DATE
031404 — JOB NUMBER

Q88T -38

001-580