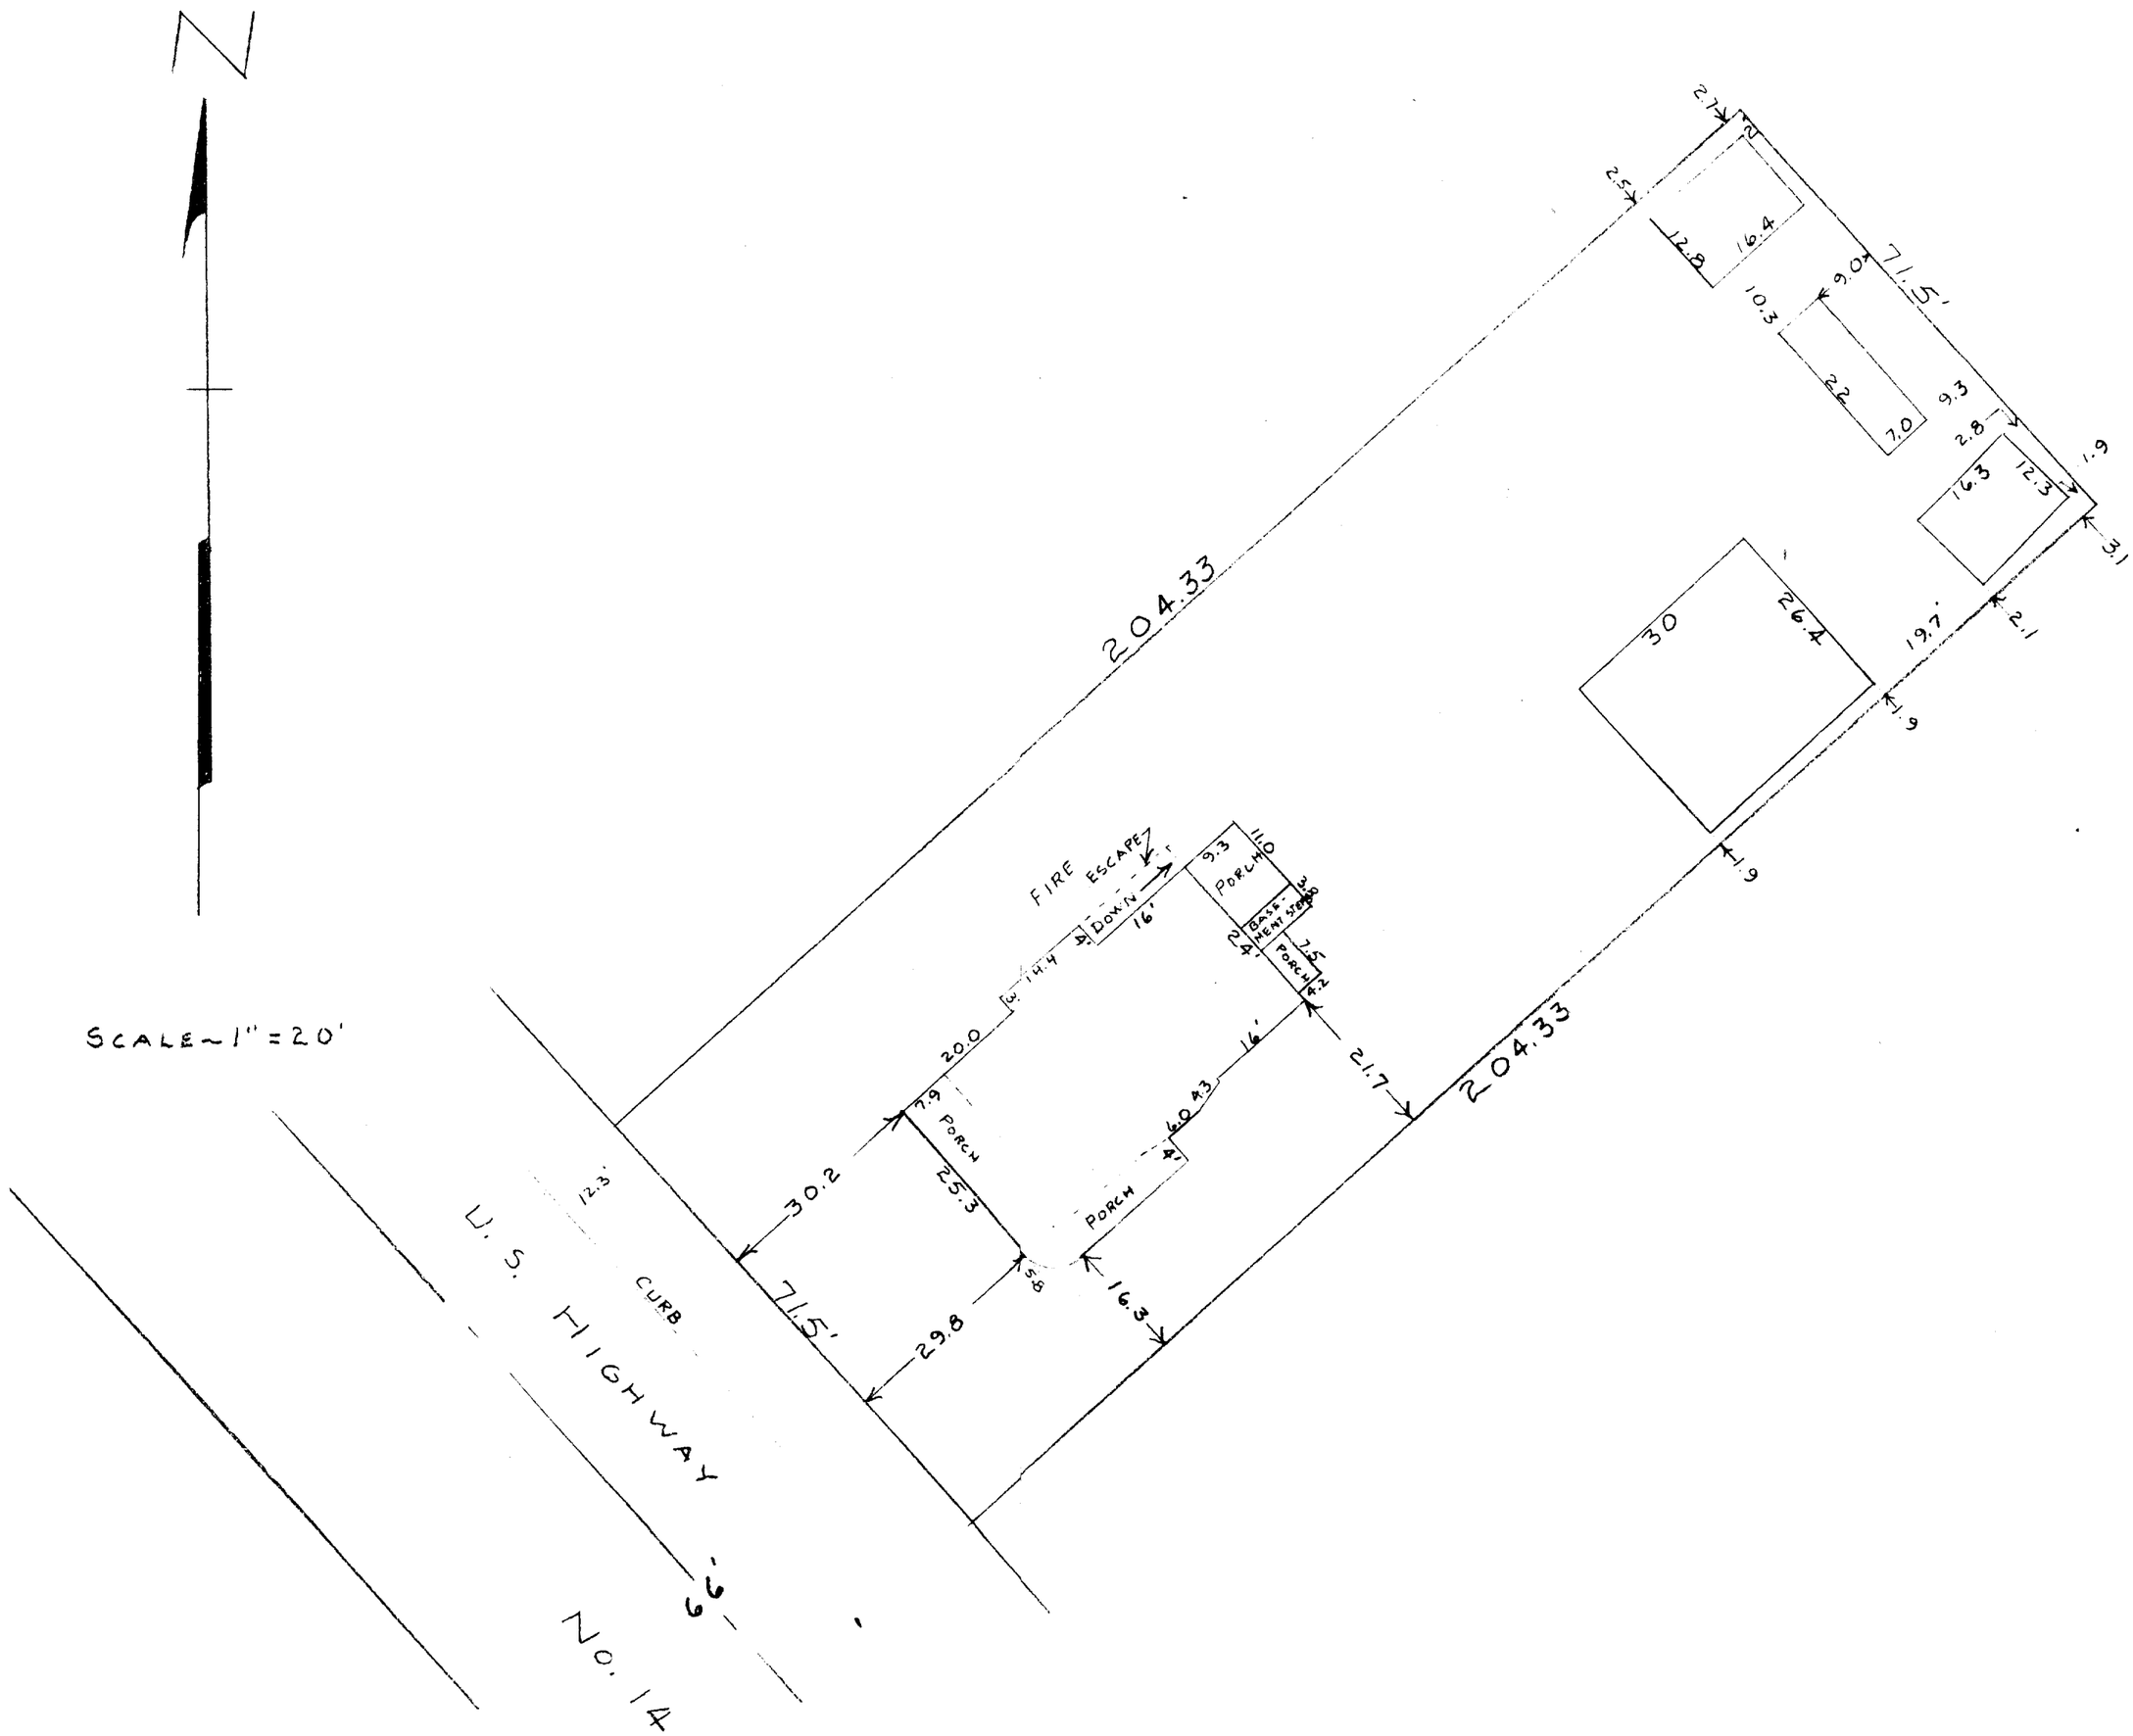

PLAT SHOWING THE LOCATION OF THE BUILDINGS LOCATED ON THE PROPERTY KNOWN AS THE "DARIEN REST HOME" AND OWNED BY R.H AND RUTH E. HELLER IN THE VILLAGE OF DARIEN, WALWORTH COUNTY, WISCONSIN
JAN. 30, 1959

GEORGE T. DUNHAM, SURVEYOR
DELAVAN, WISCONSIN

1-9

VD-63