


STREET

2ND

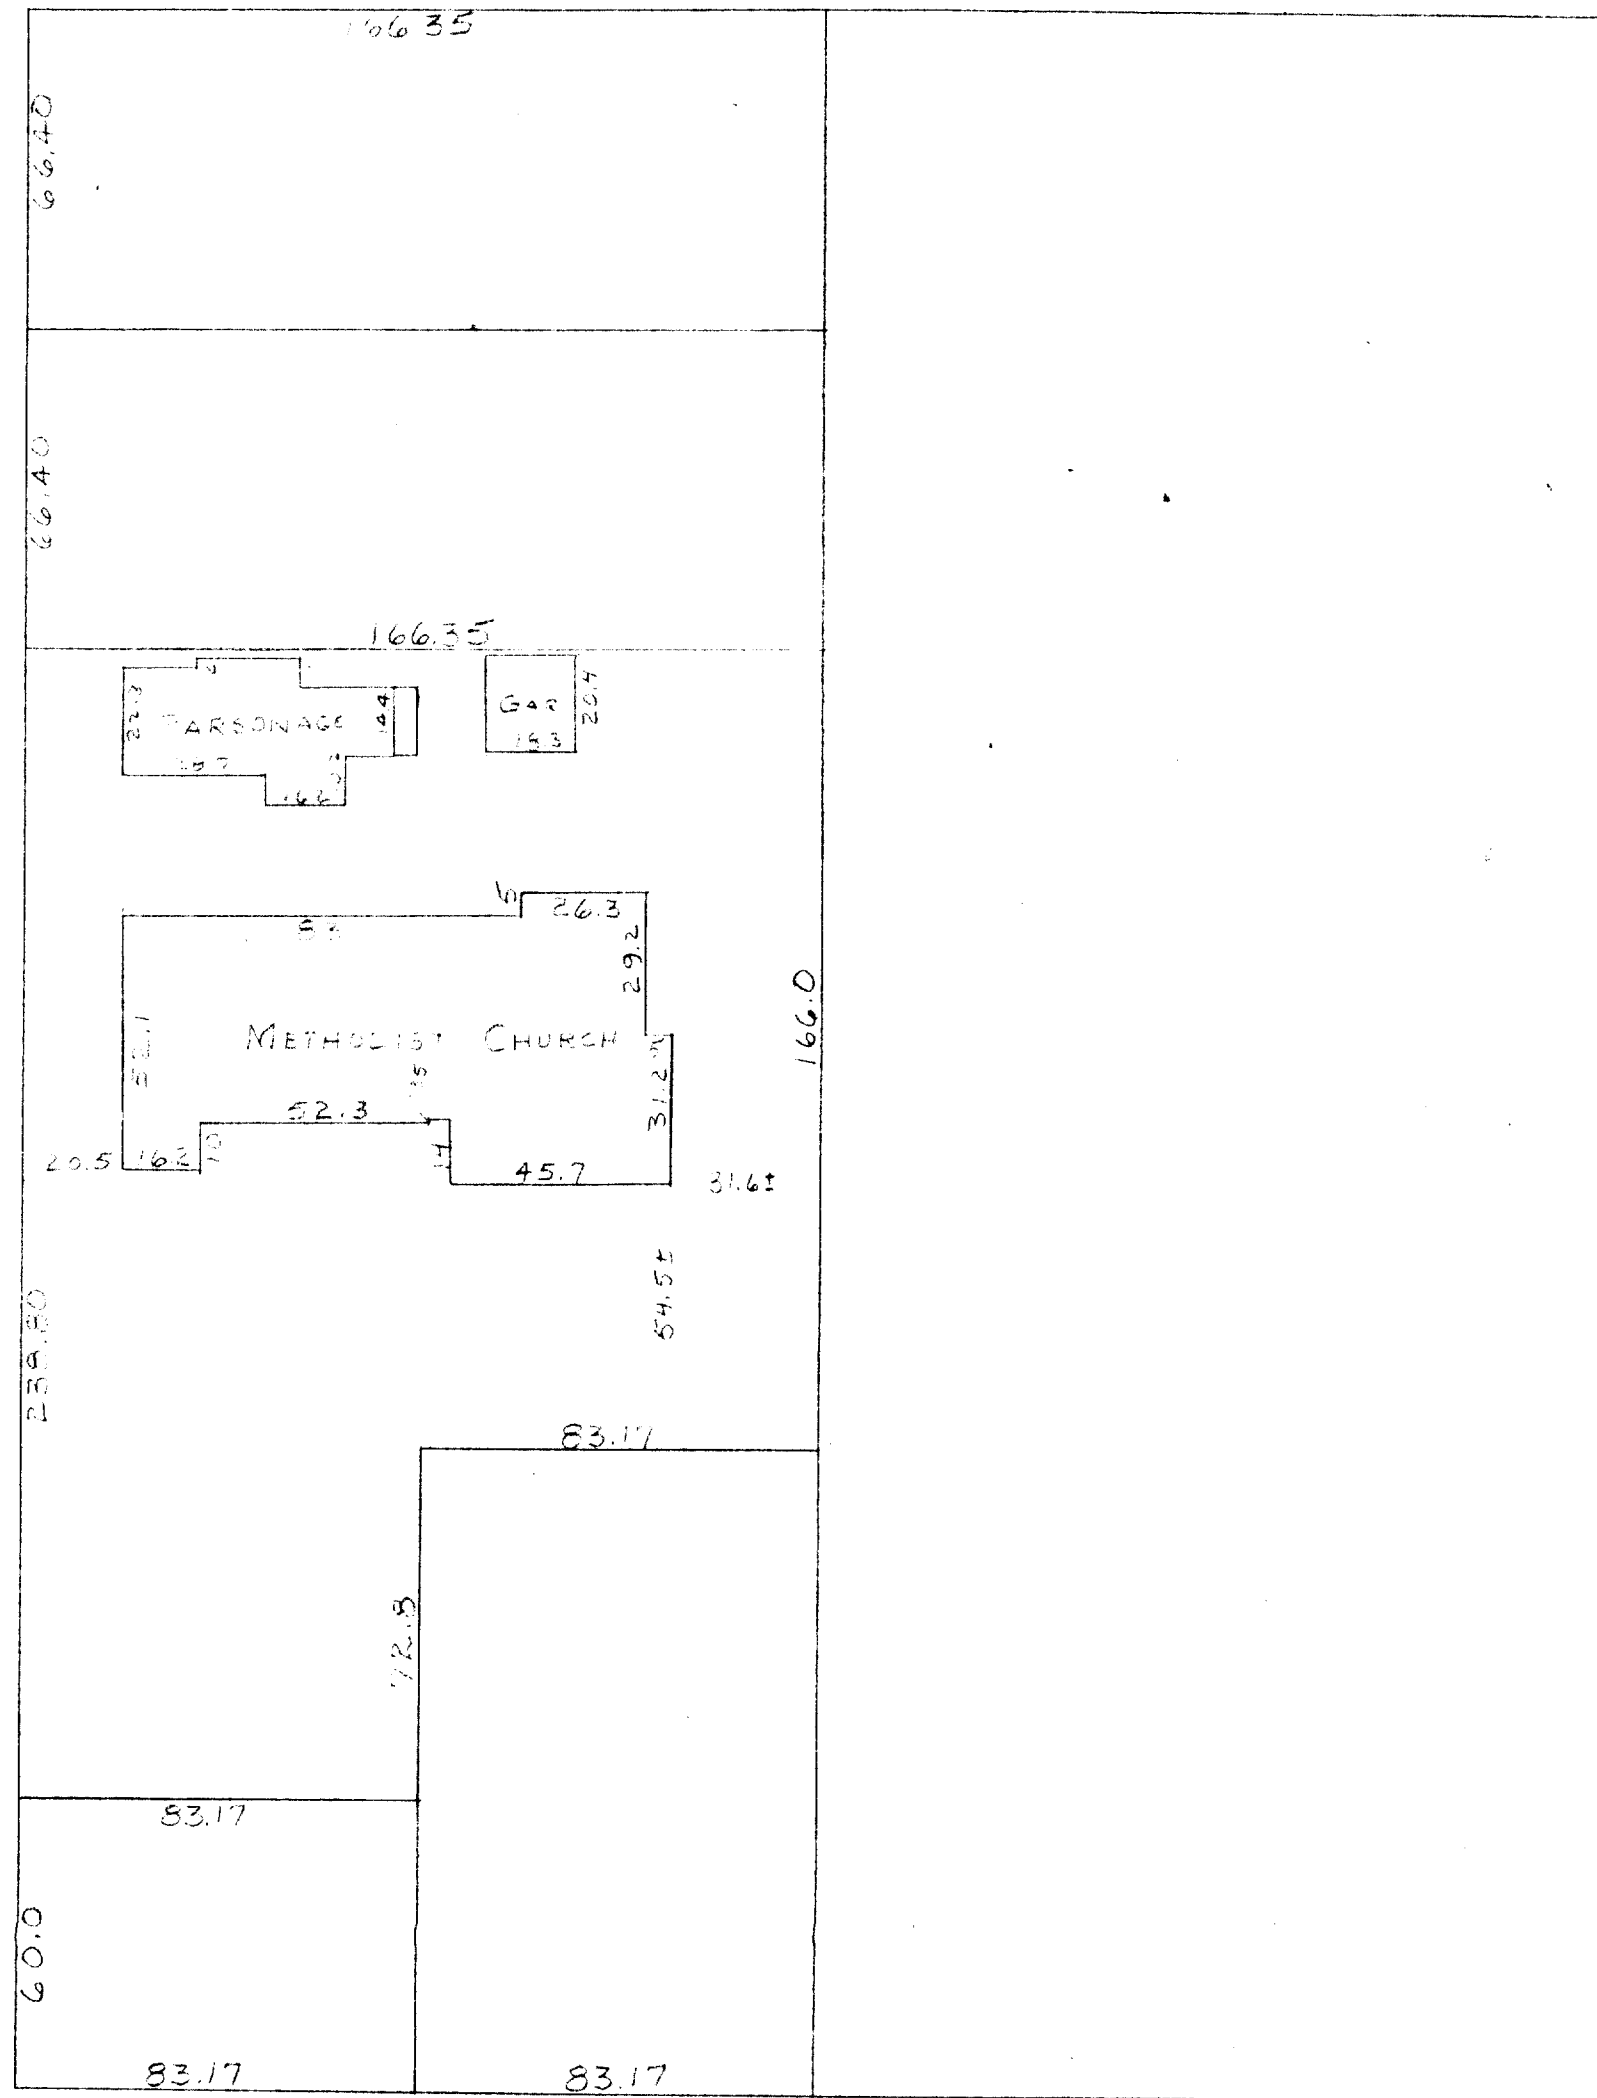

WISCONSIN STREET



SCALE-1"=40'

XOP-184, 186

XWUP-184, 185, 186, 190

2-109