
ABELL
SURVEYING & MAPPING
DELAVAN. WISCONSIN 53115
414-728-6737

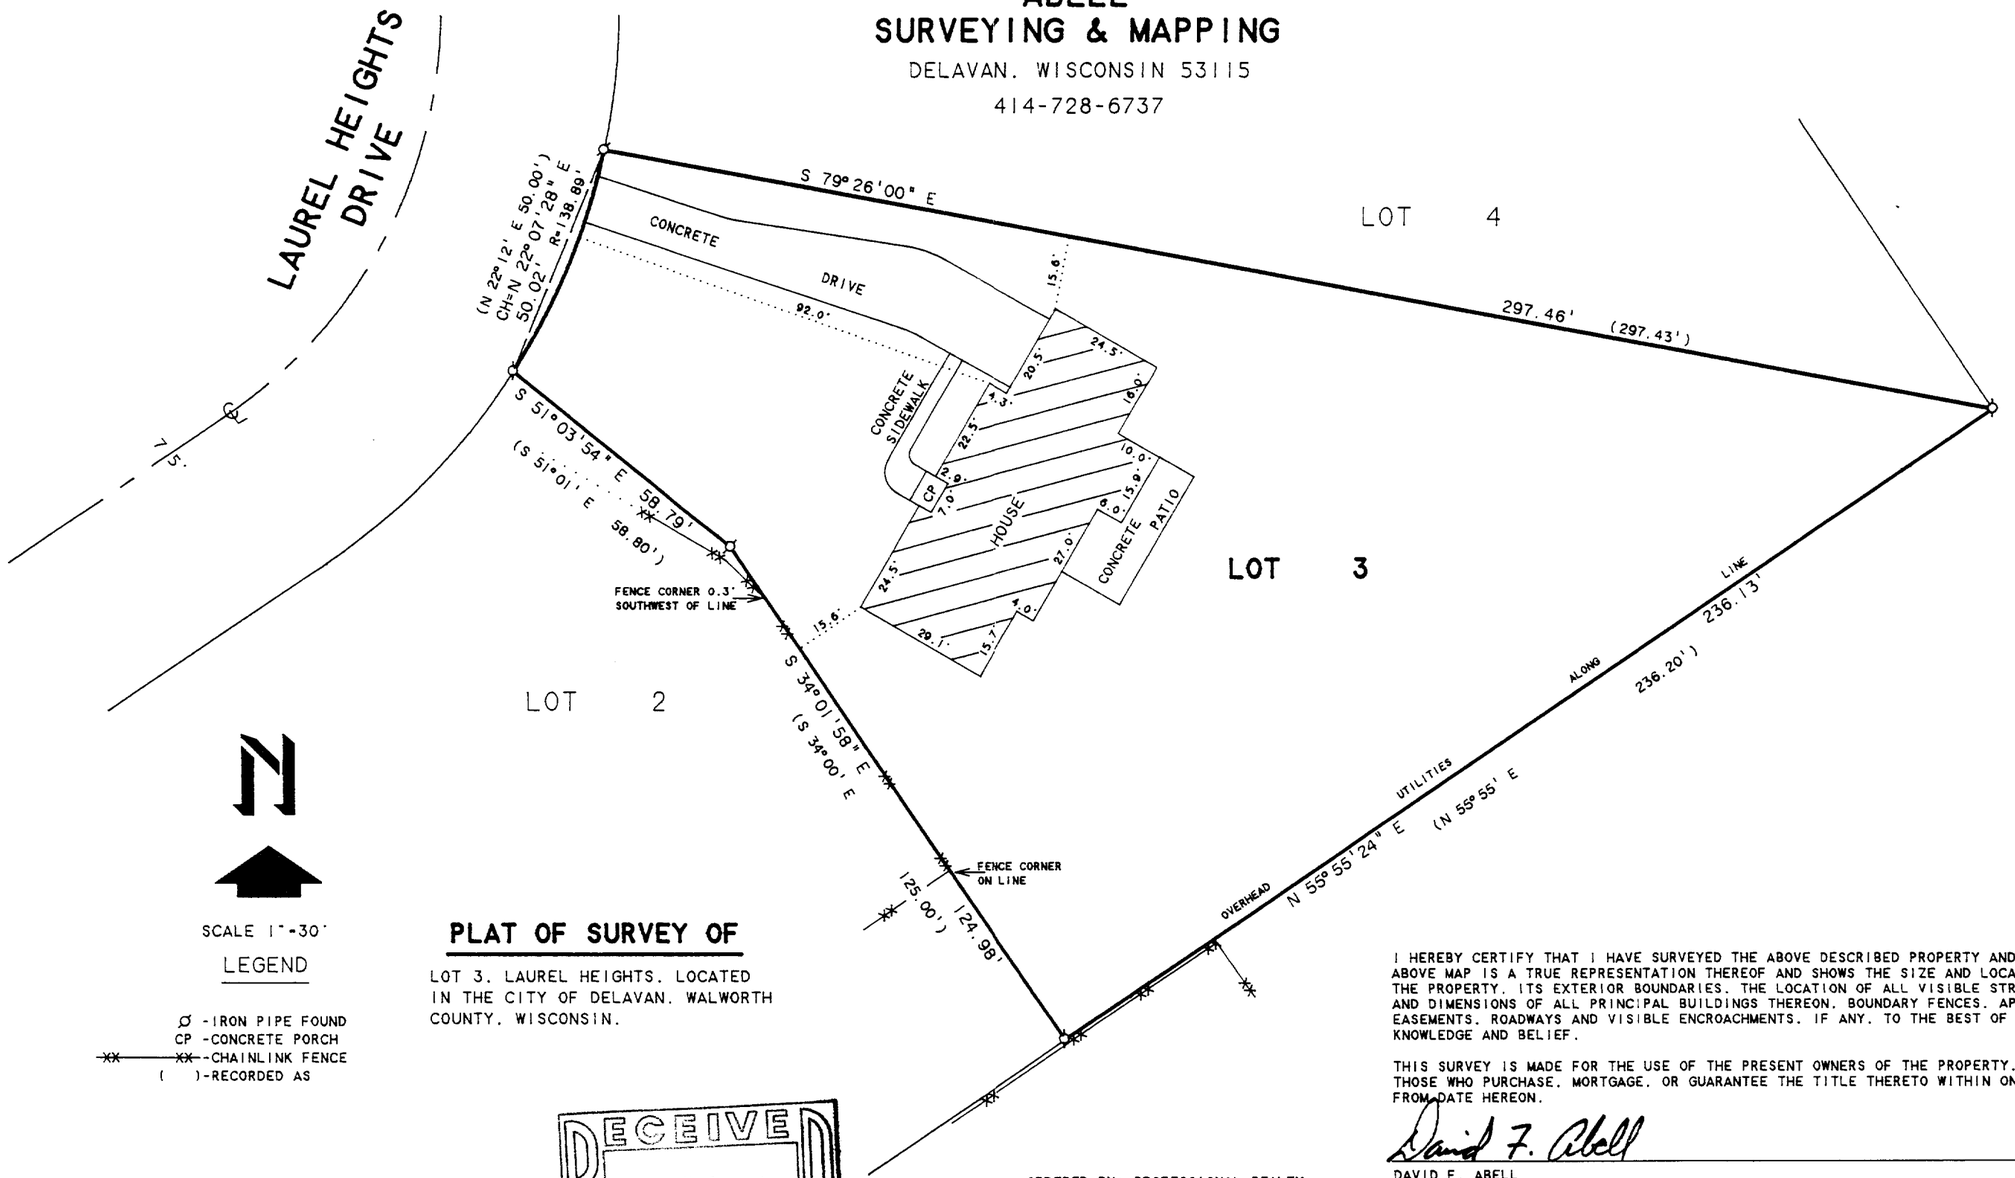

SCALE 1"=30'

LEGEND

Ø -IRON PIPE FOUND
CP -CONCRETE PORCH
-XX-XX- -CHAINLINK FENCE
( )-RECORDED AS

NOTE: BEARINGS ARE REFERENCED TO THE RECORDED SUBDIVISION PLAT.

PLAT OF SURVEY OF

LOT 3. LAUREL HEIGHTS. LOCATED IN THE CITY OF DELAVAN. WALWORTH COUNTY. WISCONSIN.

RECEIVED
AUG 2 3 1992

ORDERED BY: PROFESSIONAL REALTY
706 E. GENEVA ST.
DELAVAN. WI. 53115

I HEREBY CERTIFY THAT I HAVE SURVEYED THE ABOVE DESCRIBED PROPERTY AND THAT THE ABOVE MAP IS A TRUE REPRESENTATION THEREOF AND SHOWS THE SIZE AND LOCATION OF THE PROPERTY. ITS EXTERIOR BOUNDARIES. THE LOCATION OF ALL VISIBLE STRUCTURES AND DIMENSIONS OF ALL PRINCIPAL BUILDINGS THEREON. BOUNDARY FENCES. APPARENT EASEMENTS. ROADWAYS AND VISIBLE ENCROACHMENTS. IF ANY. TO THE BEST OF MY KNOWLEDGE AND BELIEF.

THIS SURVEY IS MADE FOR THE USE OF THE PRESENT OWNERS OF THE PROPERTY. AND ALSO THOSE WHO PURCHASE. MORTGAGE. OR GUARANTEE THE TITLE THERETO WITHIN ONE (1) YEAR FROM DATE HEREON.

David F. Abell

DAVID F. ABELL
WISCONSIN REGISTERED LAND SURVEYOR. S-1596

JUNE 10. 1992
DATE

JOB NUMBER - 92117

NOTE: THIS IS NOT A CERTIFIED COPY UNLESS SEALED.

002-1158

XLH-3