
WALWORTH COUNTY
SURVEYING & MAPPING
727 HENRY STREET
LAKE GENEVA, WISCONSIN
414-248-0505

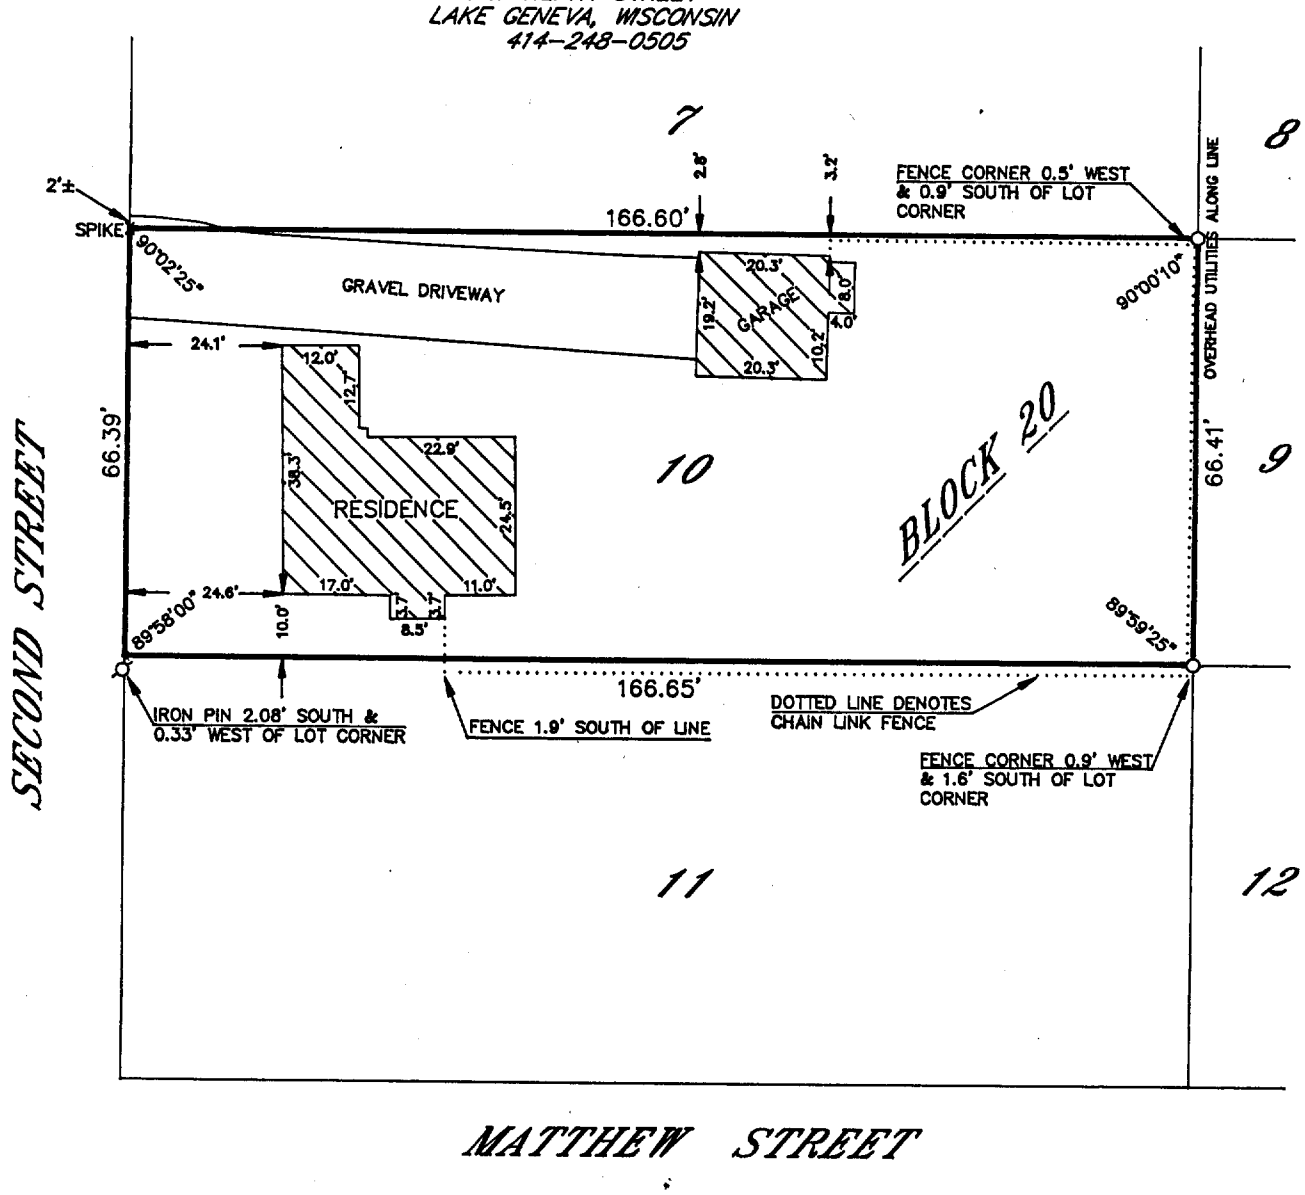

SCALE IN FEET
0 30 60

LEGEND
- ⊙-IRON PIPE FOUND
- Ø-IRON ROD FOUND
- ■-CONCRETE MONUMENT FOUND
- ○-IRON PIPE PLACED
- ()-RECORDED AS

RECEIVED
JAN 16 1992
by

PLAT OF SURVEY OF

LOT 10, BLOCK 20 OF THE ORIGINAL PLAT OF THE CITY OF DELAVAN, WALWORTH COUNTY, WISCONSIN.

ORDERED BY: SCOTT MARTIN
317 SOUTH SECOND STREET
DELAVAN, WISCONSIN

I HEREBY CERTIFY THAT I HAVE SURVEYED THE ABOVE DESCRIBED PROPERTY AND THAT THE ABOVE MAP IS A TRUE REPRESENTATION THEREOF AND SHOWS THE SIZE AND LOCATION OF THE PROPERTY, ITS EXTERIOR BOUNDARIES, THE LOCATION OF ALL VISIBLE STRUCTURES AND DIMENSIONS OF ALL PRINCIPAL BUILDINGS THEREON, BOUNDARY FENCES, APPARENT EASEMENTS, ROADWAYS AND VISIBLE ENCROACHMENTS, IF ANY, TO THE BEST OF MY KNOWLEDGE AND BELIEF.

THIS SURVEY IS MADE FOR THE USE OF THE PRESENT OWNERS OF THE PROPERTY AND ALSO THOSE WHO PURCHASE, MORTGAGE OR GUARANTEE THE TITLE THERETO WITHIN ONE (1) YEAR FROM DATE HEREOF.

Robert M. Baerenwald
ROBERT M. BAERENWALD
WISCONSIN REGISTERED LAND SURVEYOR, S-1508

DATE Jan. 8, 1992 JOB NO. 2785

NOTE: THIS IS NOT A CERTIFIED COPY UNLESS SEALED.

002-1181

XOP-213