DUNHAM SURVEYING, S.C.
SURVEYING & SUBDIVIDING
DELAVAN, WISCONSIN 53115

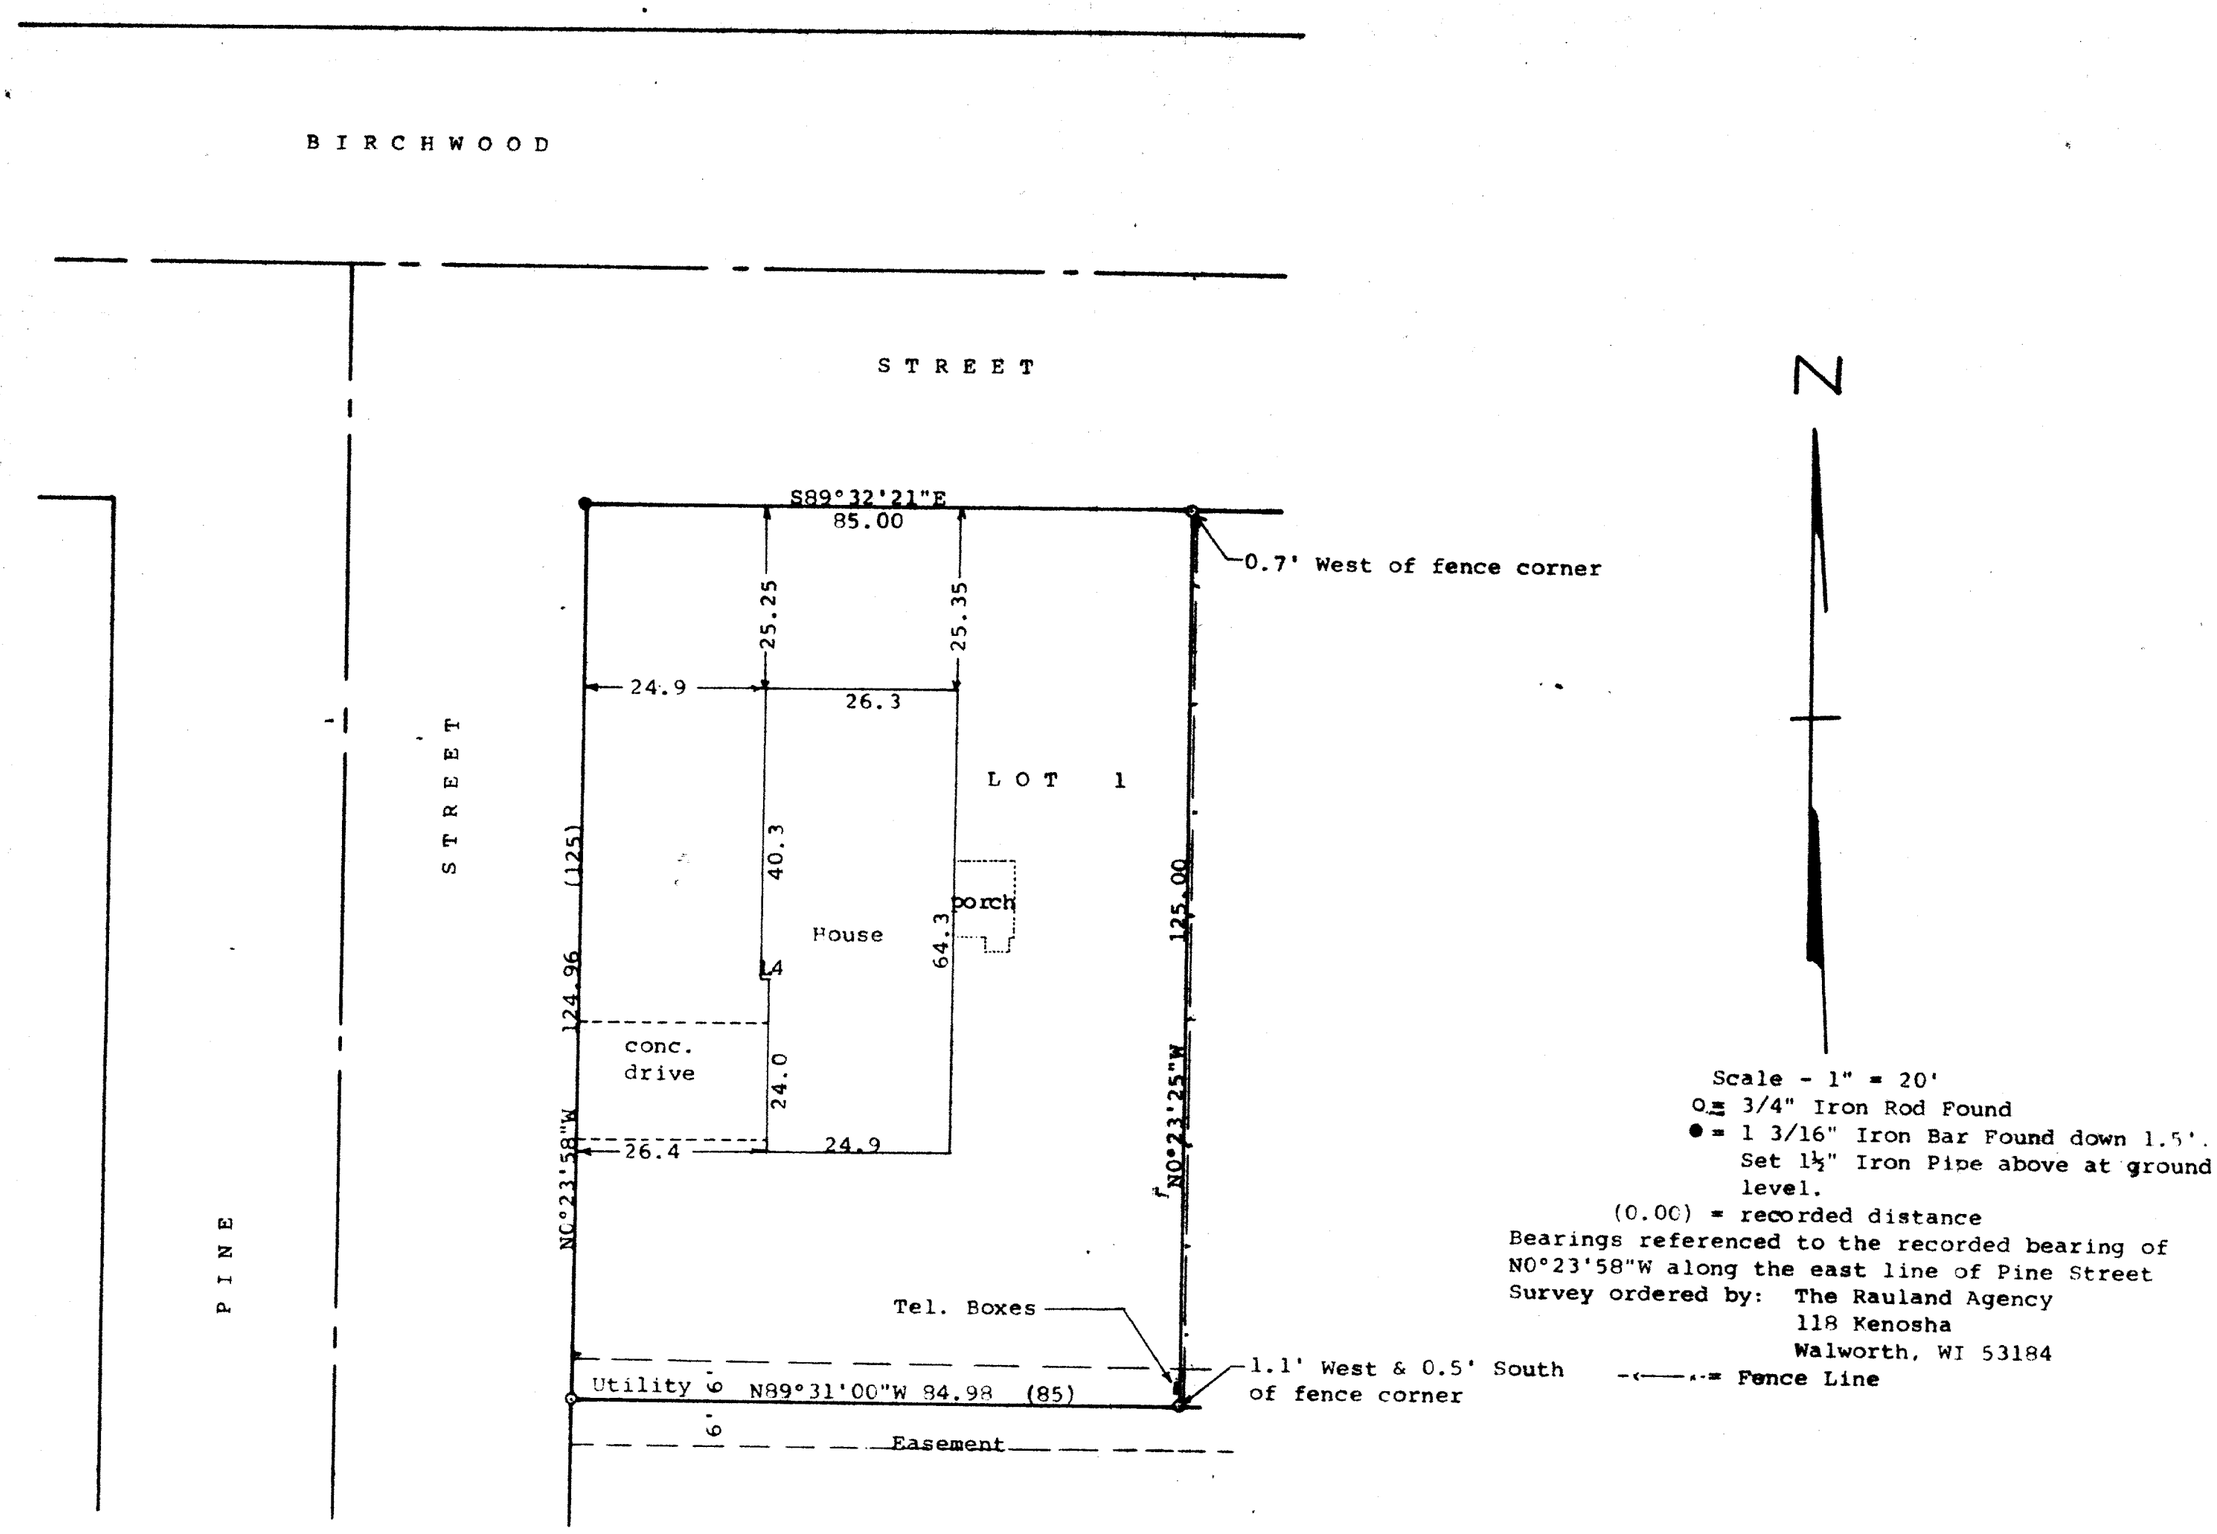

STATE OF WISCONSIN)
COUNTY OF WALWORTH) SS

I, George T. Dunham, Surveyor, certify that I have surveyed the property described as follows:

Lot 1 in Turtle Creek, a subdivision located in the Southeast ¼ of Section 13, T 2 N, R 15 E, City of Delavan, Walworth County, Wisconsin

and that the plat shown hereon is a correct representation thereof and shows the size and location of the property, its exterior boundaries, the location of all visible structures and dimensions of all principal buildings thereon, boundary fences, apparent easements, roadways and visible encroachments, if any, and that I have surveyed the property hereon described, according to the official records, to the best of my knowledge and belief

January 12, 1993

George T. Dunham, Surveyor

WISCONSIN LAND SURVEYOR
GEORGE T. DUNHAM
S-306
DELAVAN WIS.

RECEIVED
FEB 1 4 1993

GMB 1020

002-1189

XTC-1