
DUNHAM SURVEYING, S.C.
SURVEYING & SUBDIVIDING
DELAVAN, WISCONSIN 53115

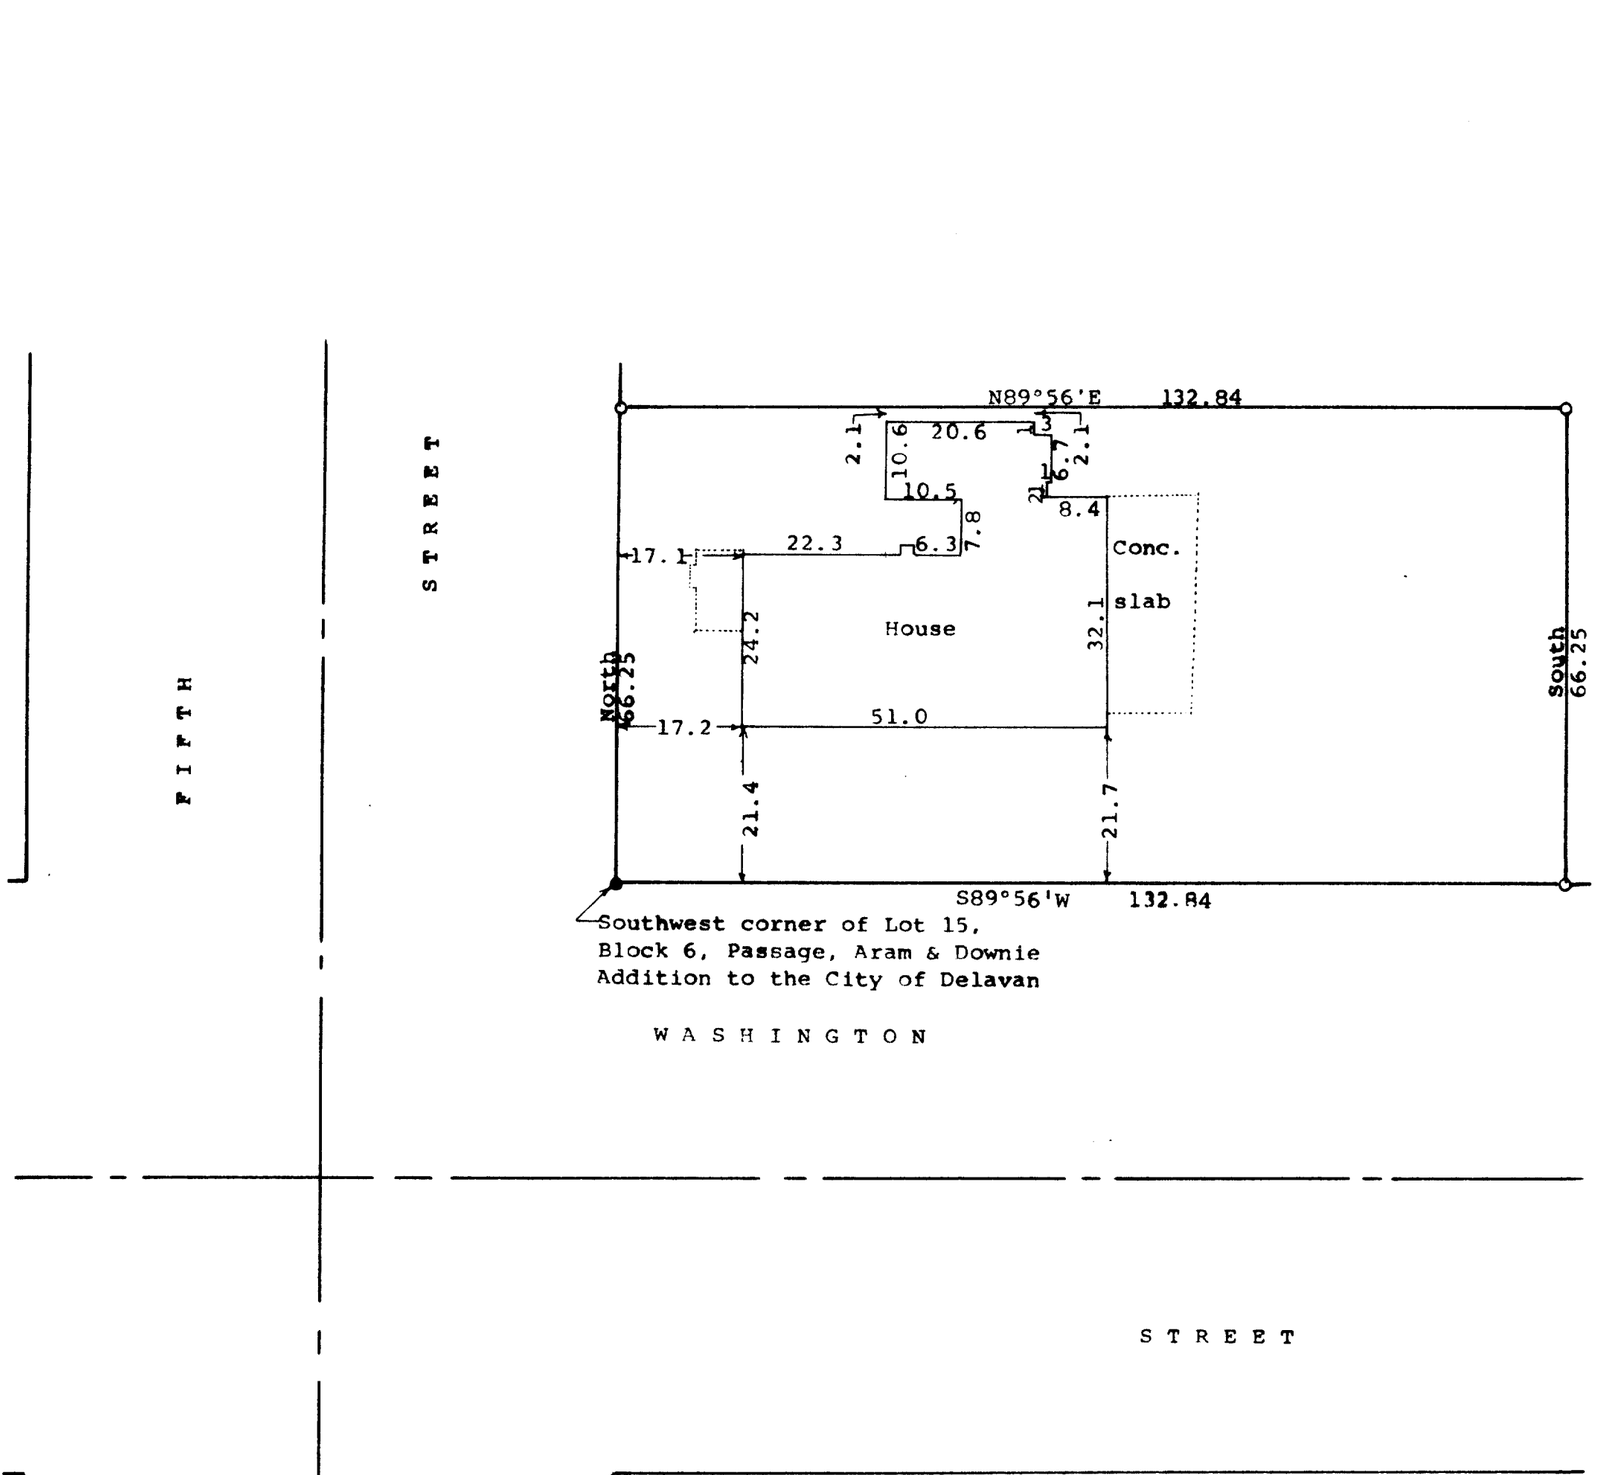

Scale - 1" = 20'
● = Concrete Monument Found
o = 1" Iron Pipe Found
Bearings referenced to the east line of Fifth Street with the assumed bearing of North.
Survey ordered by:
The Rauland Agency
118 Kenosha
Walworth, WI 53184

STATE OF WISCONSIN)
COUNTY OF WALWORTH) SS

I, George T. Dunham, Surveyor, certify that I have surveyed the property described as follows:

A part of Lot 15 in Block 6, Passage, Aram, & Downie Addition to the Village, (Now City) of Delavan, Walworth County, Wisconsin, described as follows: Beginning at the southwest corner of said Lot 15; thence North along the west line of said Lot 15, 66.25 feet; thence N89°56'E along the north line of said Lot 15, 132.84 feet; thence South 66.25 feet; thence S89°56'W along the south line of said Lot 15, 132.84 feet to the place of beginning.

and that the plat shown hereon is a correct representation thereof and shows the size and location of the property, its exterior boundaries, the location of all visible structures and dimensions of all principal buildings thereon, boundary fences, apparent easements, roadways and visible encroachments, if any, and that I have surveyed the property hereon described, according to the official records, to the best of my knowledge and belief.

September 22, 1992

George T. Dunham, Surveyor

RECEIVED
FEB 11 1993

WISCONSIN
GEORGE T. DUNHAM
S-306
DELAVAN WIS.
LAND SURVEYOR

GMS 1020

02-1213

XP-103A