
ABELL
SURVEYING & MAPPING

DELAVAN. WISCONSIN 53115
414-728-6737

RECEIVED
FEB 1 2 1993

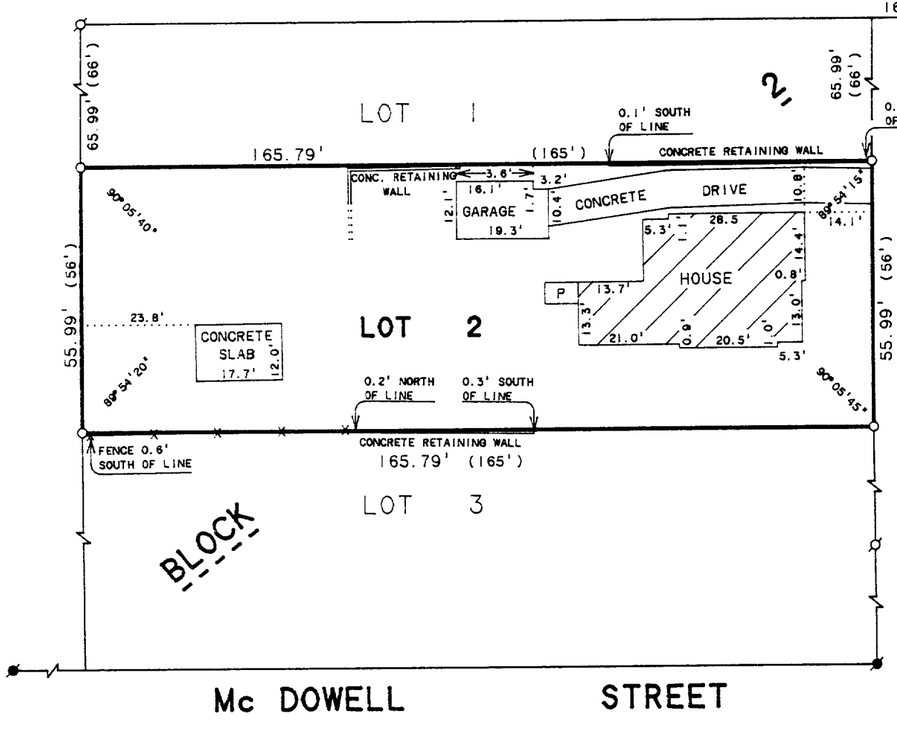

SCALE 1"=30'

LEGEND

- ⌀ - IRON PIPE FOUND
- ● - CONCRETE MONUMENT FOUND
- × - CUTCROSS IN CONCRETE FOUND
- -×-×- - WIRE FENCE
- O - IRON PIPE SET
- P - PORCH
- ( ) - RECORDED AS

PLAT OF SURVEY OF

LOT 2, BLOCK 2, KATIE A. LATHROP ADDITION TO THE CITY OF DELAVAN, WALWORTH COUNTY, WISCONSIN.

I HEREBY CERTIFY THAT I HAVE SURVEYED THE ABOVE DESCRIBED PROPERTY AND THAT THE ABOVE MAP IS A TRUE REPRESENTATION THEREOF AND SHOWS THE SIZE AND LOCATION OF THE PROPERTY, ITS EXTERIOR BOUNDARIES, THE LOCATION OF ALL VISIBLE STRUCTURES AND DIMENSIONS OF ALL PRINCIPAL BUILDINGS THEREON, BOUNDARY FENCES, APPARENT EASEMENTS, ROADWAYS AND VISIBLE ENCROACHMENTS, IF ANY, TO THE BEST OF MY KNOWLEDGE AND BELIEF.

THIS SURVEY IS MADE FOR THE USE OF THE PRESENT OWNERS OF THE PROPERTY, AND ALSO THOSE WHO PURCHASE, MORTGAGE, OR GUARANTEE THE TITLE THERETO WITHIN ONE (1) YEAR FROM DATE HEREON.

David F. Abell

DAVID F. ABELL
WISCONSIN REGISTERED LAND SURVEYOR, S-1596

August 14, 1992

DATE JOB NUMBER - 92177

NOTE: THIS IS NOT A CERTIFIED COPY UNLESS SEALED.

ORDERED BY: RE/MAX-LAKES AREA REALTORS
1815 N. SHORE DRIVE
DELAVAN, WI. 53115

002-1223

XLA-7