
ABELL
SURVEYING & MAPPING
DELAVAN, WISCONSIN 53115
414-728-6737

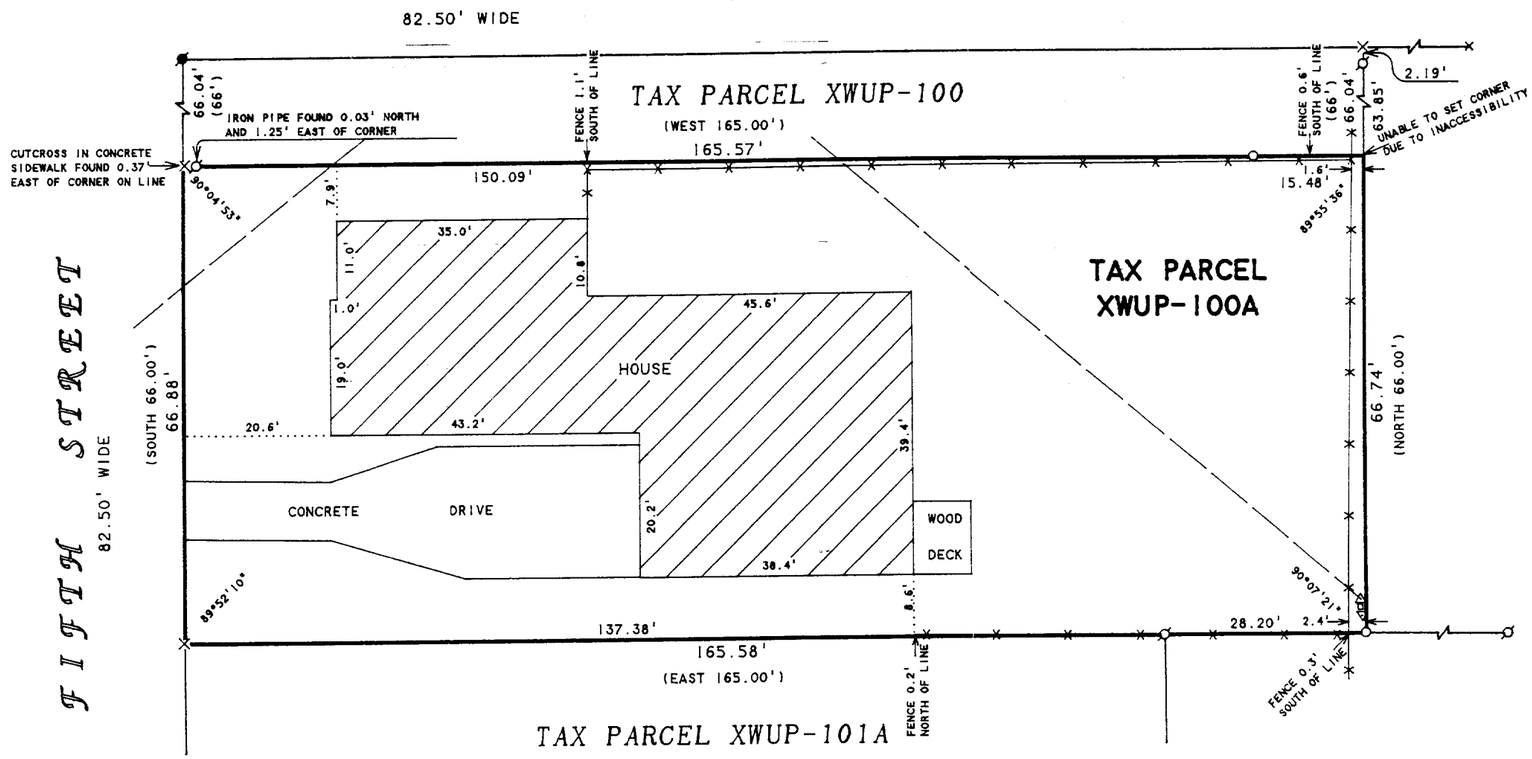

N

SCALE 1"=20'

LEGEND

- -IRON PIPE FOUND
- -CONCRETE MONUMENT IN CONCRETE SIDEWALK FOUND
- -CUTCROSS IN CONCRETE SIDEWALK FOUND
- -IRON ROD SET
- -WIRE FENCE
- -UTILITY POLE
- -UTILITY PED.
- -OVERHEAD UTILITY LINES
- ( )-RECORDED AS

ORDERED BY: CENTURY 21-SKANDIA REALTY
312 S. 7th STREET
DELAVAN, WI. 53115

RECEIVED
OCT 29 1993

PLAT OF SURVEY OF

Beginning at a concrete monument located at the southeast corner of Mc Dowell Street and Fifth Street, run thence south on the east line of Fifth Street 66.00 feet to a point, said point marks the place of beginning of parcel of land here inafter described, thence continue south on the east line of Fifth Street 66.00 feet to a point, thence east parallel with Mc Dowell Street 165.00 feet to a point, thence north parallel with the east line of Fifth Street 66.00 feet to a point, thence west parallel with Mc Dowell Street 165.00 feet to a point in the east line of Fifth Street and the place of beginning, said parcel is located in the northeast quarter of Section 18, Town 2 North, Range 16 East, City of Delavan.

Tax Key Number: XWUP 00100A

I HEREBY CERTIFY THAT I HAVE SURVEYED THE ABOVE DESCRIBED PROPERTY AND THAT THE ABOVE MAP IS A TRUE REPRESENTATION THEREOF AND SHOWS THE SIZE AND LOCATION OF THE PROPERTY, ITS EXTERIOR BOUNDARIES, THE LOCATION OF ALL VISIBLE STRUCTURES AND DIMENSIONS OF ALL PRINCIPAL BUILDINGS THEREON, BOUNDARY FENCES, APPARENT EASEMENTS, ROADWAYS AND VISIBLE ENCROACHMENTS, IF ANY, TO THE BEST OF MY KNOWLEDGE AND BELIEF.

THIS SURVEY IS MADE FOR THE USE OF THE PRESENT OWNERS OF THE PROPERTY, AND ALSO THOSE WHO PURCHASE, MORTGAGE, OR GUARANTEE THE TITLE THERETO WITHIN ONE (1) YEAR FROM DATE HEREON.

David F. Abell

DAVID F. ABELL
WISCONSIN REGISTERED LAND SURVEYOR, S-1596

August 26, 1993

DATE JOB NUMBER - 93193
NOTE: THIS IS NOT A CERTIFIED COPY UNLESS SEALED.

XWUP-100A

002-1288