
ABELL
SURVEYING & MAPPING
DELAVAN, WISCONSIN 53115
414-728-6737

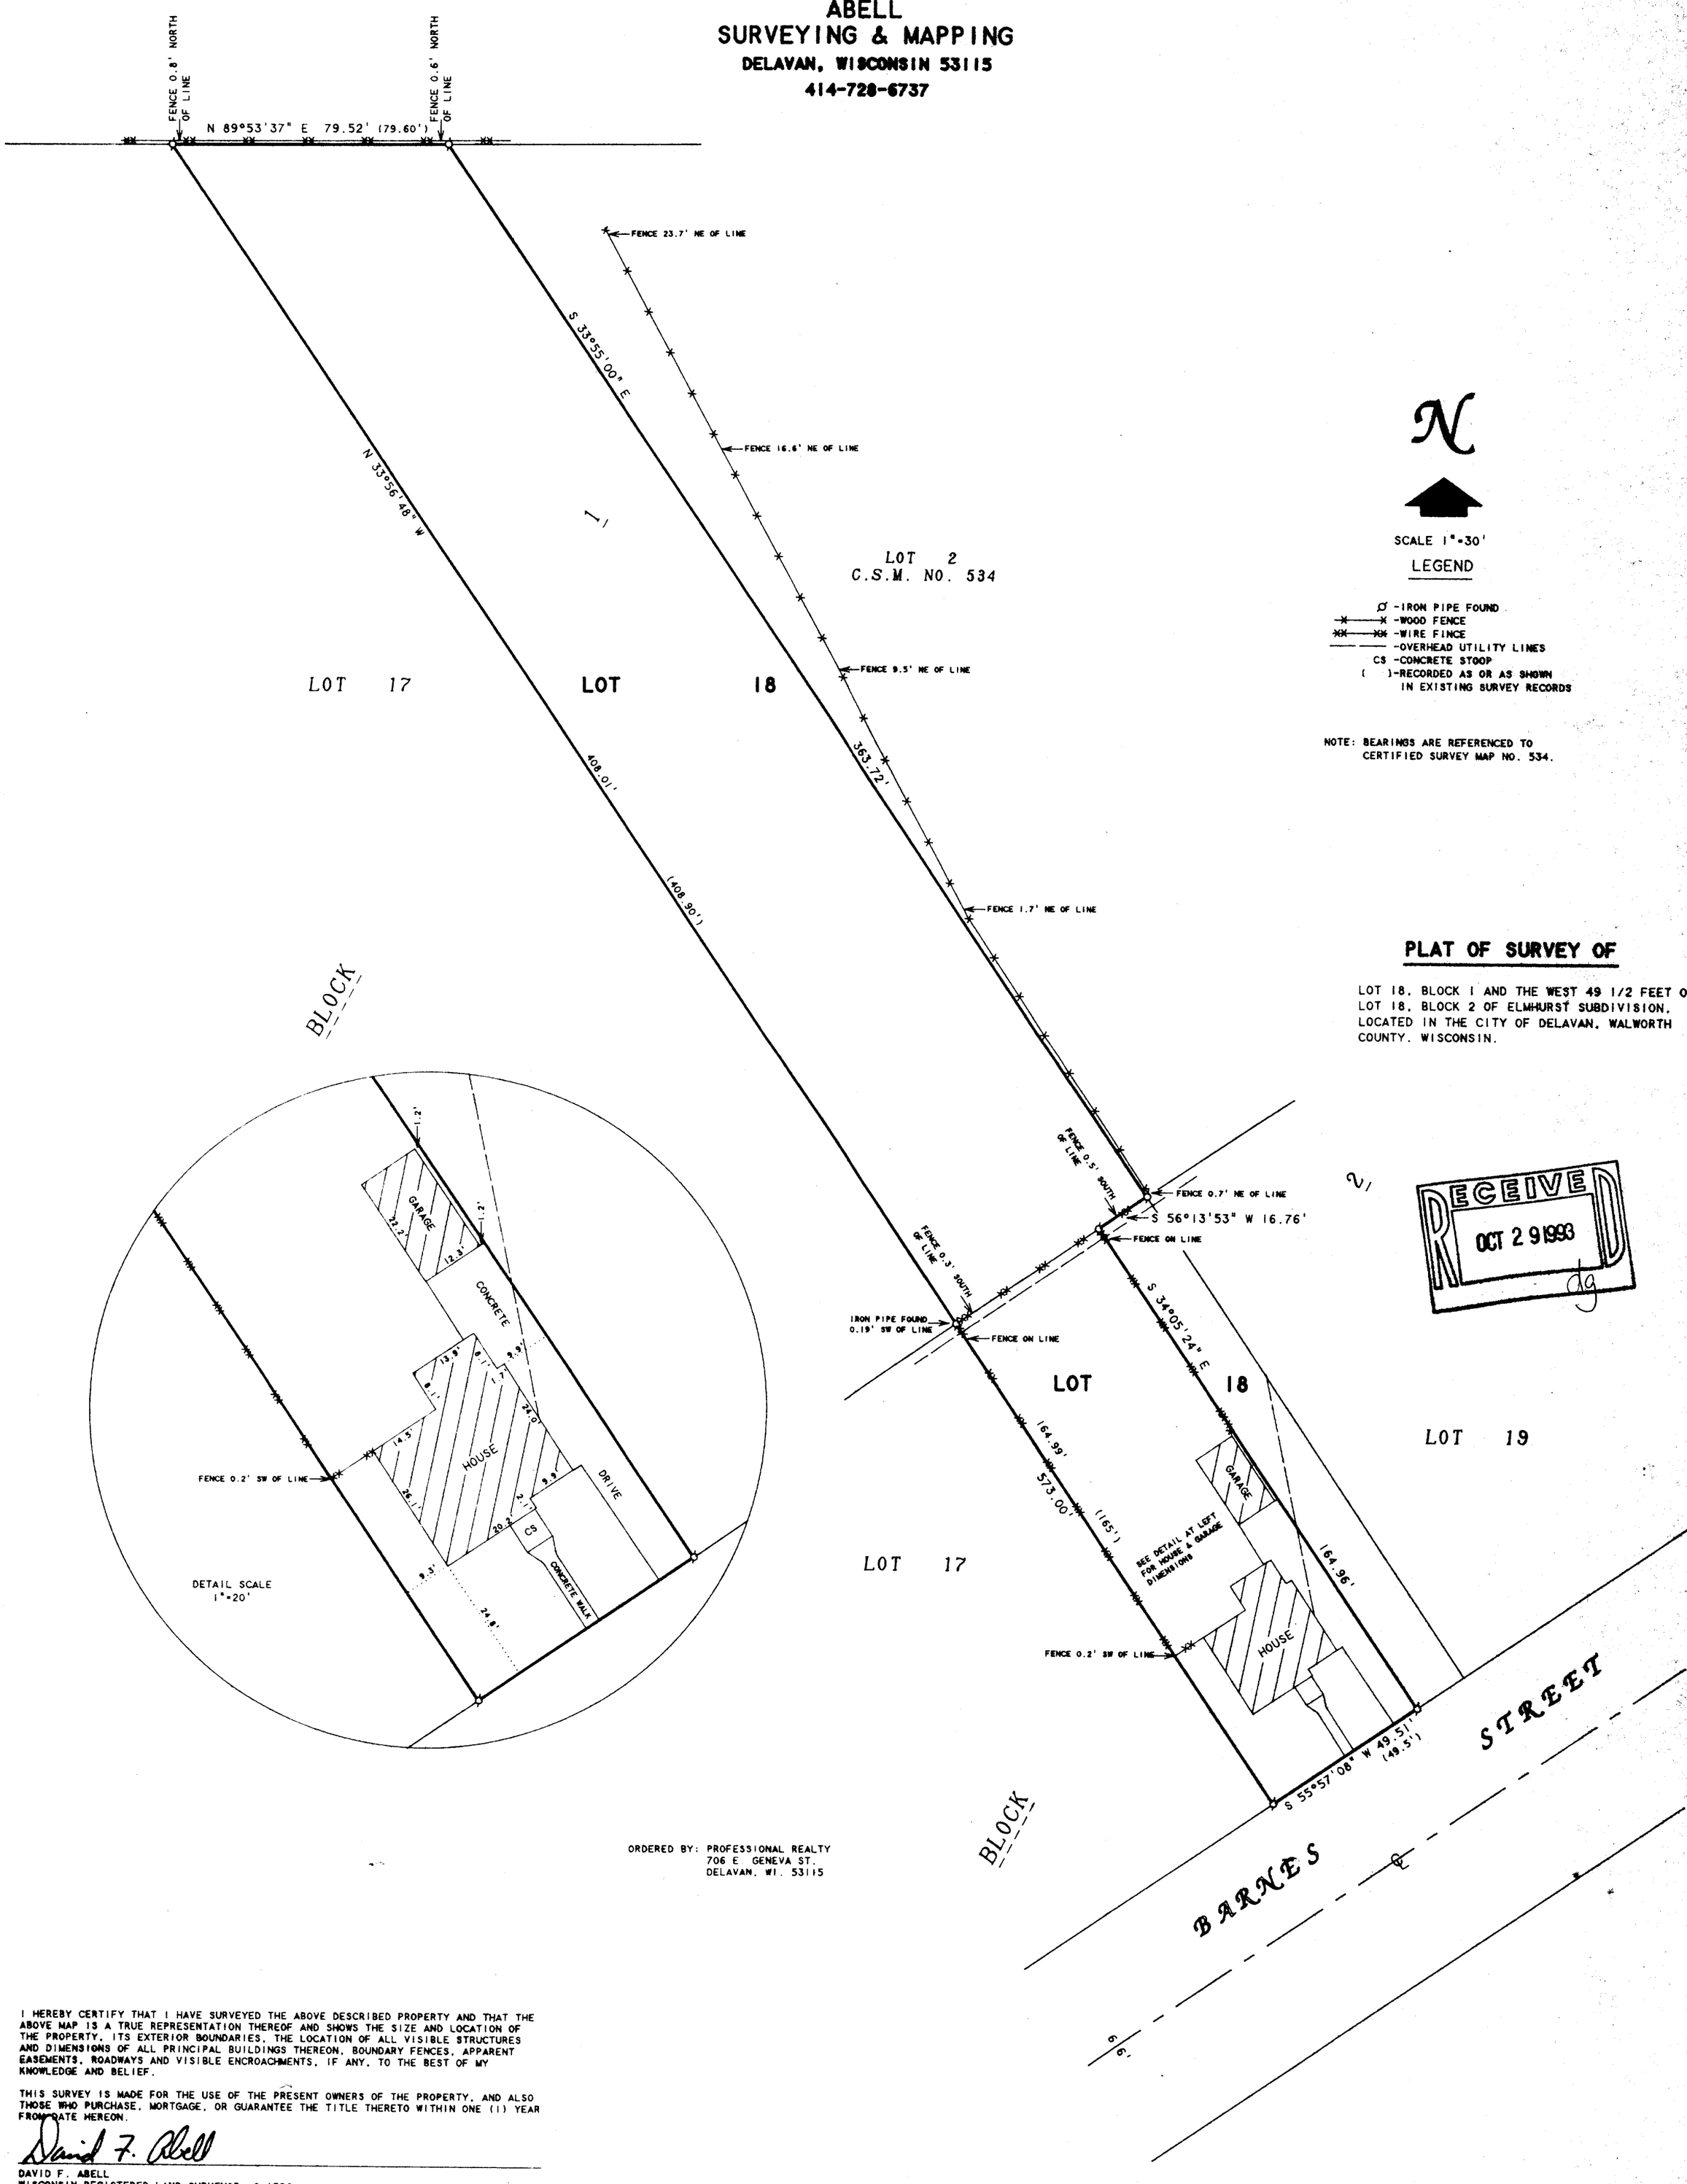

N

SCALE 1"=30'

LEGEND

- ⌀ -IRON PIPE FOUND
- -x-x- -WOOD FENCE
- -xx-xx- -WIRE FINCE
- ——— -OVERHEAD UTILITY LINES
- CS -CONCRETE STOOP
- ( )-RECORDED AS OR AS SHOWN IN EXISTING SURVEY RECORDS

NOTE: BEARINGS ARE REFERENCED TO CERTIFIED SURVEY MAP NO. 534.

PLAT OF SURVEY OF

LOT 18, BLOCK 1 AND THE WEST 49 1/2 FEET OF LOT 18, BLOCK 2 OF ELMHURST SUBDIVISION, LOCATED IN THE CITY OF DELAVAN, WALWORTH COUNTY, WISCONSIN.

RECEIVED
OCT 29 1993
dg

ORDERED BY: PROFESSIONAL REALTY
706 E. GENEVA ST.
DELAVAN, WI. 53115

I HEREBY CERTIFY THAT I HAVE SURVEYED THE ABOVE DESCRIBED PROPERTY AND THAT THE ABOVE MAP IS A TRUE REPRESENTATION THEREOF AND SHOWS THE SIZE AND LOCATION OF THE PROPERTY, ITS EXTERIOR BOUNDARIES, THE LOCATION OF ALL VISIBLE STRUCTURES AND DIMENSIONS OF ALL PRINCIPAL BUILDINGS THEREON, BOUNDARY FENCES, APPARENT EASEMENTS, ROADWAYS AND VISIBLE ENCROACHMENTS, IF ANY, TO THE BEST OF MY KNOWLEDGE AND BELIEF.

THIS SURVEY IS MADE FOR THE USE OF THE PRESENT OWNERS OF THE PROPERTY, AND ALSO THOSE WHO PURCHASE, MORTGAGE, OR GUARANTEE THE TITLE THERETO WITHIN ONE (1) YEAR FROM DATE HEREON.

David F. Abell

DAVID F. ABELL
WISCONSIN REGISTERED LAND SURVEYOR, S-1596

July 23, 1993

DATE JOB NUMBER - 93143

NOTE: THIS IS NOT A CERTIFIED COPY UNLESS SEALED.

XEA-7
XEA-16A

002-1305