
ABELL
SURVEYING & MAPPING
DELAVAN, WISCONSIN 53115
414-728-6737

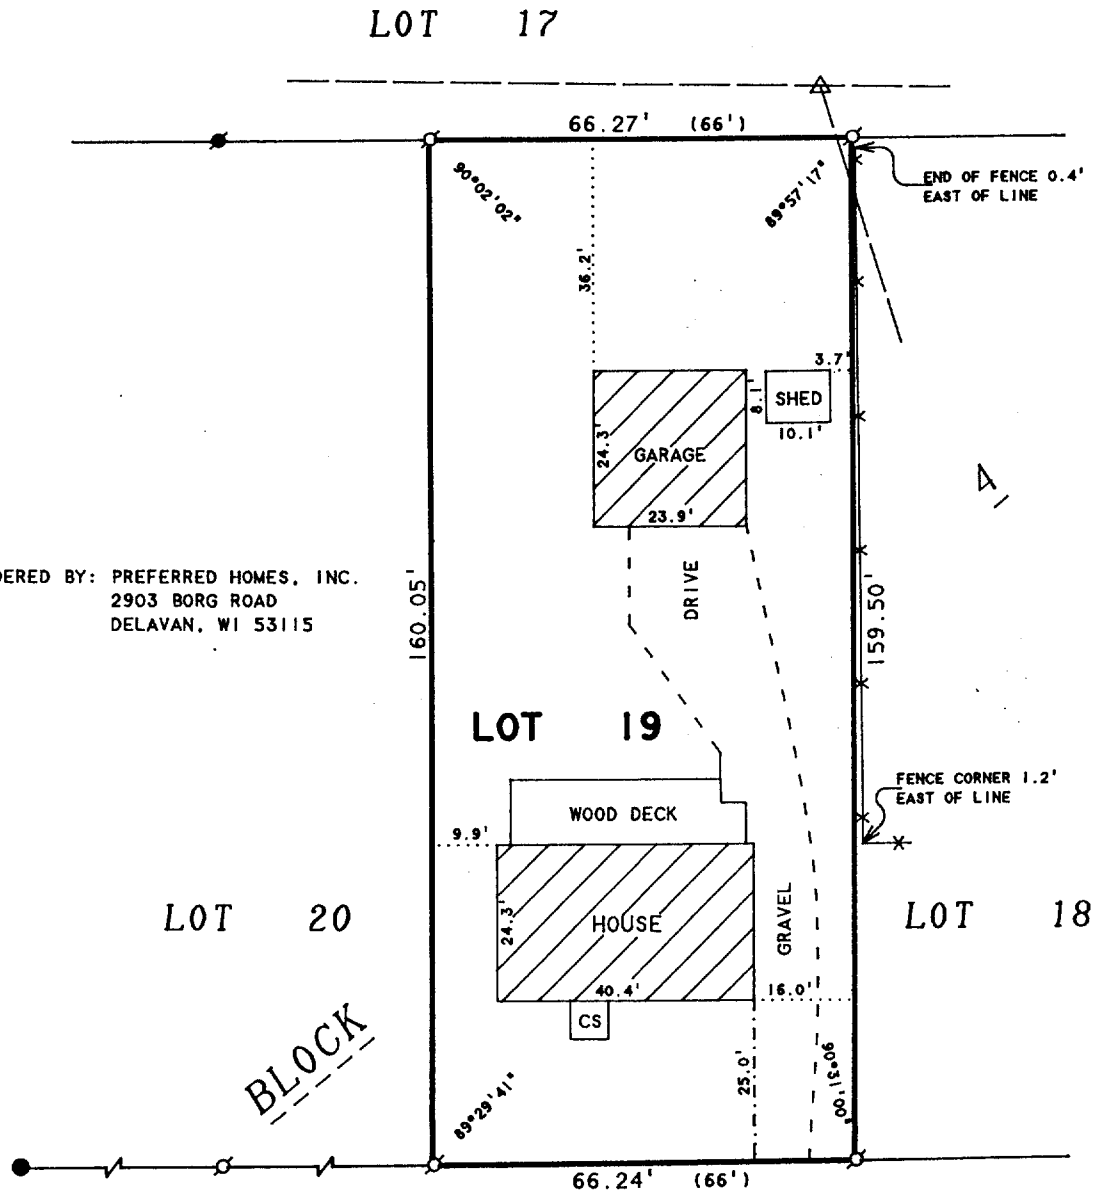

ORDERED BY: PREFERRED HOMES, INC.
2903 BORG ROAD
DELAVAN, WI 53115

RECEIVED
OCT 9 1995

PLAT OF SURVEY OF

LOT 19, BLOCK 4, PASSAGE, ARAM & DOWNIE ADDITION TO THE CITY OF DEALVAN, WALWORTH COUNTY, WISCONSIN.

N

SCALE 1"=30'

LEGEND

- ⌀ -IRON PIPE FOUND
- ⌀ -IRON ROD FOUND
- ● -CONCRETE MONUMENT FOUND
- CS -CONCRETE STOOP
- △ -UTILITY POLE
- ——— -OVERHEAD UTILITY LINES
- -x-x-x- -WOOD FENCE
- ( )-RECORDED AS

I HEREBY CERTIFY THAT I HAVE SURVEYED THE ABOVE DESCRIBED PROPERTY AND THAT THE ABOVE MAP IS A TRUE REPRESENTATION THEREOF AND SHOWS THE SIZE AND LOCATION OF THE PROPERTY, ITS EXTERIOR BOUNDARIES, THE LOCATION OF ALL VISIBLE STRUCTURES AND DIMENSIONS OF ALL PRINCIPAL BUILDINGS THEREON, BOUNDARY FENCES, APPARENT EASEMENTS, ROADWAYS AND VISIBLE ENCROACHMENTS, IF ANY, TO THE BEST OF MY KNOWLEDGE AND BELIEF.

THIS SURVEY IS MADE FOR THE USE OF THE PRESENT OWNERS OF THE PROPERTY, AND ALSO THOSE WHO PURCHASE, MORTGAGE, OR GUARANTEE THE TITLE THERETO WITHIN ONE (1) YEAR FROM DATE HEREON.

David F. Abell

DAVID F. ABELL
WISCONSIN REGISTERED LAND SURVEYOR, S-1596

September 11, 1995

DATE JOB NUMBER - 95159

NOTE: THIS IS NOT A CERTIFIED COPY UNLESS SEALED.

XP-65

082-1456