
ABELL
SURVEYING & MAPPING
DELAVAN, WISCONSIN 53115
414-728-6737

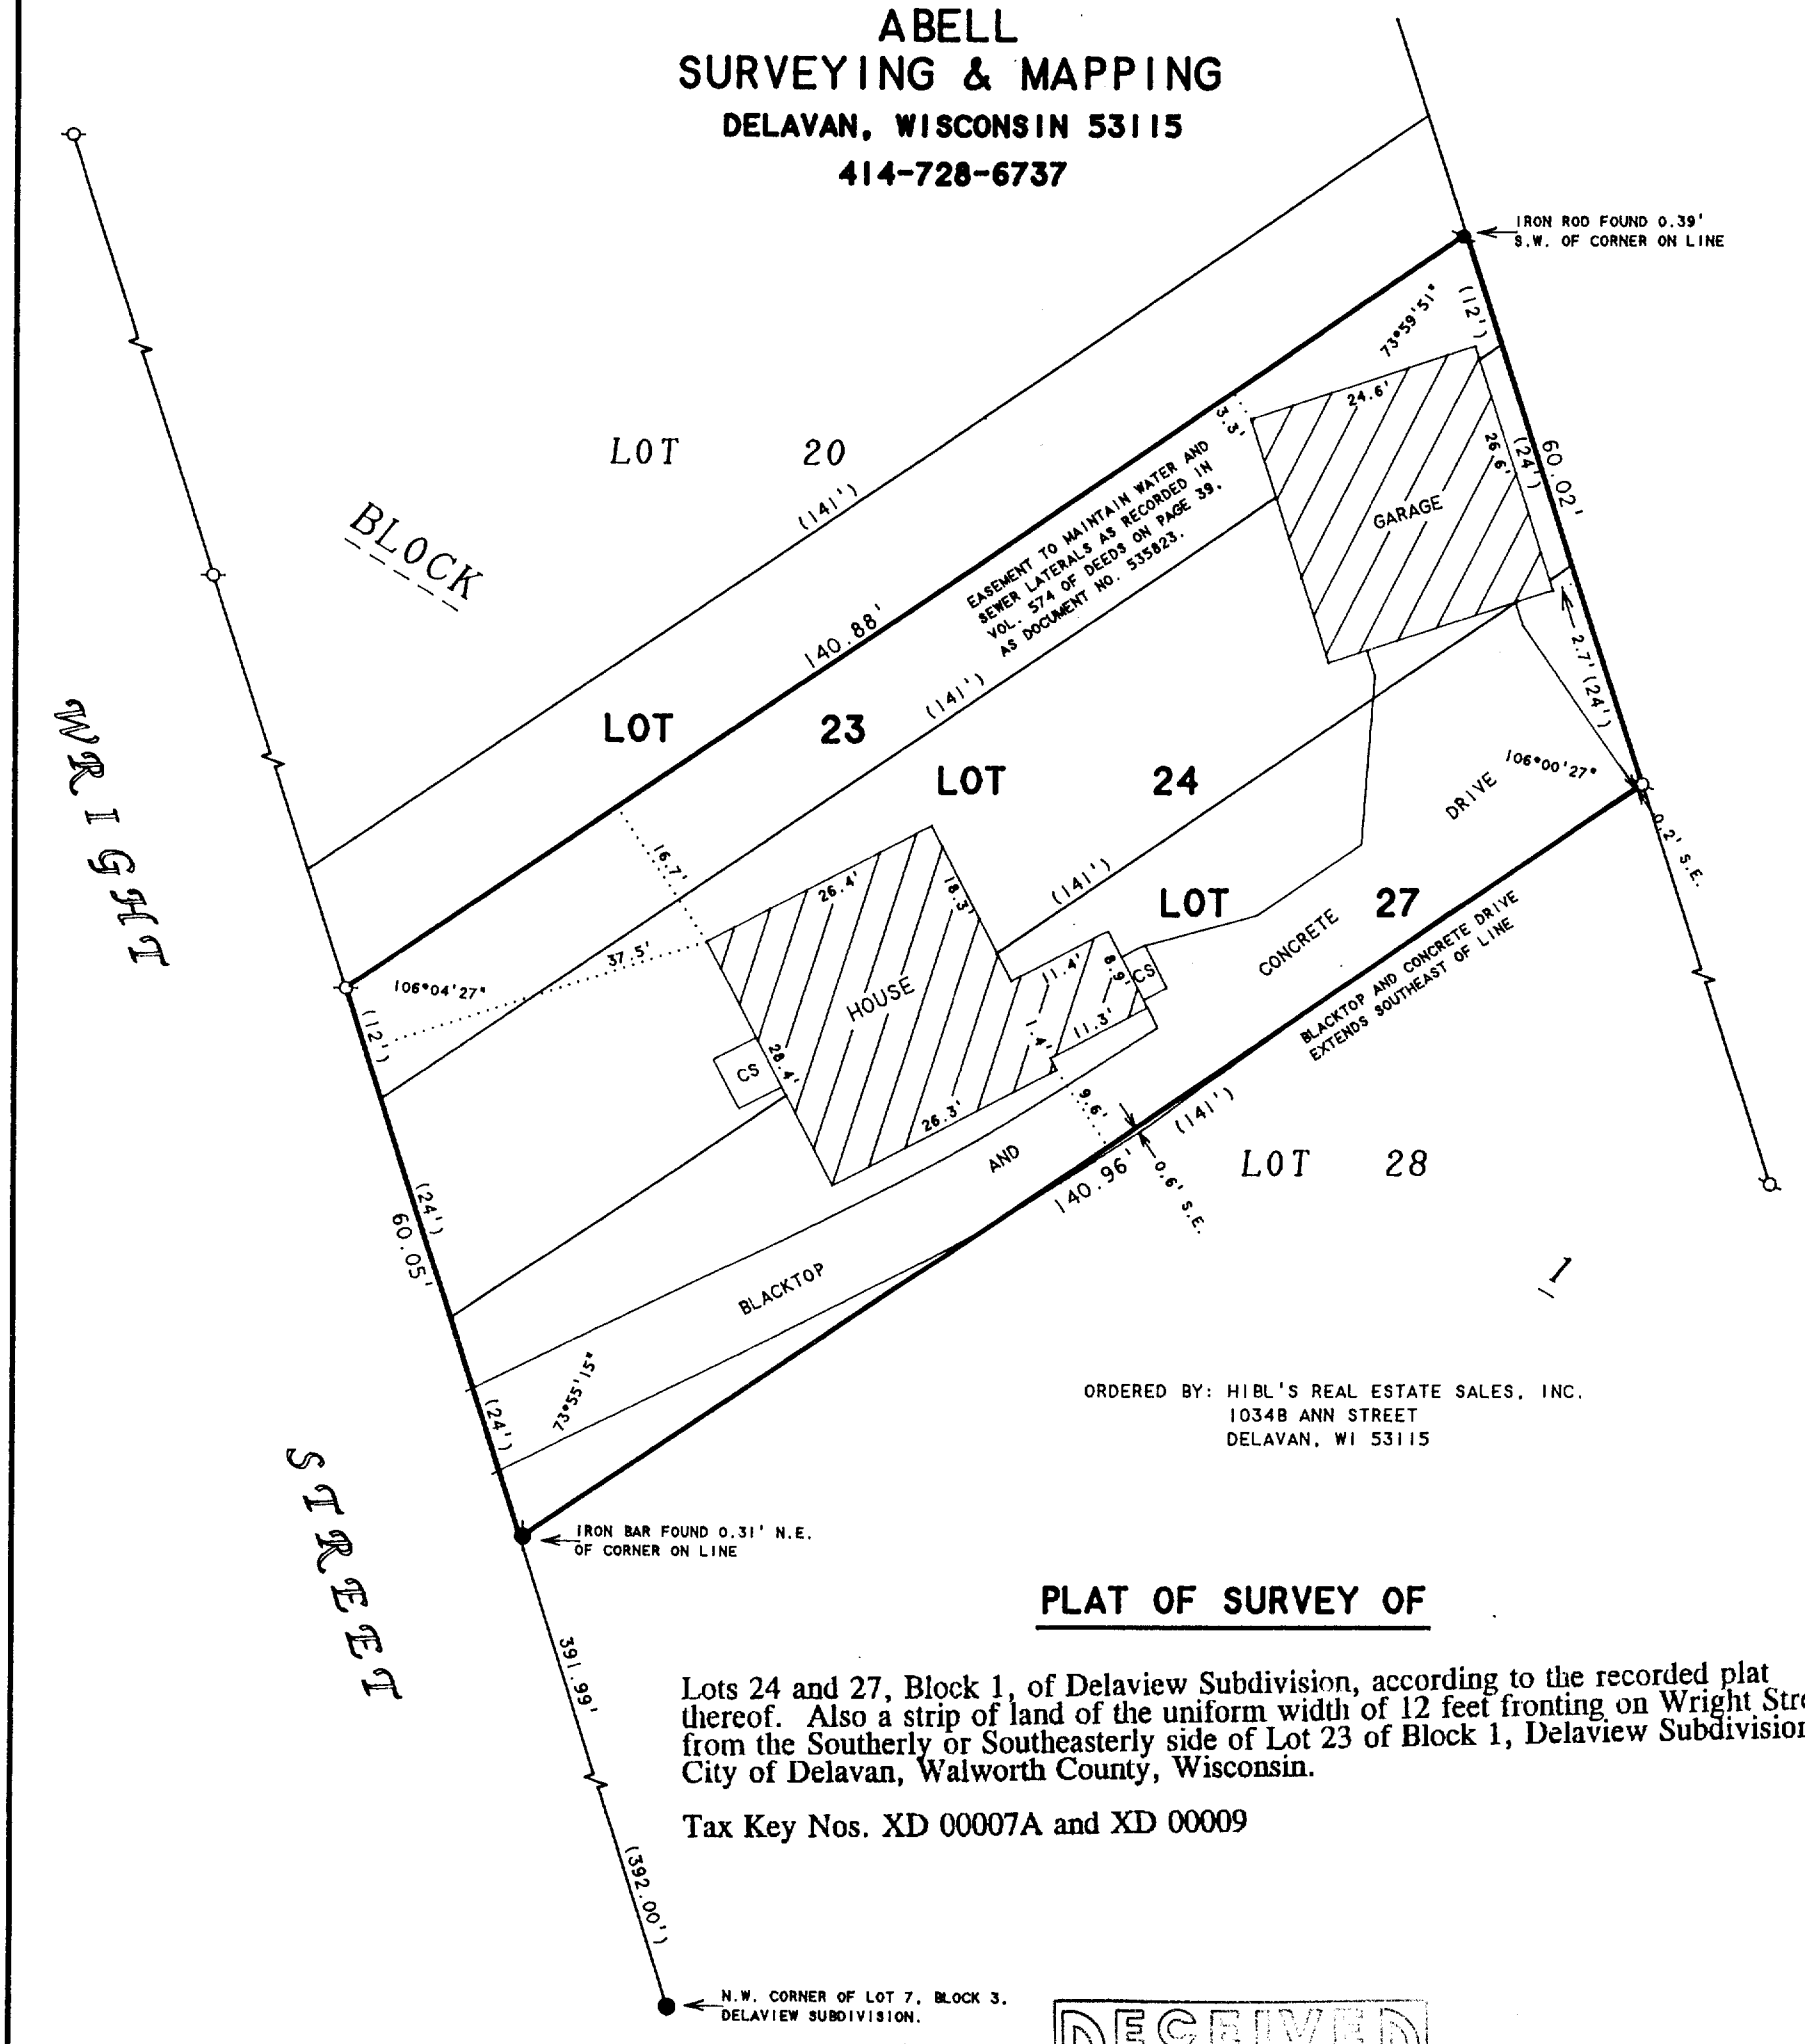

ORDERED BY: HIBL'S REAL ESTATE SALES, INC.
1034B ANN STREET
DELAVAN, WI 53115

PLAT OF SURVEY OF

Lots 24 and 27, Block 1, of Delaview Subdivision, according to the recorded plat thereof. Also a strip of land of the uniform width of 12 feet fronting on Wright Street from the Southerly or Southeasterly side of Lot 23 of Block 1, Delaview Subdivision, City of Delavan, Walworth County, Wisconsin.

Tax Key Nos. XD 00007A and XD 00009

RECEIVED
MAR 13 1996

N

SCALE 1"=20'

LEGEND

- ⌀ -IRON PIPE FOUND
- ● -IRON ROD FOUND
- ● -IRON BAR FOUND
- ● -CONCRETE MONUMENT FOUND
- CS -CONCRETE STOOP
- ( )-RECORDED AS

I HEREBY CERTIFY THAT I HAVE SURVEYED THE ABOVE DESCRIBED PROPERTY AND THAT THE ABOVE MAP IS A TRUE REPRESENTATION THEREOF AND SHOWS THE SIZE AND LOCATION OF THE PROPERTY, ITS EXTERIOR BOUNDARIES, THE LOCATION OF ALL VISIBLE STRUCTURES AND DIMENSIONS OF ALL PRINCIPAL BUILDINGS THEREON, BOUNDARY FENCES, APPARENT EASEMENTS, ROADWAYS AND VISIBLE ENCROACHMENTS, IF ANY, TO THE BEST OF MY KNOWLEDGE AND BELIEF.

THIS SURVEY IS MADE FOR THE USE OF THE PRESENT OWNERS OF THE PROPERTY, AND ALSO THOSE WHO PURCHASE, MORTGAGE, OR GUARANTEE THE TITLE THERETO WITHIN ONE (1) YEAR FROM DATE HEREON.

David F. Abell

DAVID F. ABELL
WISCONSIN REGISTERED LAND SURVEYOR, S-1596

January 15, 1996

DATE JOB NUMBER - 95222

NOTE: THIS IS NOT A CERTIFIED COPY UNLESS SEALED.

XD - 7A
XD - 9

002 -1491