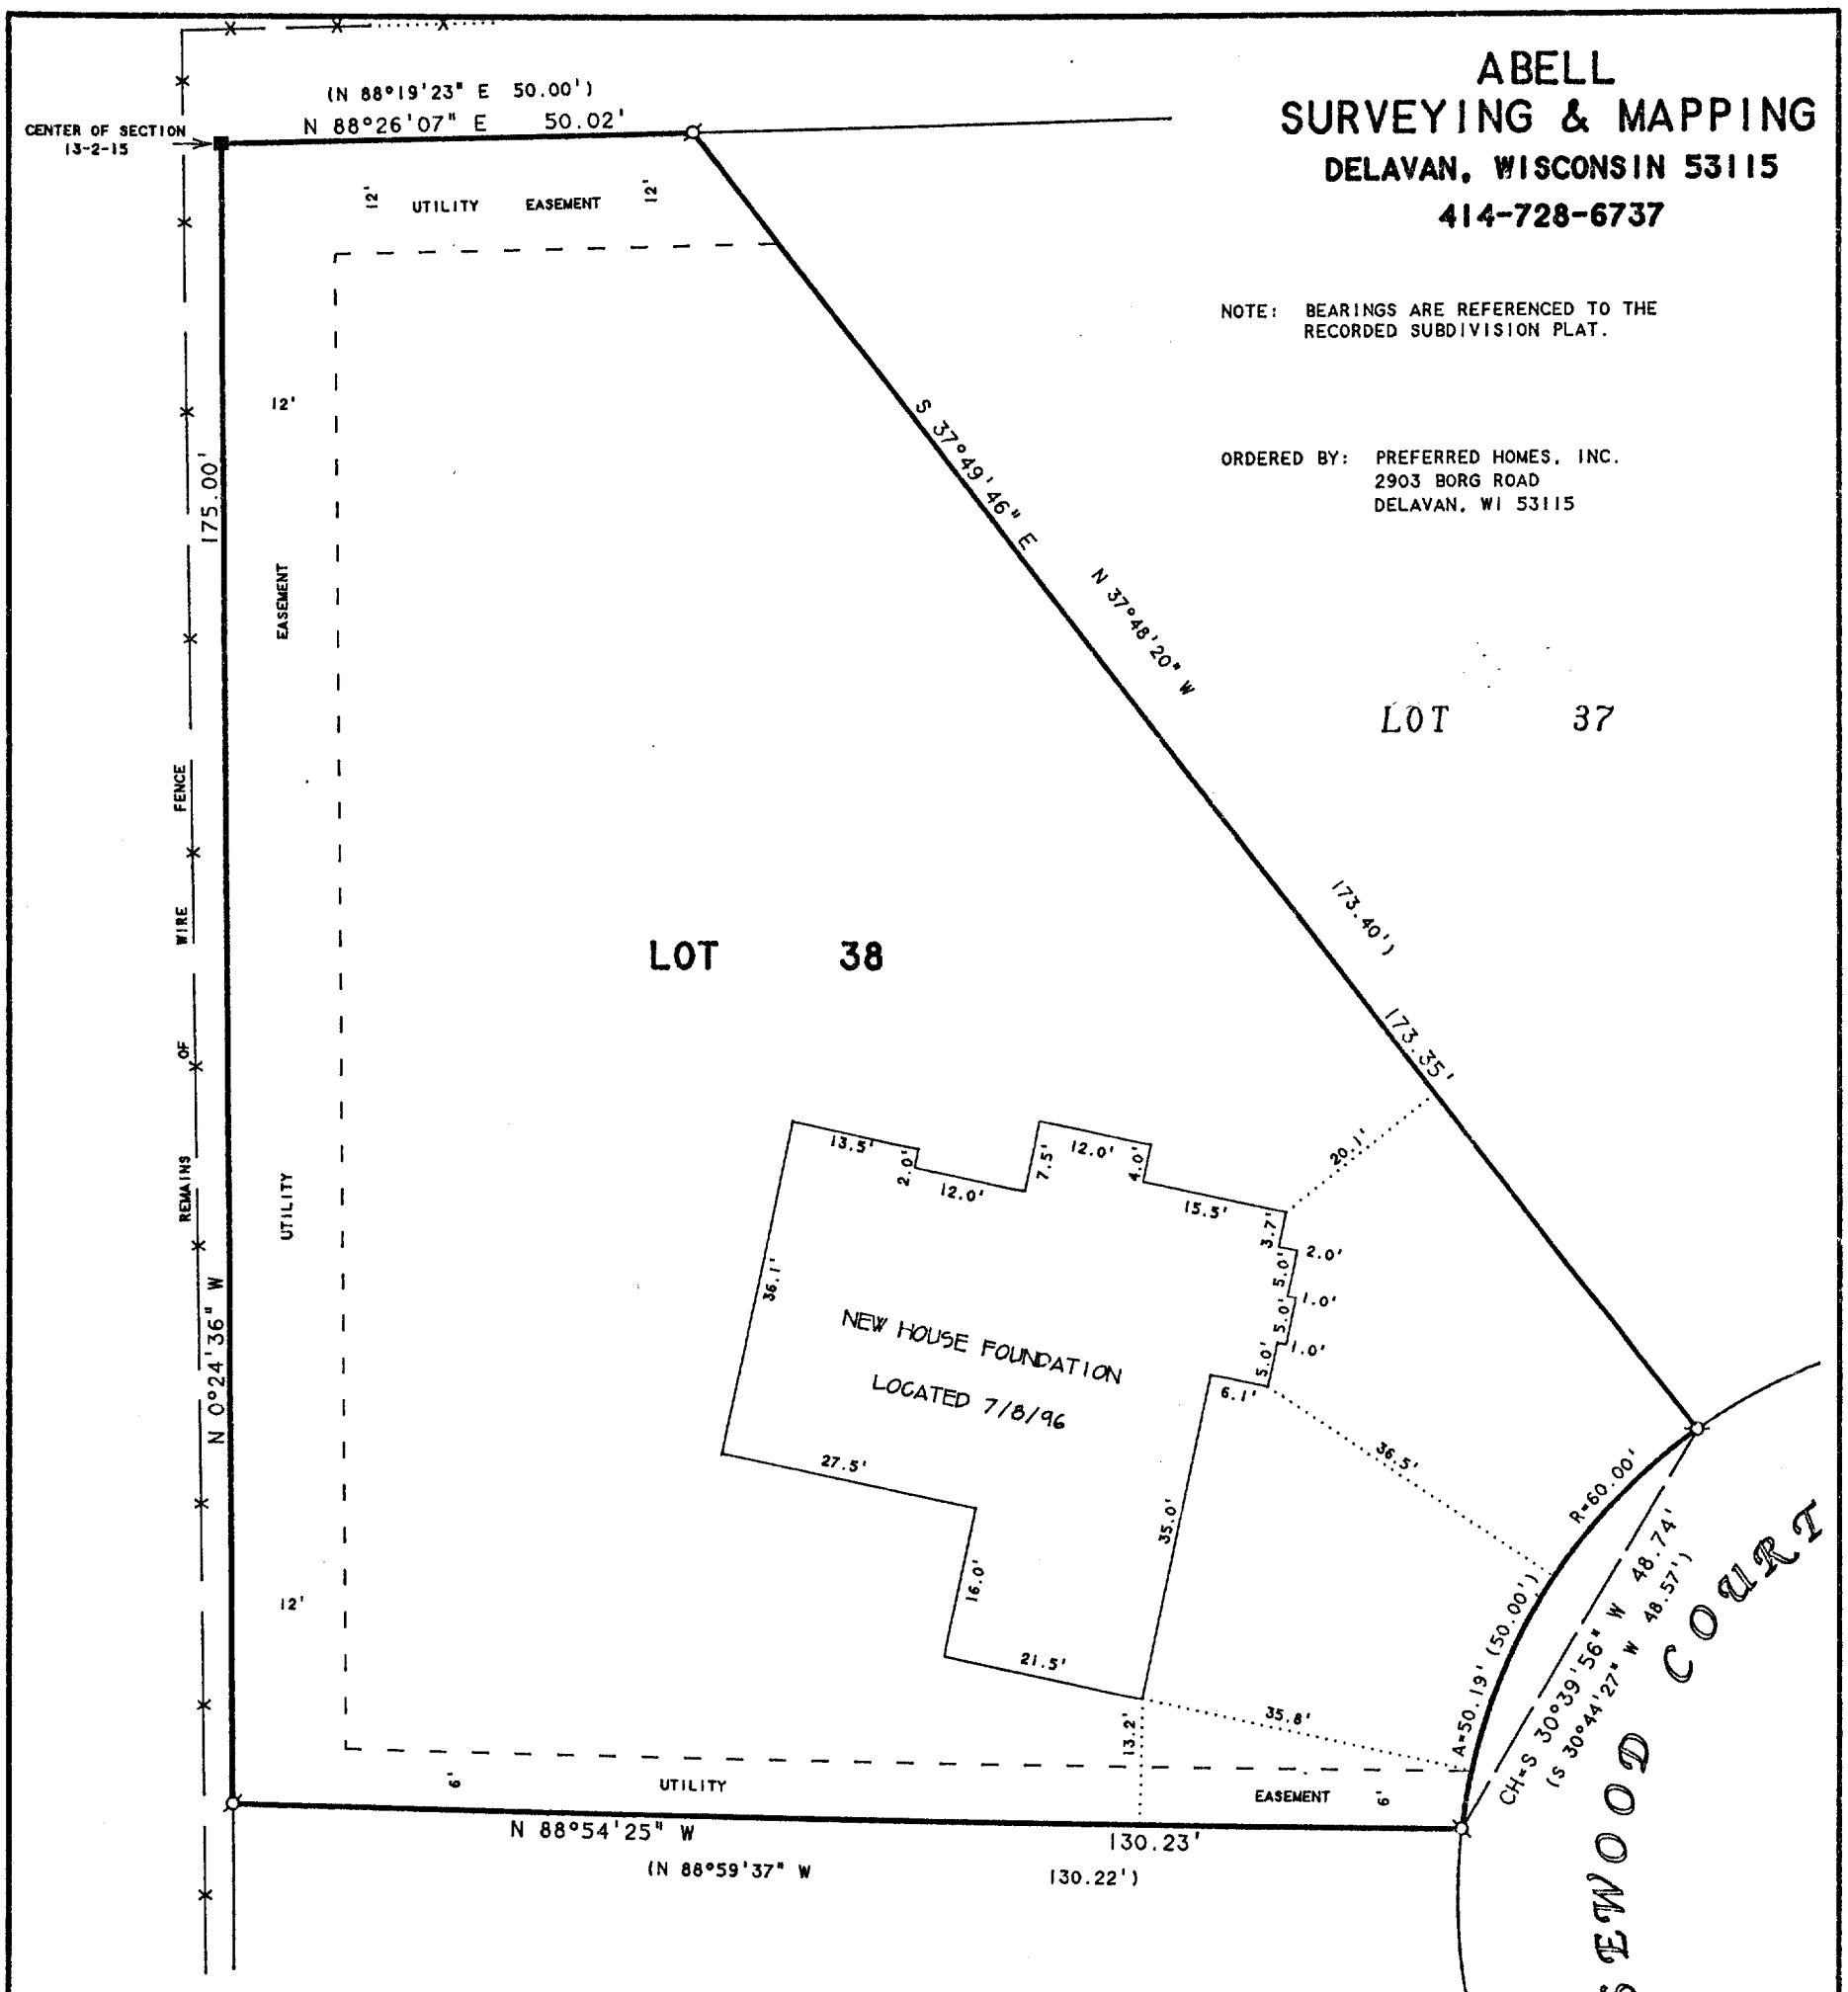


ABELL
SURVEYING & MAPPING

DELAVAN, WISCONSIN 53115

414-728-6737

NOTE: BEARINGS ARE REFERENCED TO THE RECORDED SUBDIVISION PLAT.

ORDERED BY: PREFERRED HOMES, INC.
2903 BORG ROAD
DELAVAN, WI 53115

PLAT OF SURVEY OF

LOT 38, WHISPERING PINES, LOCATED IN THE CITY OF DELAVAN, WALWORTH COUNTY, WISCONSIN.

RECEIVED
JUL 23 1996
dg

SCALE 1"=20'

LEGEND

- ∅ - IRON PIPE FOUND
- ■ - CONCRETE MONUMENT FOUND
- ×——× - WIRE FENCE
- ( ) - RECORDED AS

REVISED: JULY 8, 1996
TO SHOW LOCATION OF NEW HOUSE FOUNDATION.

I HEREBY CERTIFY THAT I HAVE SURVEYED THE ABOVE DESCRIBED PROPERTY AND THAT THE ABOVE MAP IS A TRUE REPRESENTATION THEREOF AND SHOWS THE SIZE AND LOCATION OF THE PROPERTY, ITS EXTERIOR BOUNDARIES, THE LOCATION OF ALL VISIBLE STRUCTURES AND DIMENSIONS OF ALL PRINCIPAL BUILDINGS THEREON, BOUNDARY FENCES, APPARENT EASEMENTS, ROADWAYS AND VISIBLE ENCROACHMENTS, IF ANY, TO THE BEST OF MY KNOWLEDGE AND BELIEF.

THIS SURVEY IS MADE FOR THE USE OF THE PRESENT OWNERS OF THE PROPERTY, AND ALSO THOSE WHO PURCHASE, MORTGAGE, OR GUARANTEE THE TITLE THERETO WITHIN ONE (1) YEAR FROM DATE HEREON.

David F. Abell

DAVID F. ABELL
WISCONSIN REGISTERED LAND SURVEYOR, S-1596


May 21, 1996

DATE JOB NUMBER - 96074

NOTE: THIS IS NOT A CERTIFIED COPY UNLESS SEALED.

XWP-38

002-1542

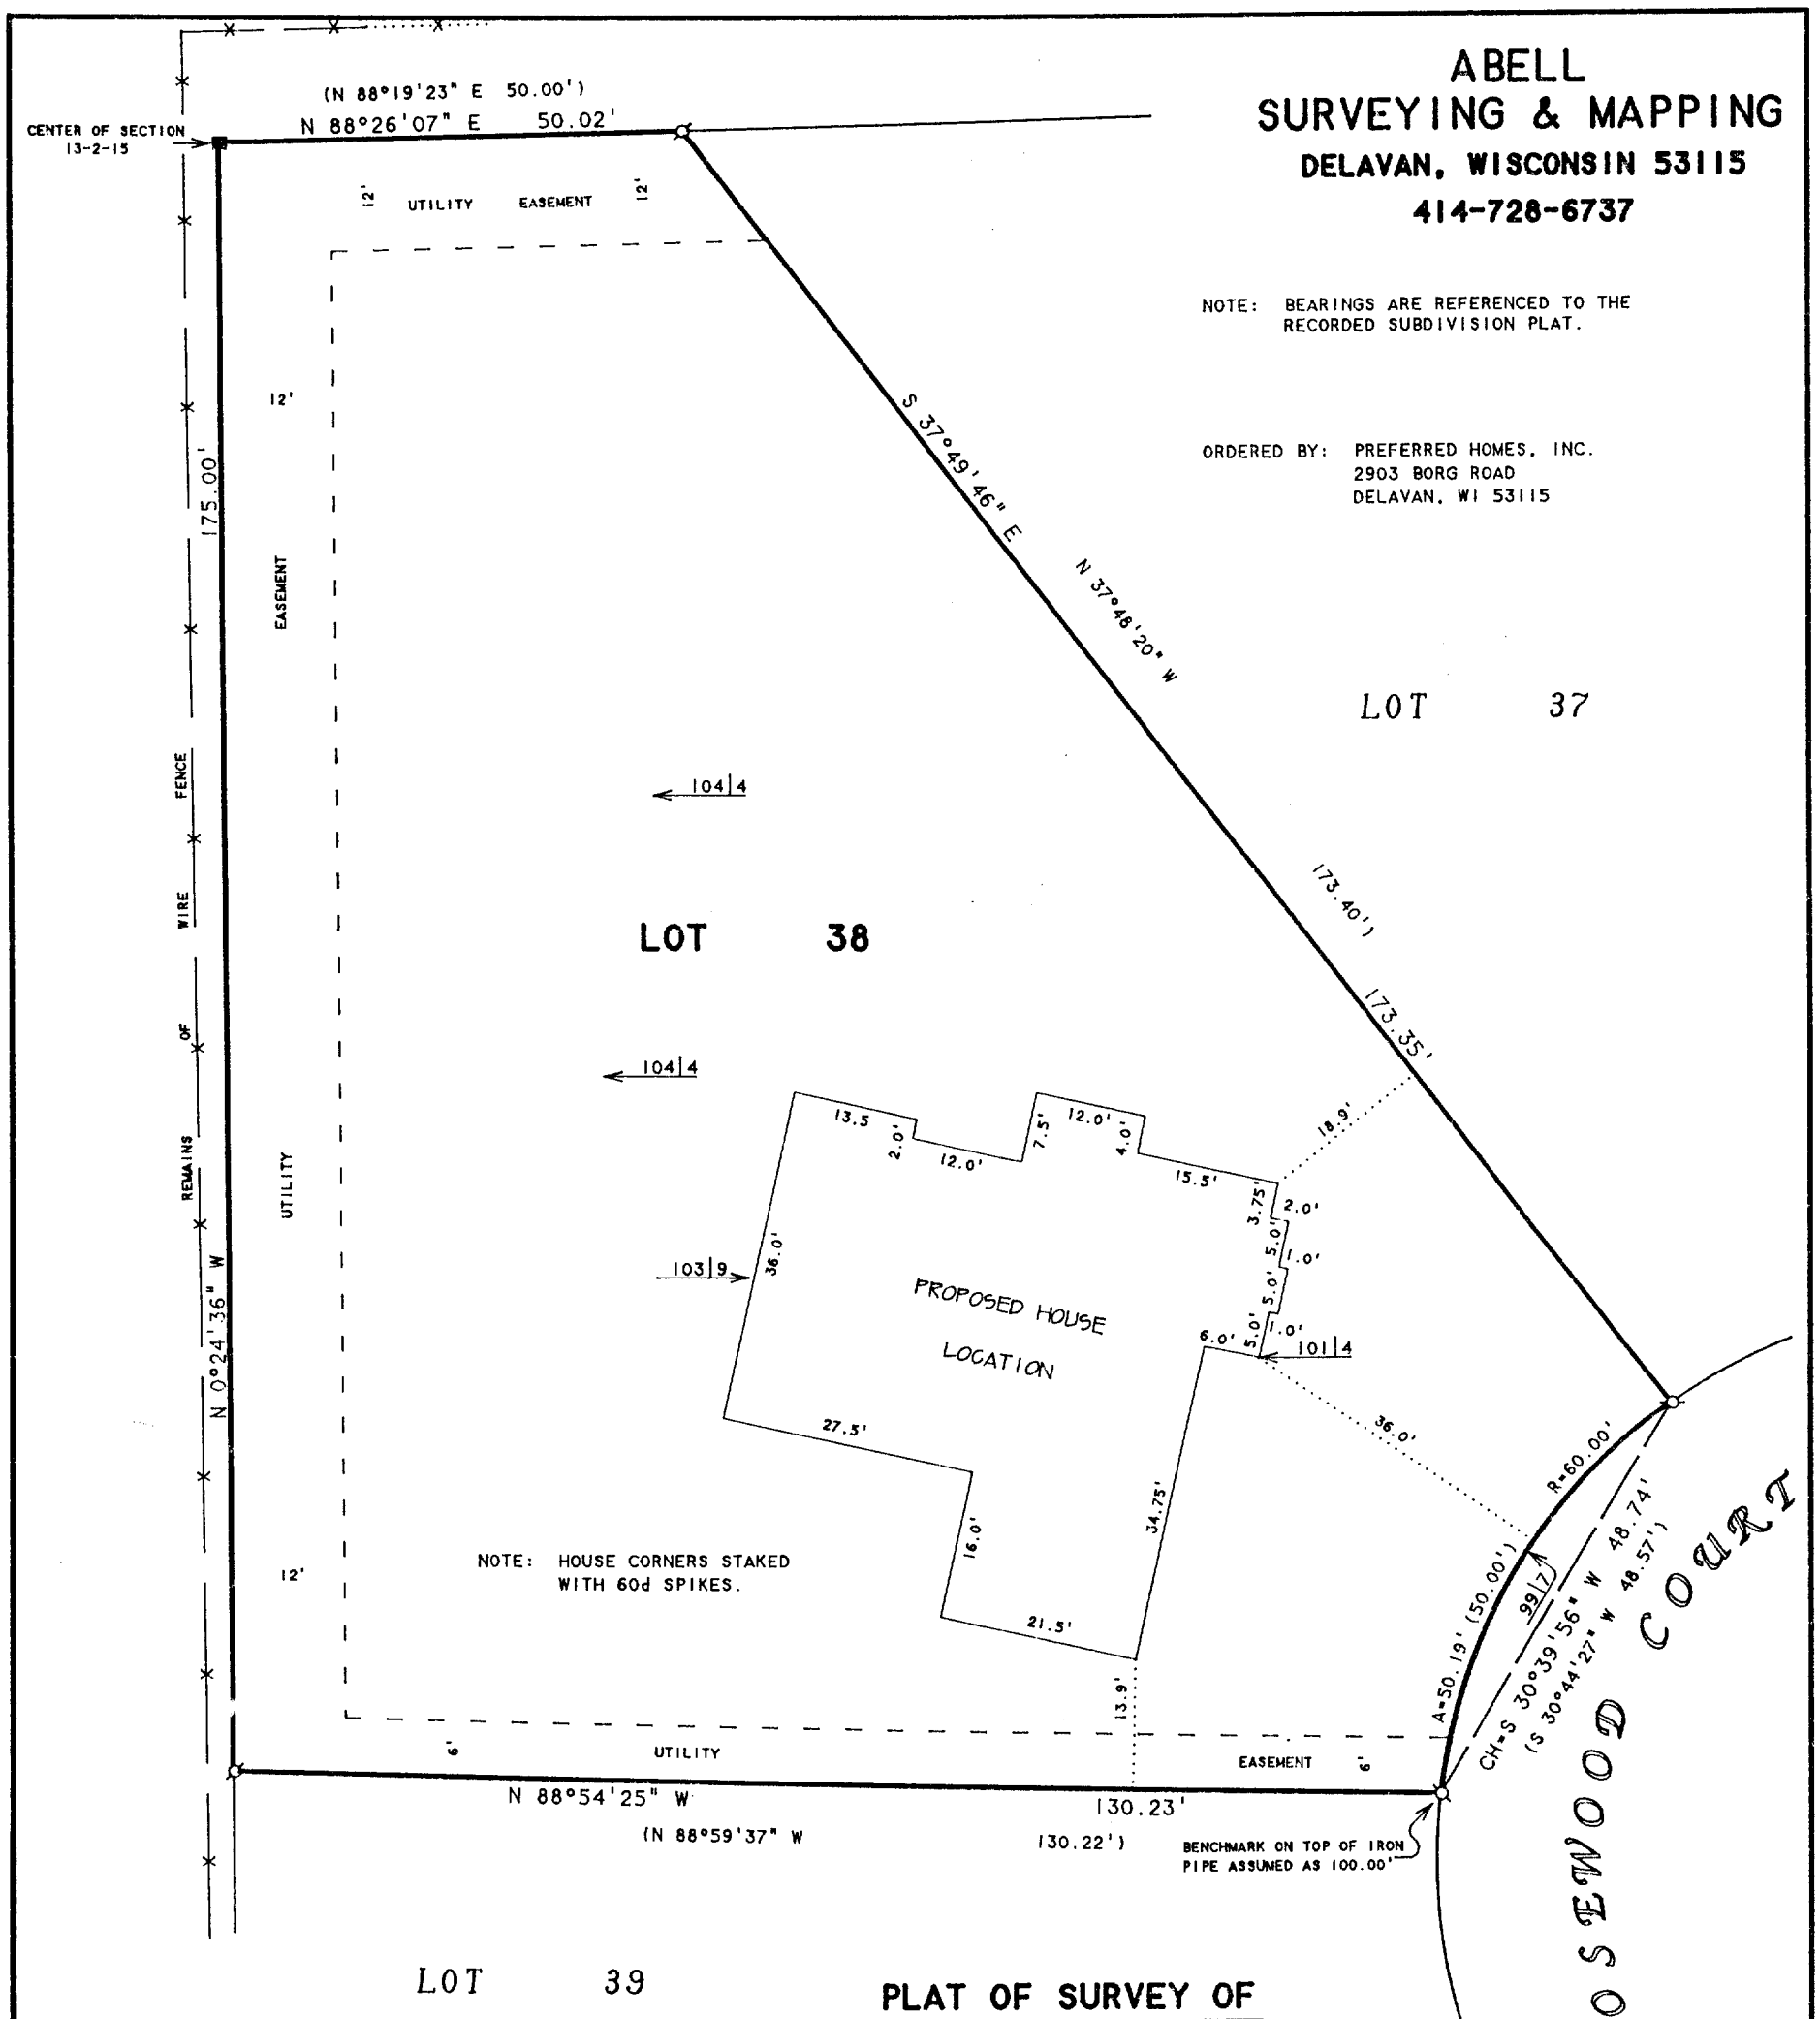

ABELL
SURVEYING & MAPPING

DELAVAN, WISCONSIN 53115

414-728-6737

NOTE: BEARINGS ARE REFERENCED TO THE RECORDED SUBDIVISION PLAT.

ORDERED BY: PREFERRED HOMES, INC.
2903 BORG ROAD
DELAVAN, WI 53115

PLAT OF SURVEY OF

LOT 38, WHISPERING PINES, LOCATED IN THE CITY OF DELAVAN, WALWORTH COUNTY, WISCONSIN.

RECEIVED
JUL 23 1996

N

SCALE 1"=20'

LEGEND

- ø - IRON PIPE FOUND
- ■ - CONCRETE MONUMENT FOUND
- *——* - WIRE FENCE
- 000|0 -SPOT GROUND ELEVATION
- ( )- RECORDED AS

I HEREBY CERTIFY THAT I HAVE SURVEYED THE ABOVE DESCRIBED PROPERTY AND THAT THE ABOVE MAP IS A TRUE REPRESENTATION THEREOF AND SHOWS THE SIZE AND LOCATION OF THE PROPERTY, ITS EXTERIOR BOUNDARIES, THE LOCATION OF ALL VISIBLE STRUCTURES AND DIMENSIONS OF ALL PRINCIPAL BUILDINGS THEREON, BOUNDARY FENCES, APPARENT EASEMENTS, ROADWAYS AND VISIBLE ENCROACHMENTS, IF ANY, TO THE BEST OF MY KNOWLEDGE AND BELIEF.

THIS SURVEY IS MADE FOR THE USE OF THE PRESENT OWNERS OF THE PROPERTY, AND ALSO THOSE WHO PURCHASE, MORTGAGE, OR GUARANTEE THE TITLE THERETO WITHIN ONE (1) YEAR FROM DATE HEREON.

David F. Abell

DAVID F. ABELL
WISCONSIN REGISTERED LAND SURVEYOR, S-1596

May 21, 1996

DATE JOB NUMBER - 96074

NOTE: THIS IS NOT A CERTIFIED COPY UNLESS SEALED.

XWP-38

002-1542