FARRIS, HANSEN & ASSOCIATES, INC.

ENGINEERING, ARCHITECTURE, SURVEYING

7 RIDGWAY COURT - P.O.BOX 437, ELKHORN, WISCONSIN 53121

PHONE: (414) 723-2098 FAX: (414) 723-5886

PLAT OF SURVEY


LOT 21 BLOCK 3

CHESTNIT RIDGE SUBDIVISION WEST

LOCATED IN EAST 1/2 OF THE SW 1/4 OF SEC. 13

TOWN 2 NORTH, RANGE 15 EAST, CITY OF DELAVAN

WALWORTH COUNTY, WISCONSIN

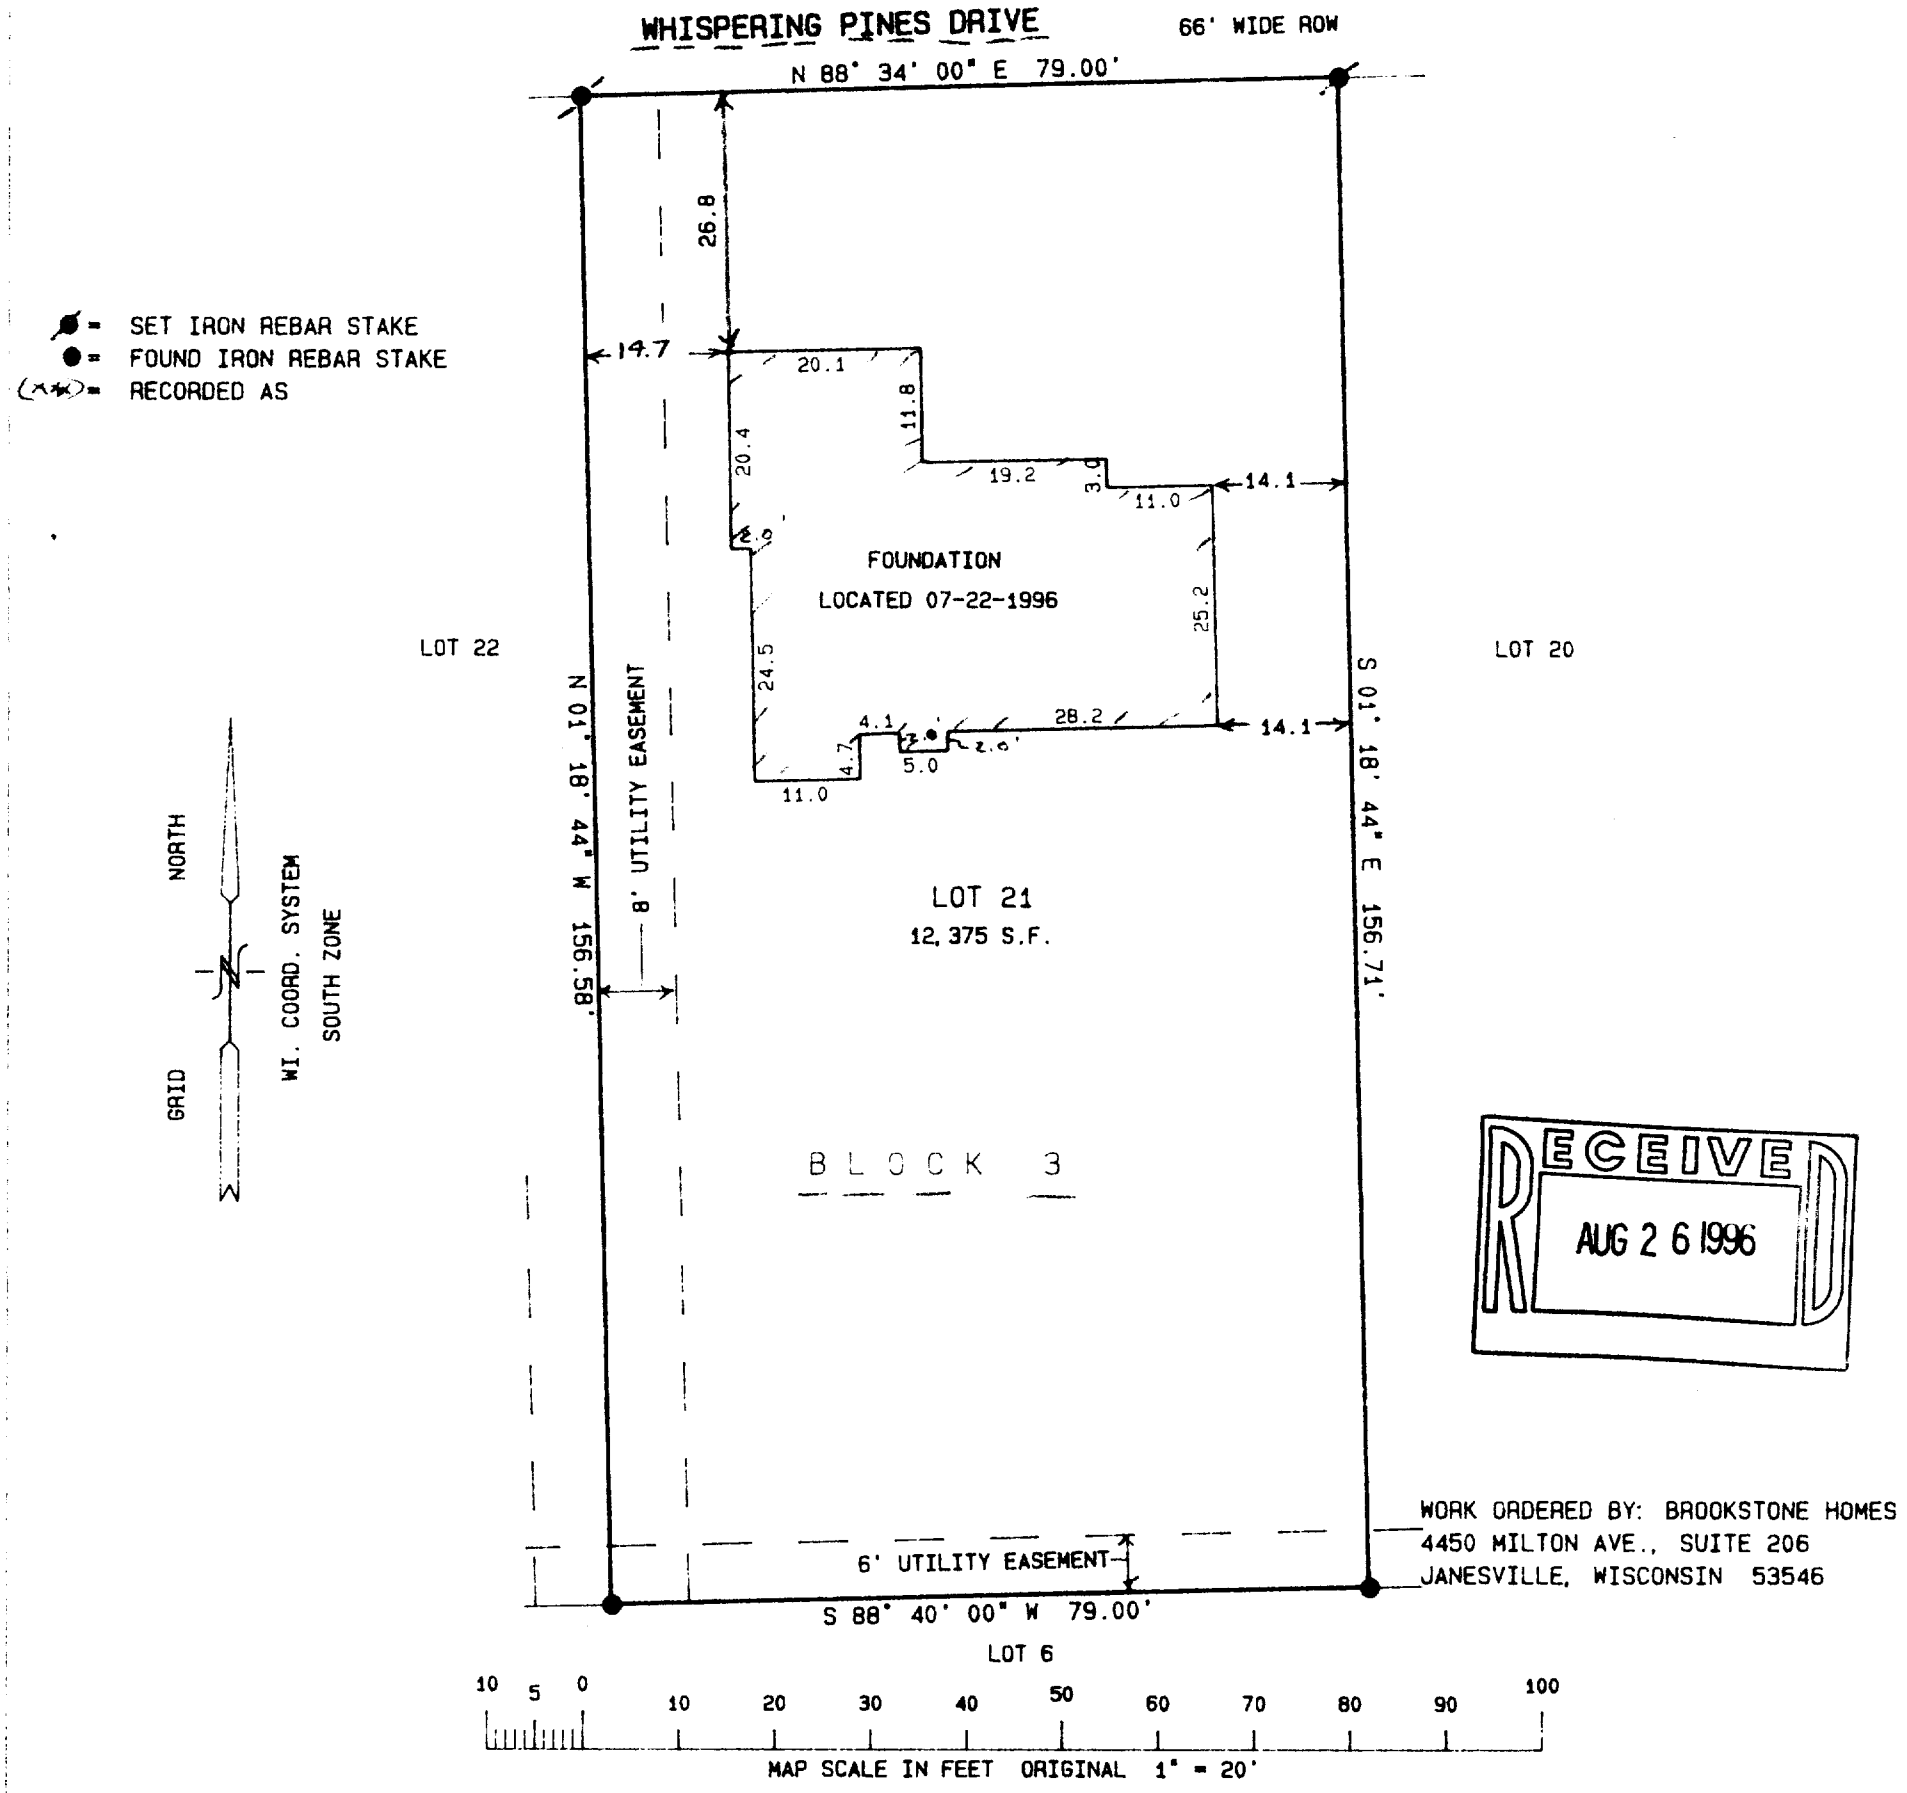

RECEIVED
AUG 2 6 1996

WORK ORDERED BY: BROOKSTONE HOMES
4450 MILTON AVE., SUITE 206
JANESVILLE, WISCONSIN 53546

NOTE: COPIES OF THIS MAP TO WHICH THE FOLLOWING CERTIFICATE WILL APPLY ARE BLUE LINE PRINTS SHOWING SURVEYOR'S ORIGINAL SEAL AND SIGNATURE IN BLACK INK. COPIES BY ANY OTHER MEANS MAY HAVE ALTERATIONS WHICH DO NOT REPRESENT THE SURVEYOR'S WORK PRODUCT.

I HEREBY CERTIFY THAT THE ABOVE DESCRIBED PROPERTY HAS BEEN SURVEYED UNDER MY DIRECTION AND THAT THE ABOVE MAP IS A TRUE REPRESENTATION THEREOF AND SHOWS THE SIZE AND LOCATION OF THE PROPERTY AND ITS EXTERIOR BOUNDARIES. THIS SURVEY IS MADE FOR THE USE OF THE PRESENT OWNERS OF THE PROPERTY, AND ALSO THOSE WHO PURCHASE, MORTGAGE, OR GUARANTEE THE TITLE THERETO WITHIN ONE YEAR FROM THE DATE HEREOF.

DATED: 7-25-1996

PETER S. GORDON R.L.S. 2101

WISCONSIN
PETER S. GORDON
S-2101
ELKHORN, WI
LAND SURVEYOR

PROJ 3690.21.3

XCRW-30

002-1546