


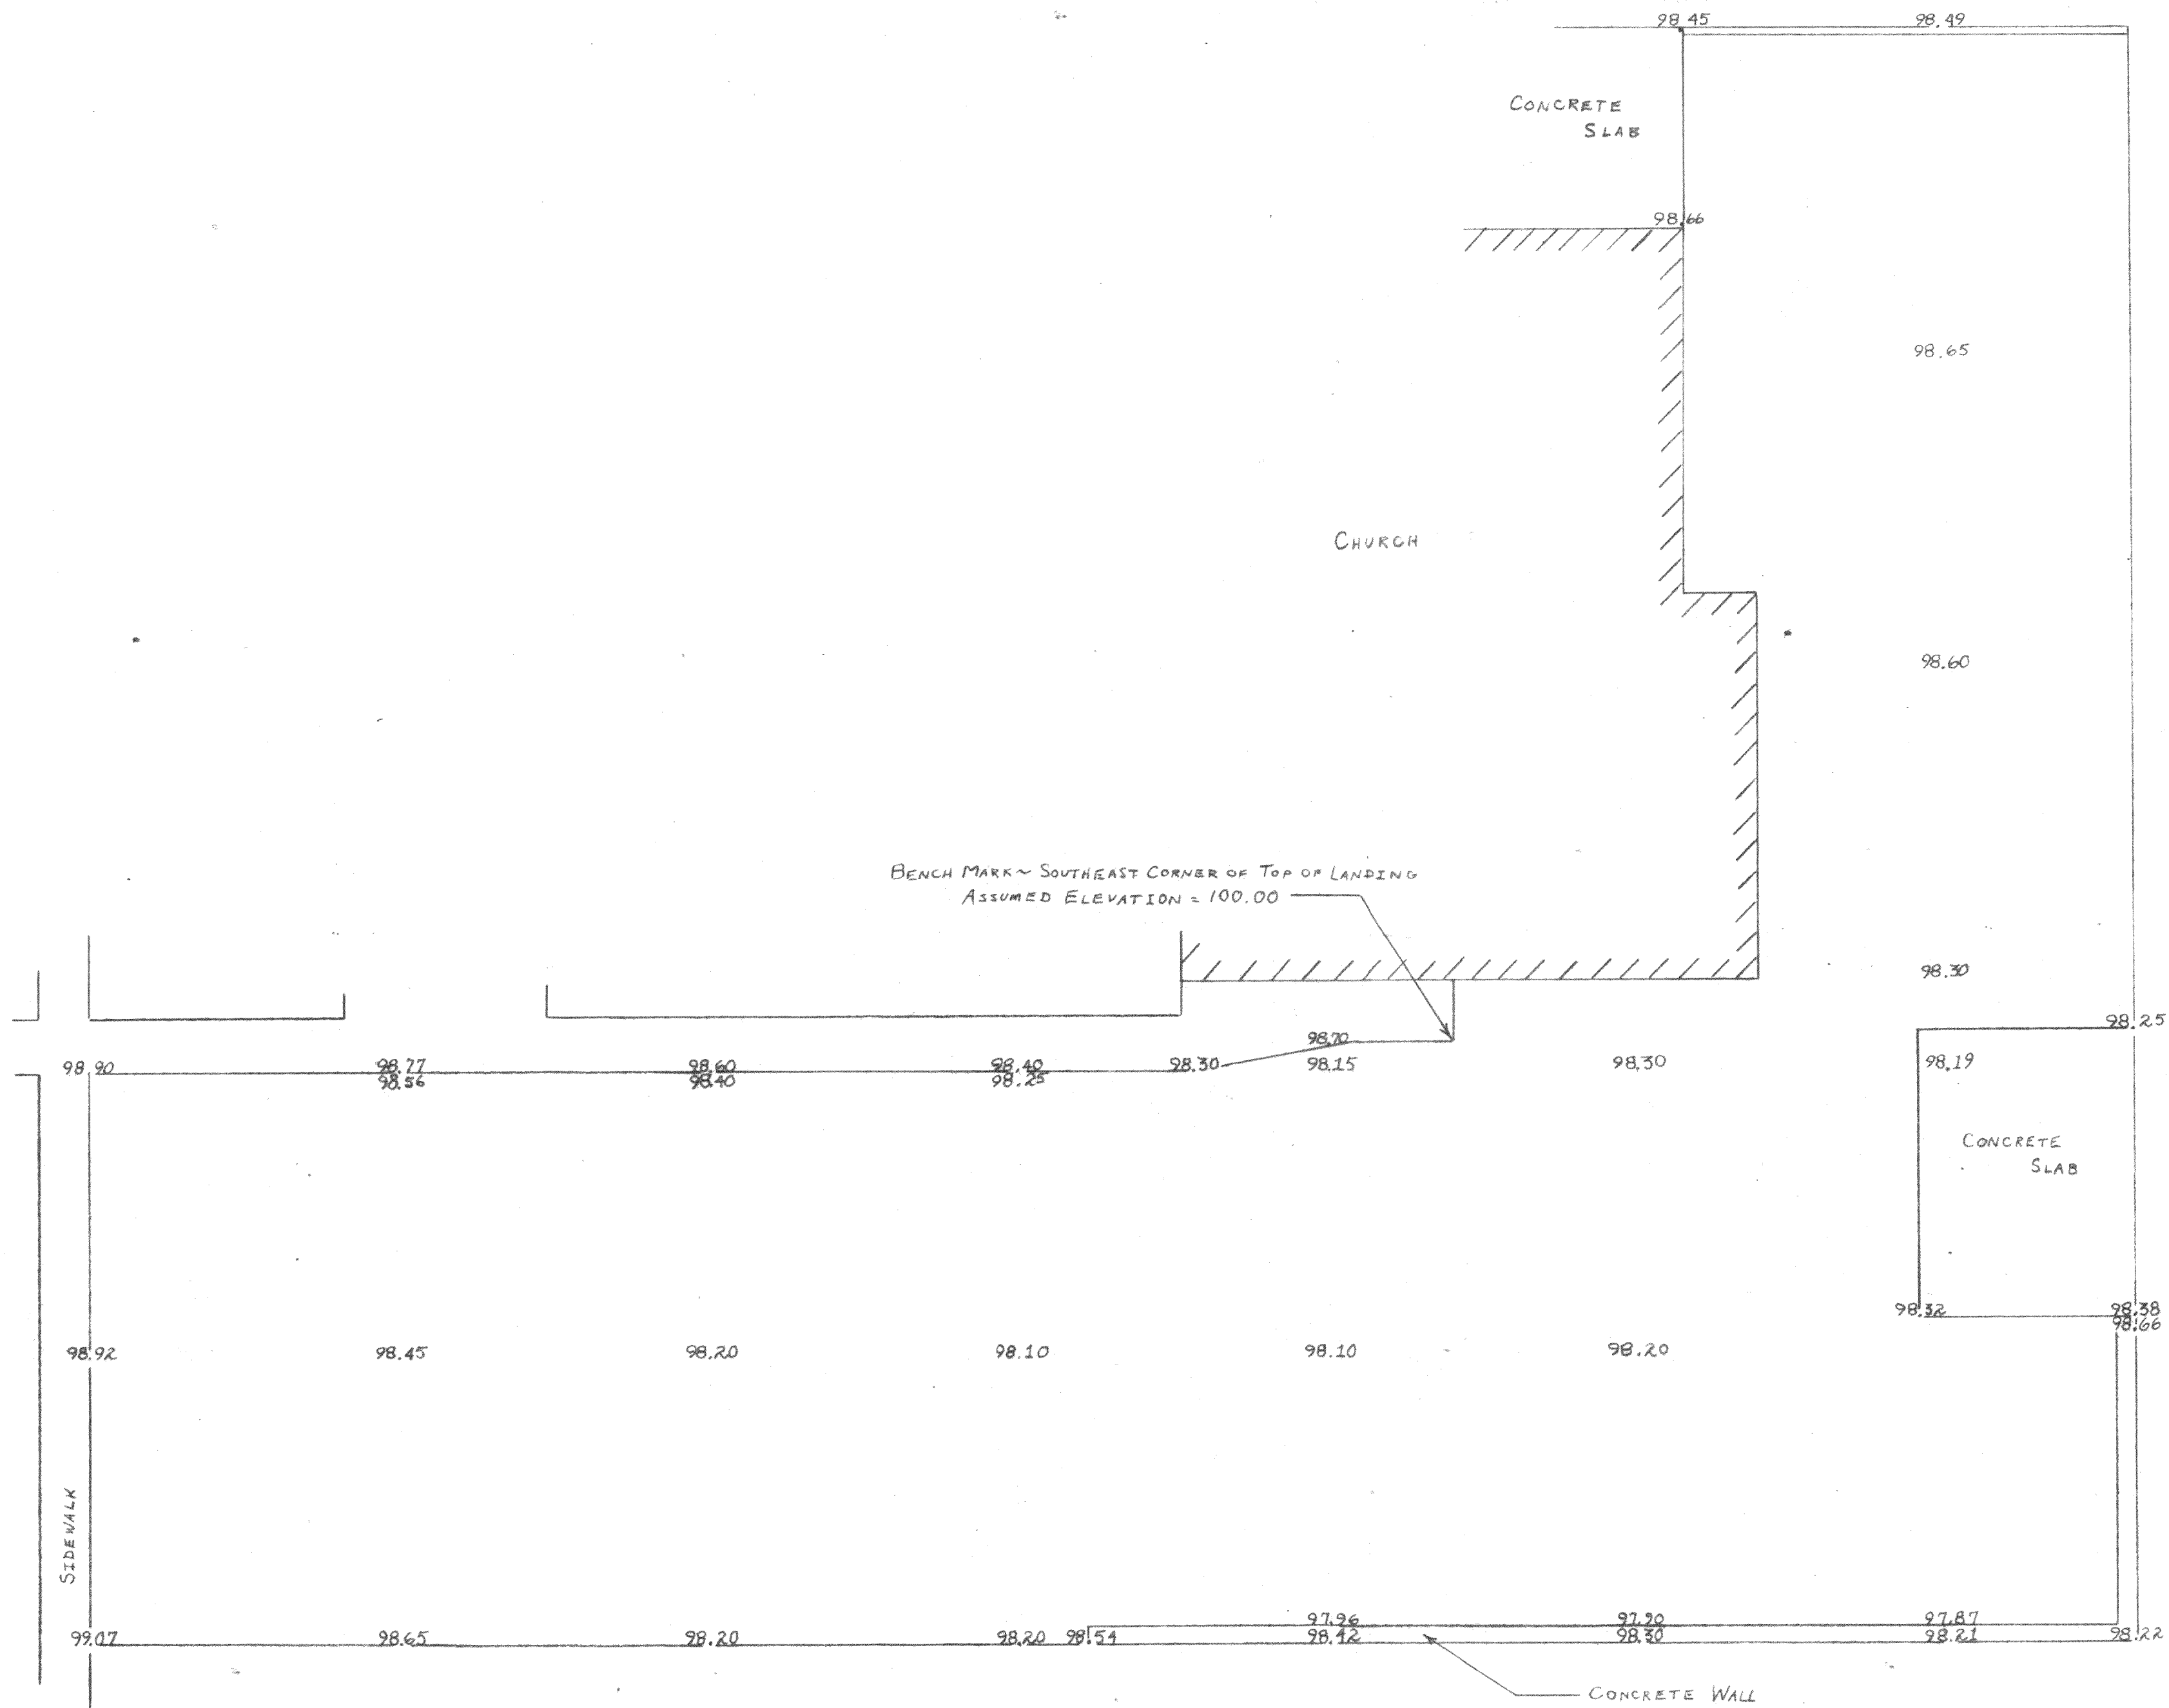

SCALE ~ 1" = 10'