
PLAT OF SURVEY

PATHFINDER SURVEYING
FORMERLY KOLB LAND CONSULTING
929 WILLIAMS STREET LAKE GENEVA, WI. 53147
(414) 248-3697

ORDERED BY: CENTURY 21 ZENK REALTY
804 N. WISCONSIN ST.
ELKHORN, WI 53121

DATE: 2/9/1999

DESCRIPTION: LOT 26 IN WHISPERING PINES, A SUBDIVISON LOCATED IN THE CITY OF DELAVAN, WALWORTH COUNTY, WISCONSIN.

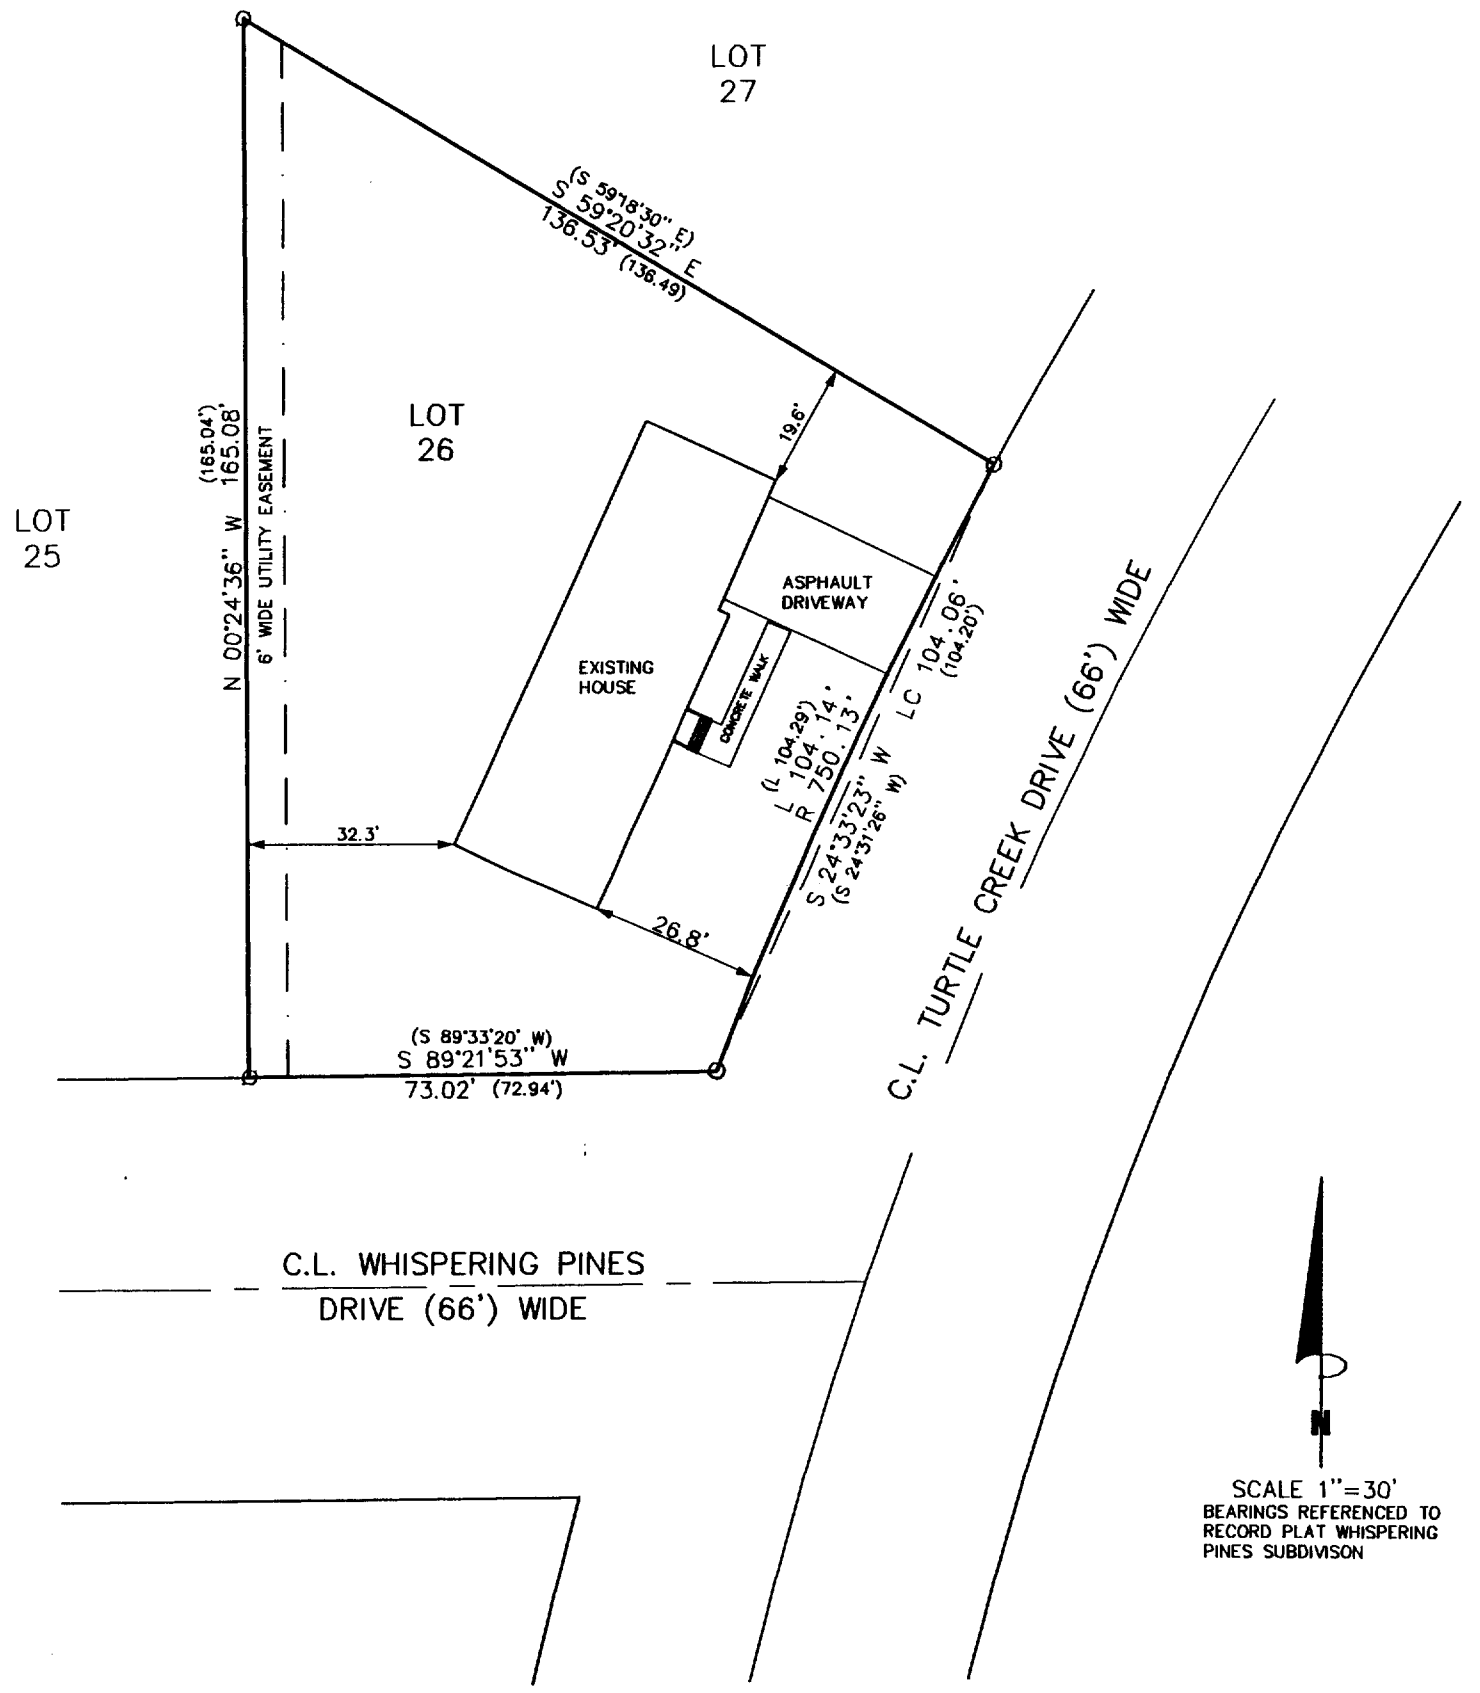

SCALE 1"=30'
BEARINGS REFERENCED TO RECORD PLAT WHISPERING PINES SUBDIVISON

LEGEND

⊙ FOUND 2 IN. DIA. IRON PIPE

⊙ FOUND 1 IN. DIA. IRON PIPE

(XXXX) RECORDED AS

THE ABOVE MAP IS A TRUE REPRESENTATION THEREOF AND SHOWS THE SIZE AND LOCATION OF ALL THE PROPERTY, EXTERIOR BOUNDARIES, THE LOCATION OF ALL VISIBLE BOUNDARY FENCES , APPARENT EASEMENTS , ROADWAYS AND VISIBLE ENCROACHMENTS , IF ANY

THIS SURVEY IS MADE FOR THE USE OF THE PRESENT OWNERS OF THE PROPERTY , AND ALSO THOSE WHO PURCHASE , MORTGAGE OR GURANTEE TITLE THERETO WITHIN ONE (1) YEAR FROM DATE HERETO.

John P Krott

JOHN P. KROTT , R.L.S. 2258

RECEIVED
MAR [illegible] 1999

WISCONSIN
JOHN P. KROTT
S-2258
MUKWONAGO, WIS.
LAND SURVEYOR

NOTE: THIS IS NOT A CERTIFIED COPY UNLESS SEAL IS IN RED.

JOB NUMBER 99019 XWP00026

XWP-26 002-1763